



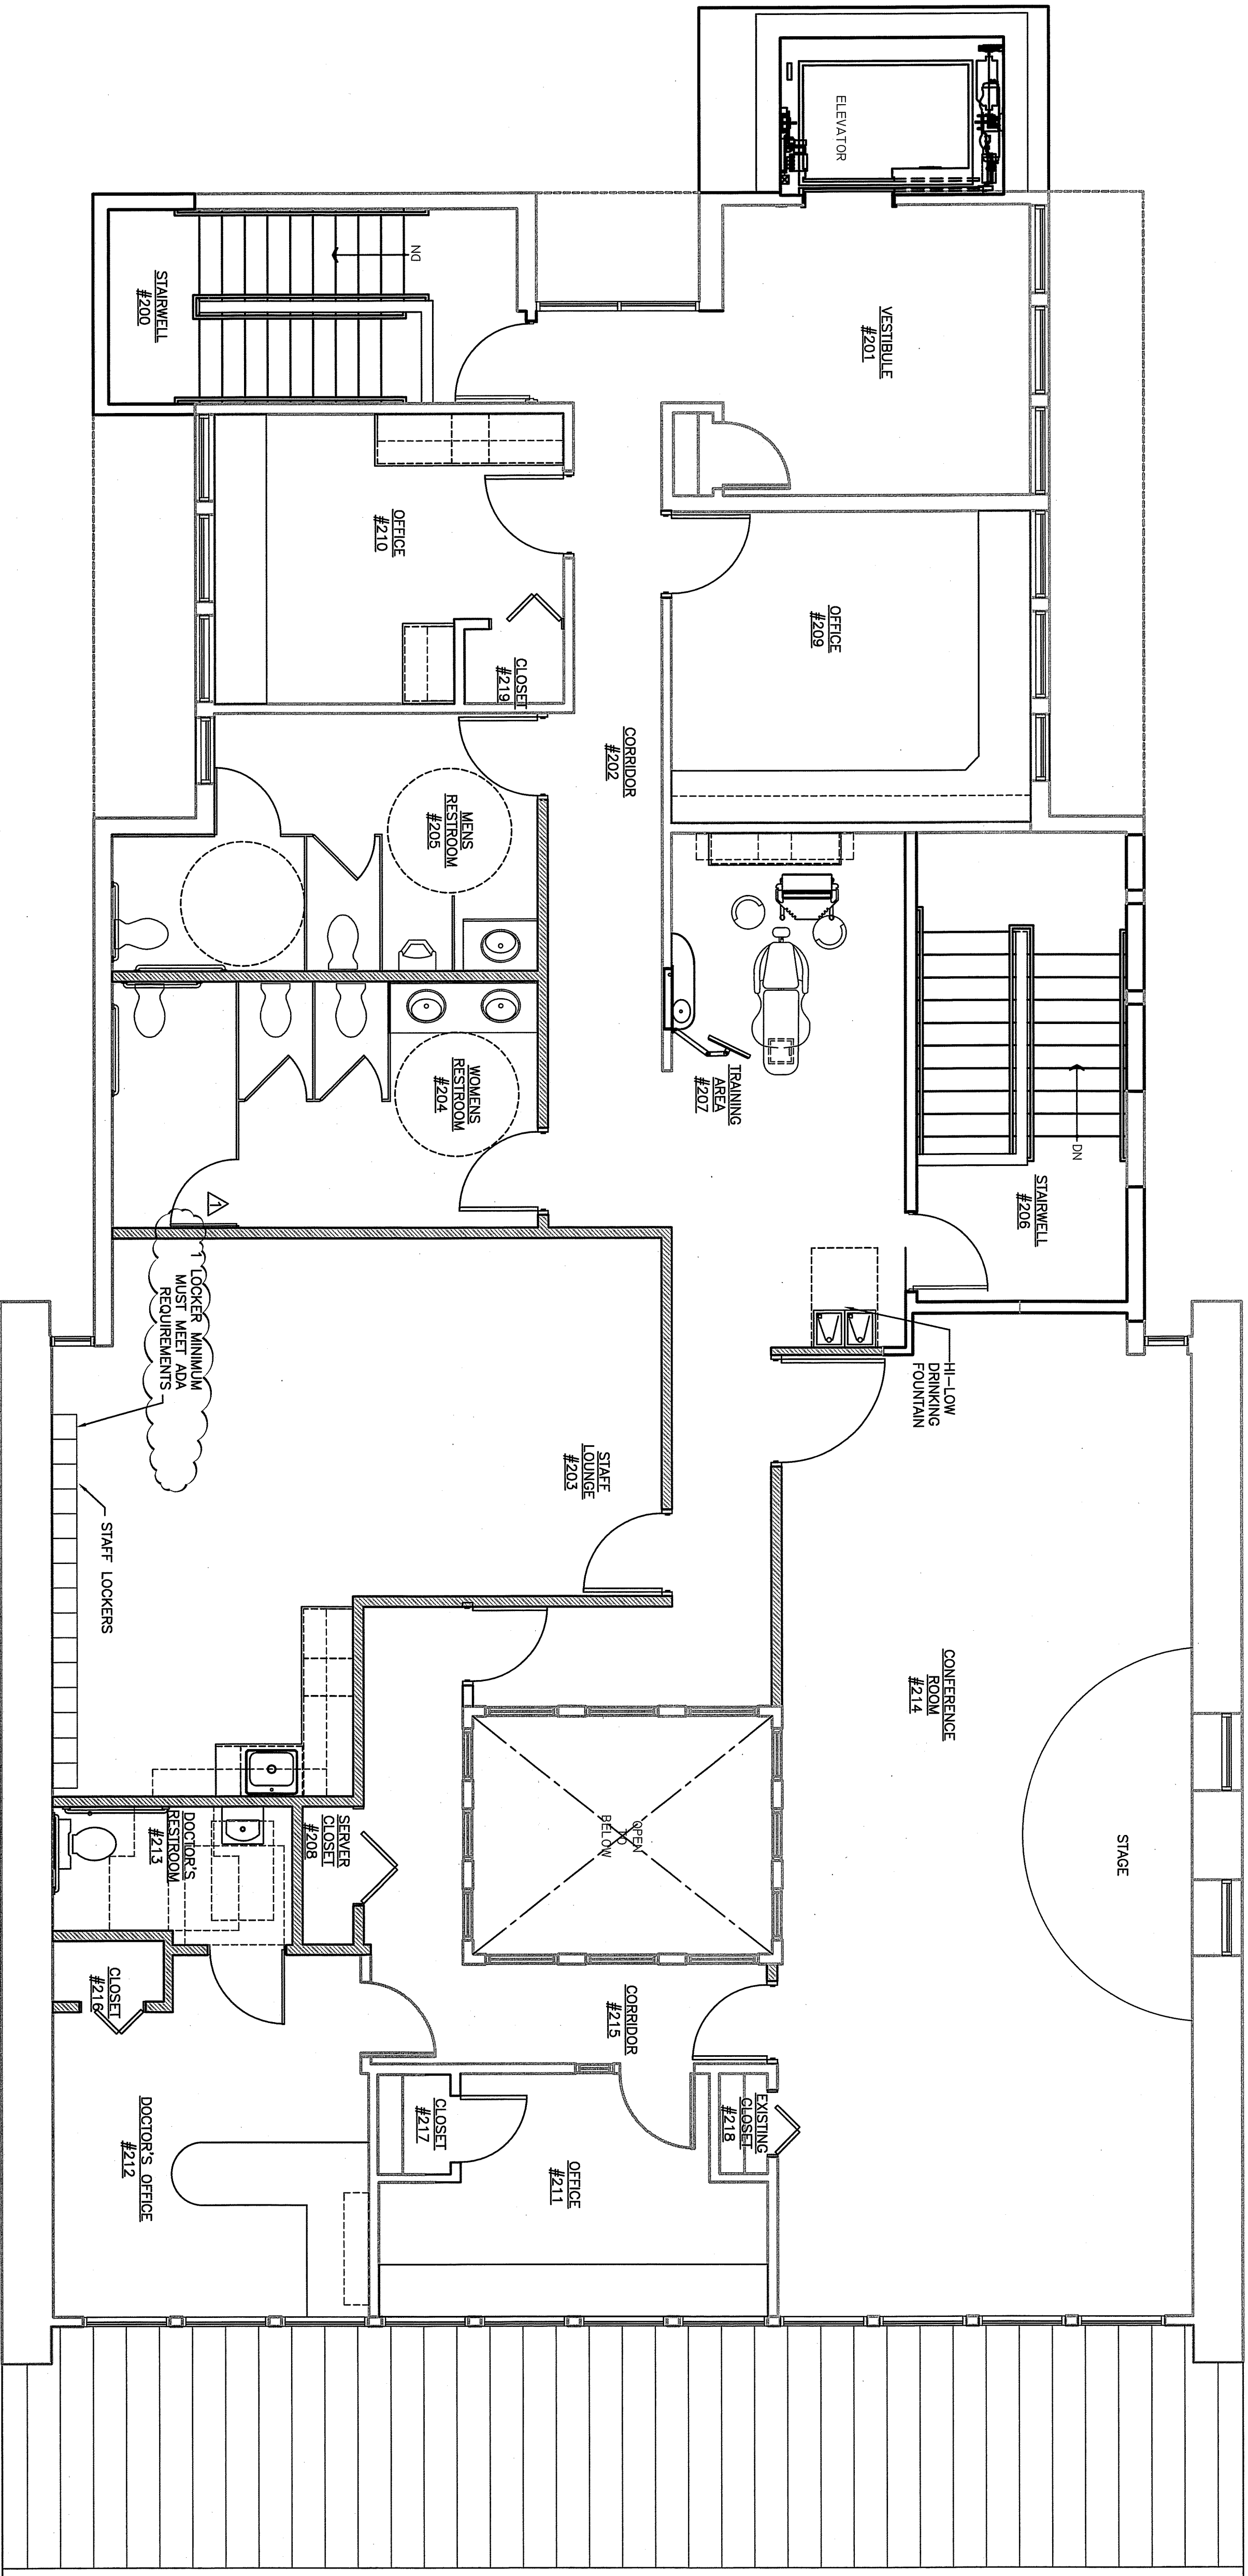

SECOND FLOOR PLAN
SCALE 1/4" = 1'-0"

APPROVED
JAN 10 2015
CODEMASTER

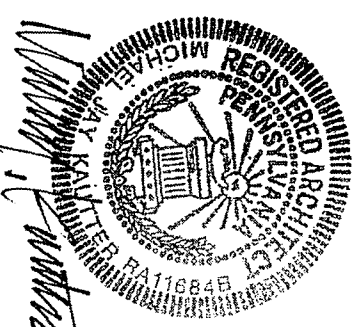

Proposed Dental Office for
GROVE DENTAL GROUP

Wyomissing, PA

D/E
DESIGN
ERGONOMICS
PO BOX 3530
757 Main Road
Suite One
Westport, MA 02790

A	11/25/14	PER REVIEW COMMENTS
A		
A		
A		
A		

PROJECT NUMBER: GROVE-13
DESIGNED BY: RAC
CHECKED BY: RAC
ISSUED FOR: PERMIT




DESIGN
ERGONOMICS

PO Box 3830
757 Main Road
Suite One
Westport, MA 02790

11/25/14	PER REVIEW COMMENTS

Proposed Dental Office for GROVE DENTAL GROUP

Wyomissing, PA

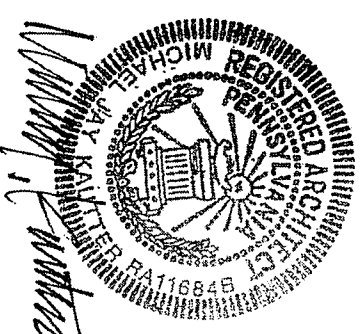


APPROVED
JAN 10 2015

CODENMASTER

SECOND FLOOR PLAN

SCALE 1/4" = 1'-0"

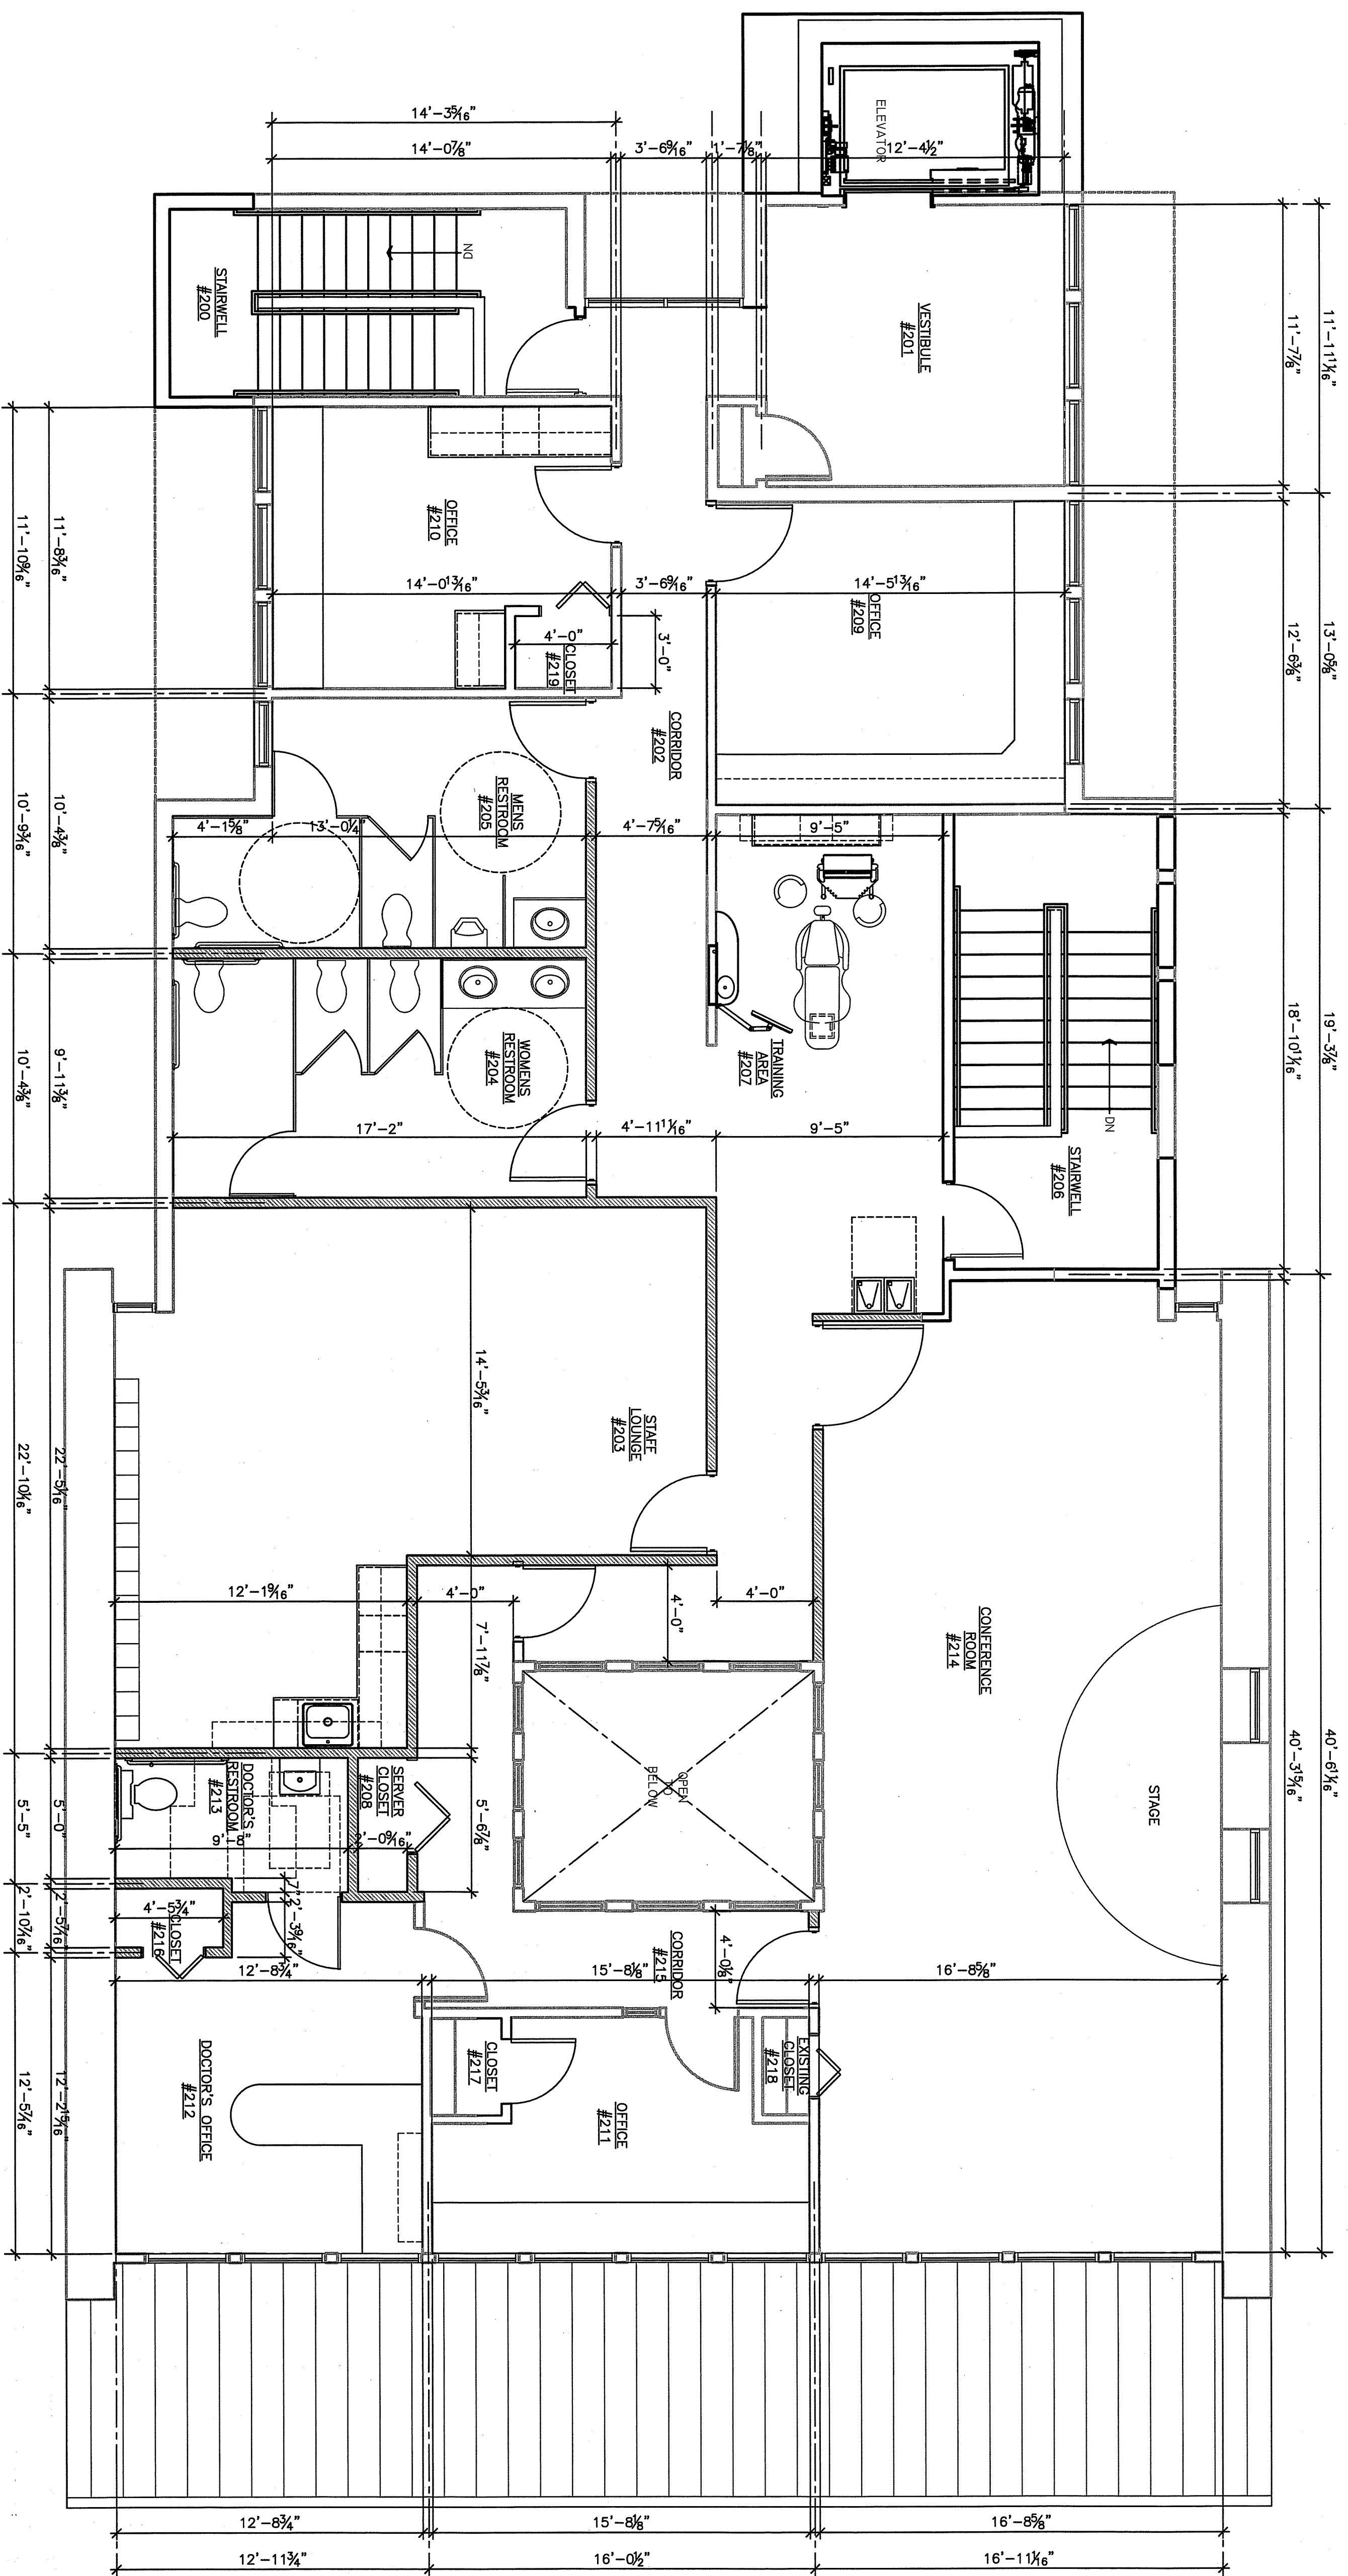

PROJECT NUMBER: GROVE-13
ISSUED BY: JAC
CHECKED BY: JAC
ISSUED FOR: PERMIT

SECOND FLOOR PLAN