


SUFFOLK STREET

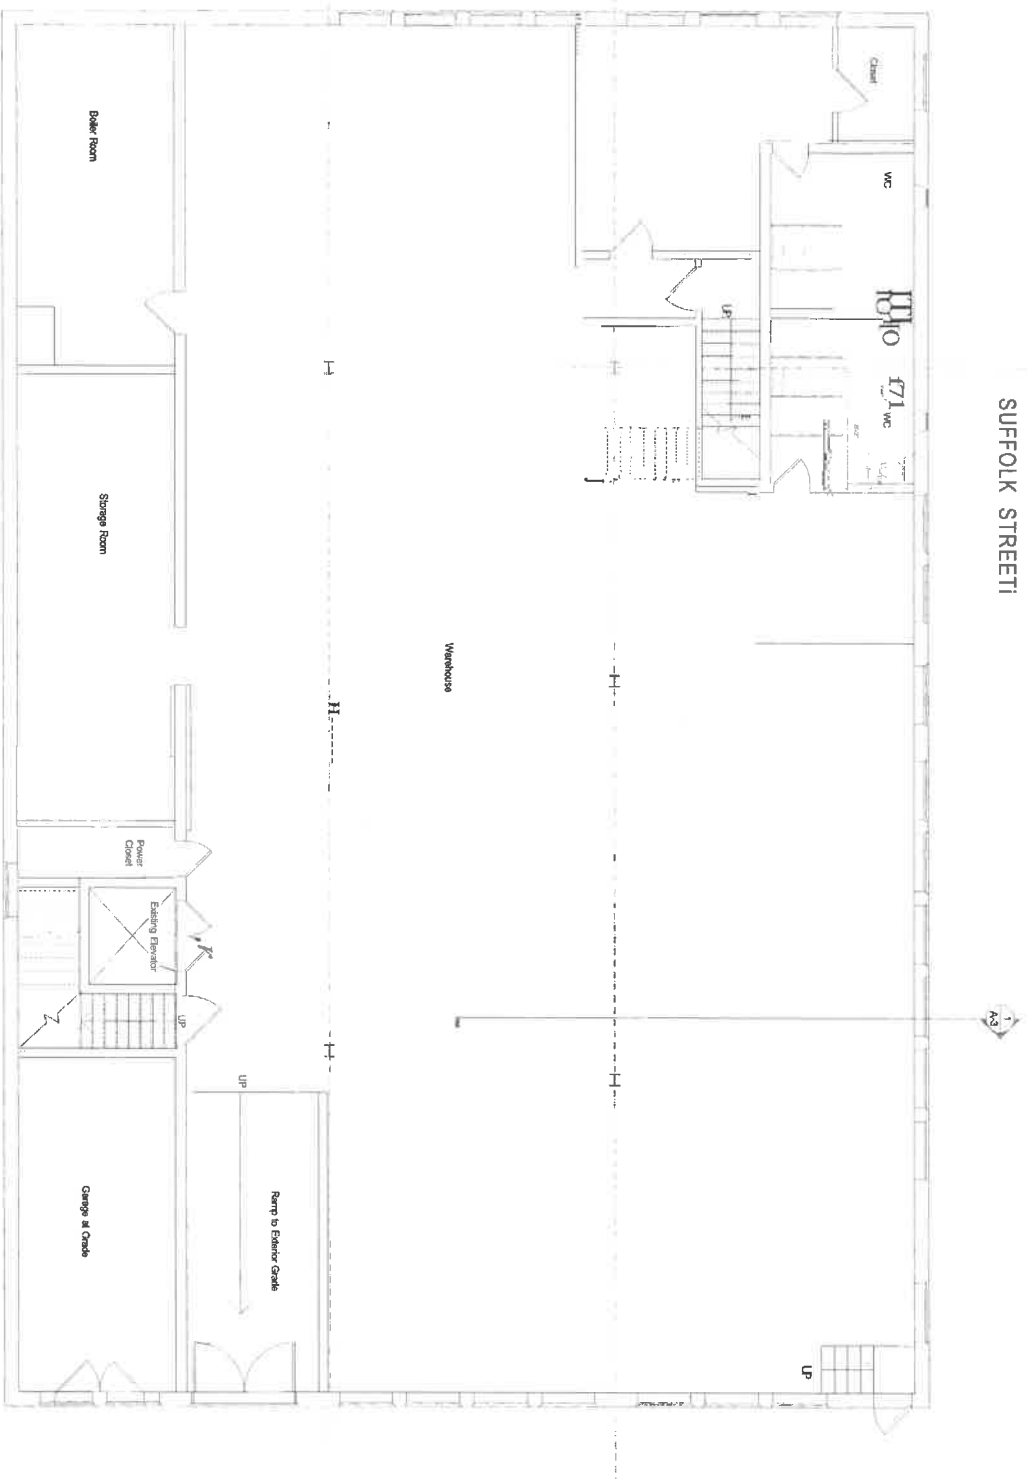

1
2
Level One Plan
(Gf---S-ca]_e-1/4" + 1'-0-

BRYAN DE VRIESE
ARCHITECT
ERICA GEES AIA
2000
Suffolk Street
Stoughton, MA 01970
Phone/Fax (413) 625-8988


Date: November 20, 2000
Scale: as noted
Drawn by: ERL
Reviewed by: ERL

Title:
Floor Plan Level One
AS-BUILT

STIEBEL PROPERTIES
Renovations and
Improvements
to the
UNITY PRESS BUILDING
Suffolk Street
Holyoke, MA

Sheet No.
A-1

SUFFOLK STREET

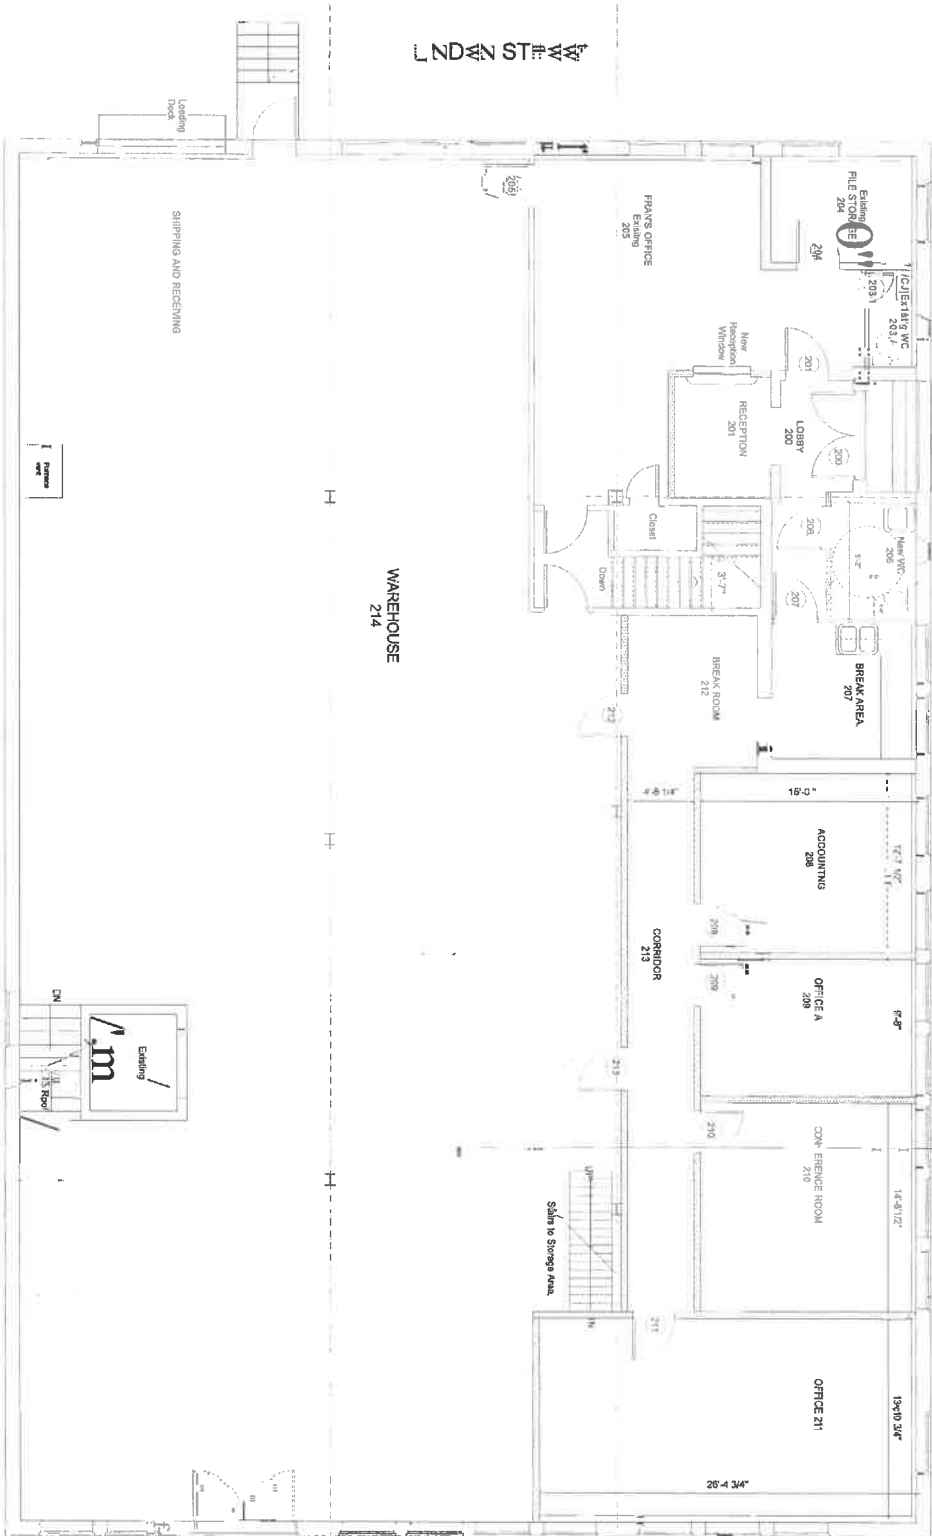

1 Level Two Plan
Scale = 1/4" = 10'

BRIAN DE VRIESE
ARCHITECT
ERICA GEES AIA
12 Main Street P.O. Box 445
Salem, MA 01970
Phone/Fax (413) 875-6888

Date: November 20, 2000
Scale: as noted
Drawn: E.G.
Reviewed:

Title:
Floor Plan/Second Level
AS-BUILT

STIEBEL PROPERTIES
Renovations and
Improvements
to the
UNITY PRESS BUILDING
Suffolk Street
Holyoke, MA

Sheet No.

A-2