


(APPROXIMATELY 12,000 S.F.)

5221 AS-BUILT PLAN & SITE

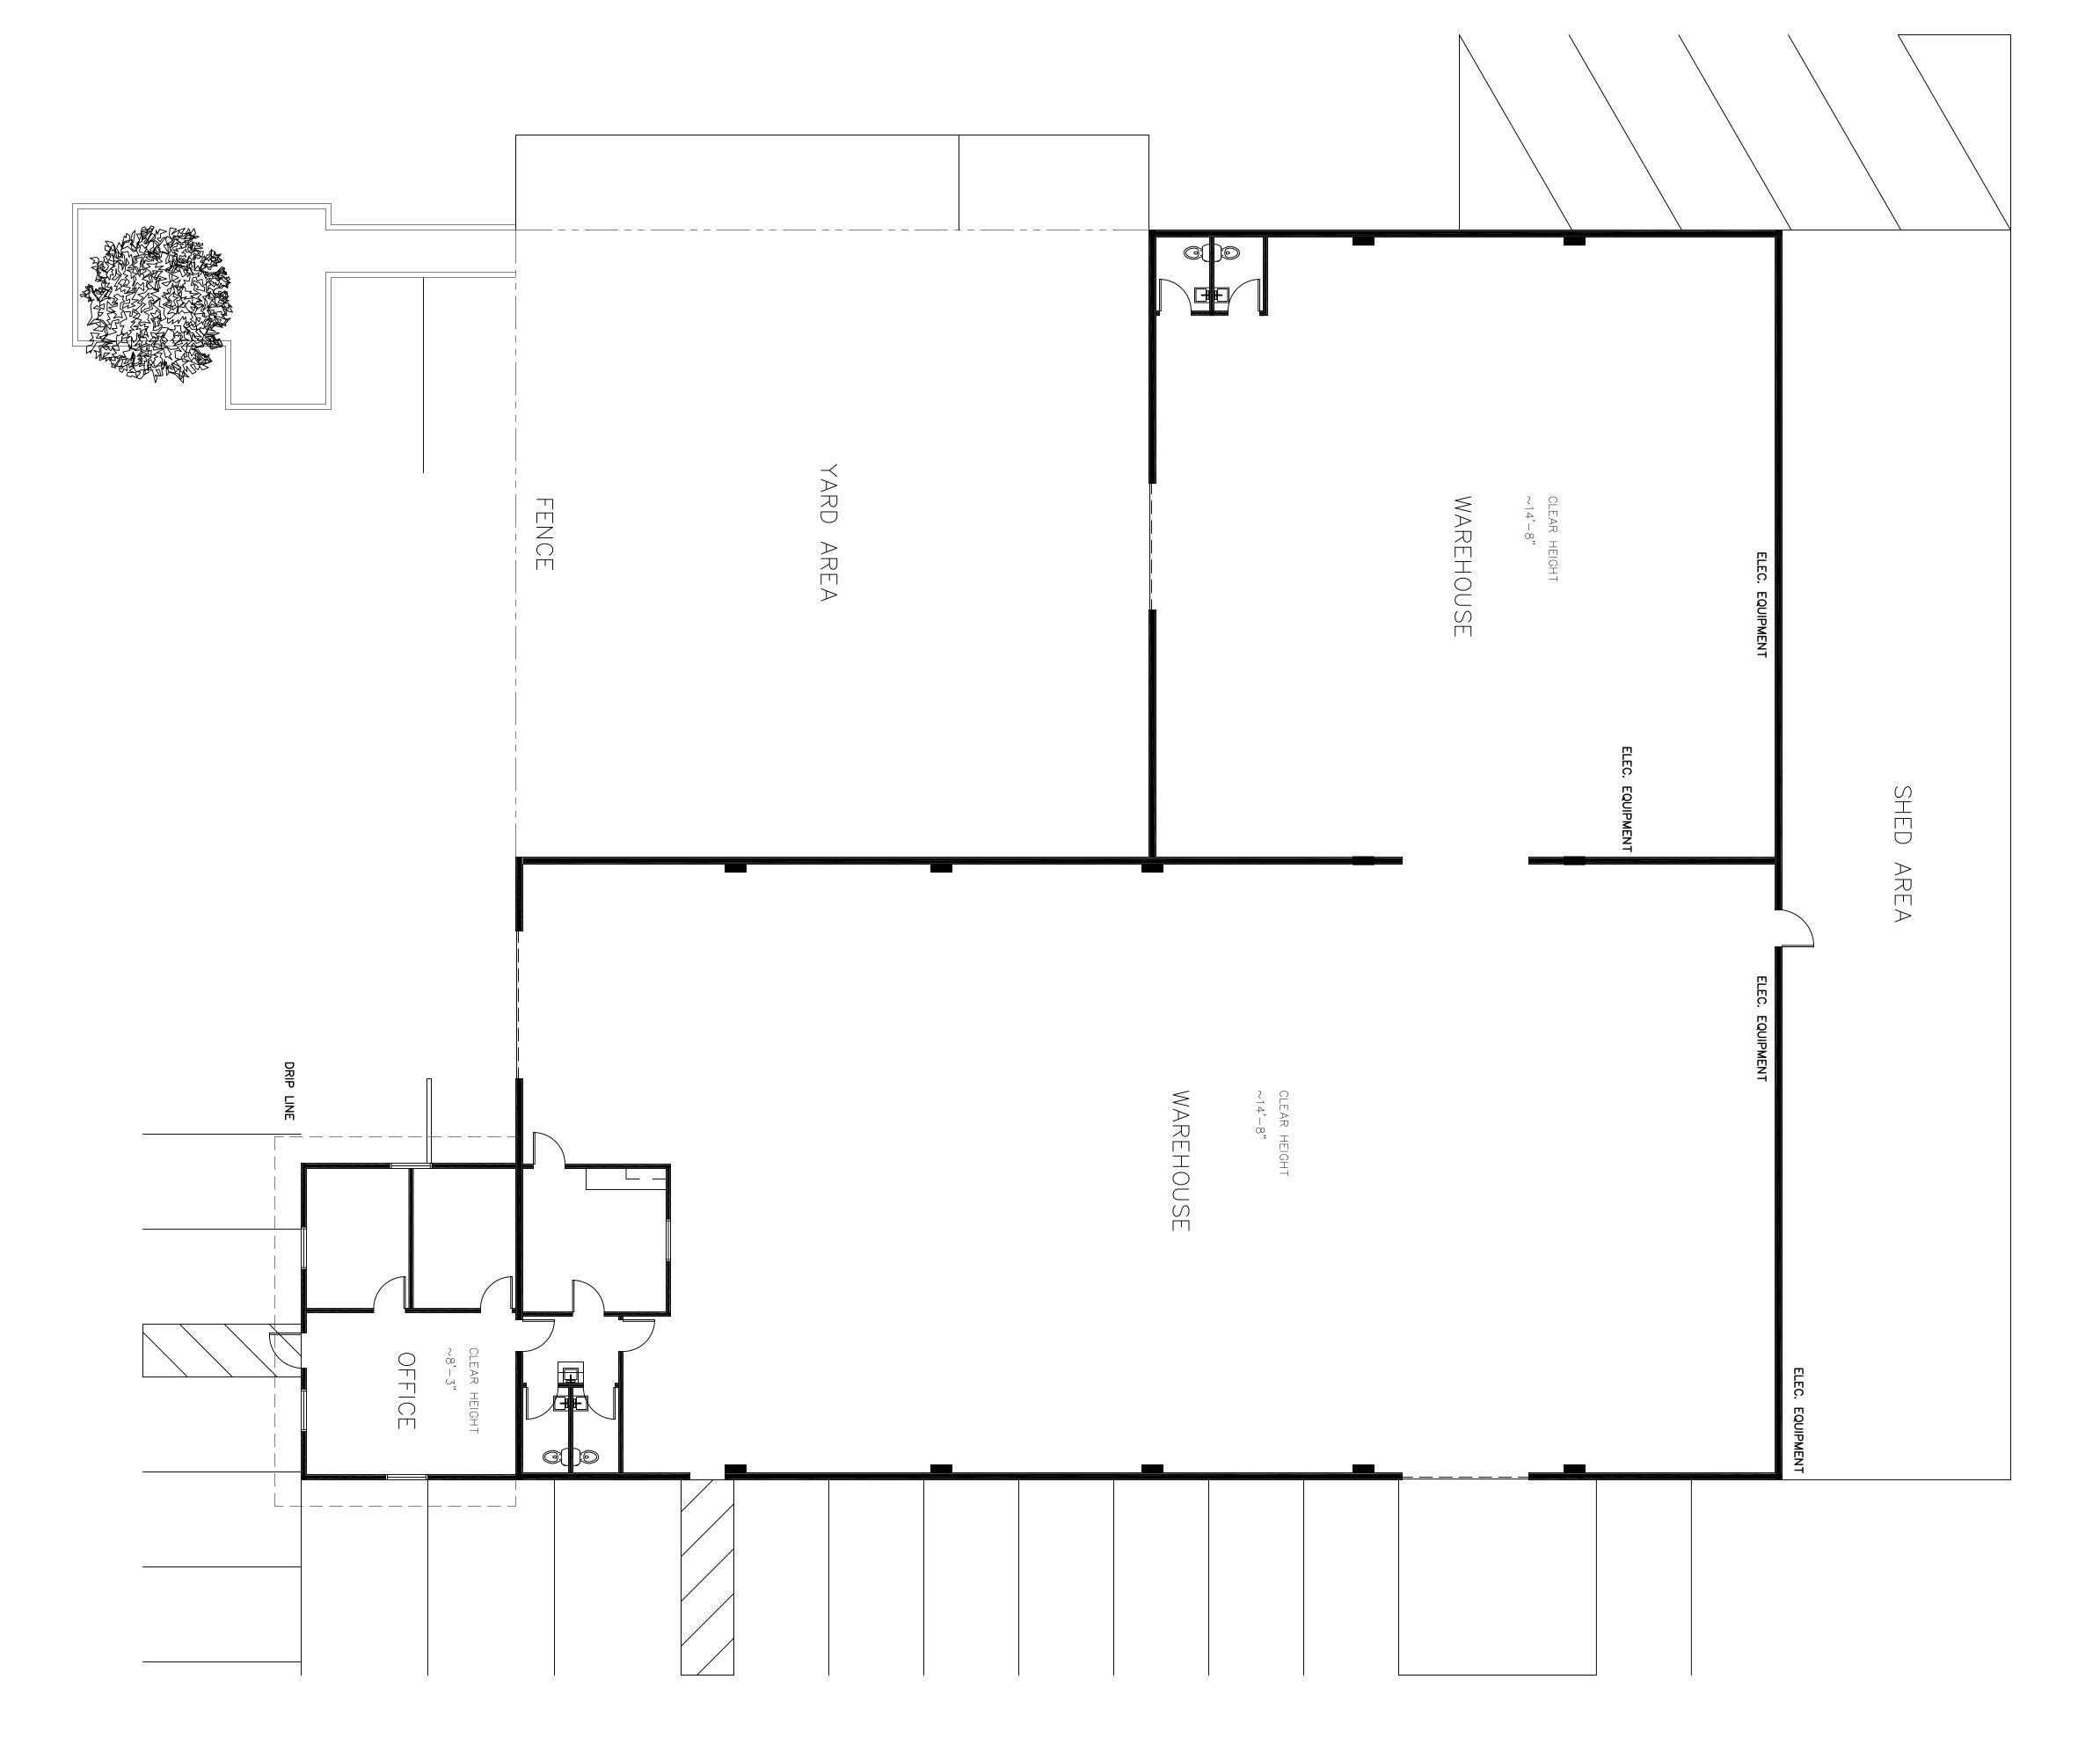

	PANELS:	3LDG. 5221
120 400 240	100	3LDG. 5221 ELECTRICAL SUMMARY
120 VOLTS 400 AMP SHOP 240 VOLTS-3PHASE	100 AMP MAIN	SUMMARY)