


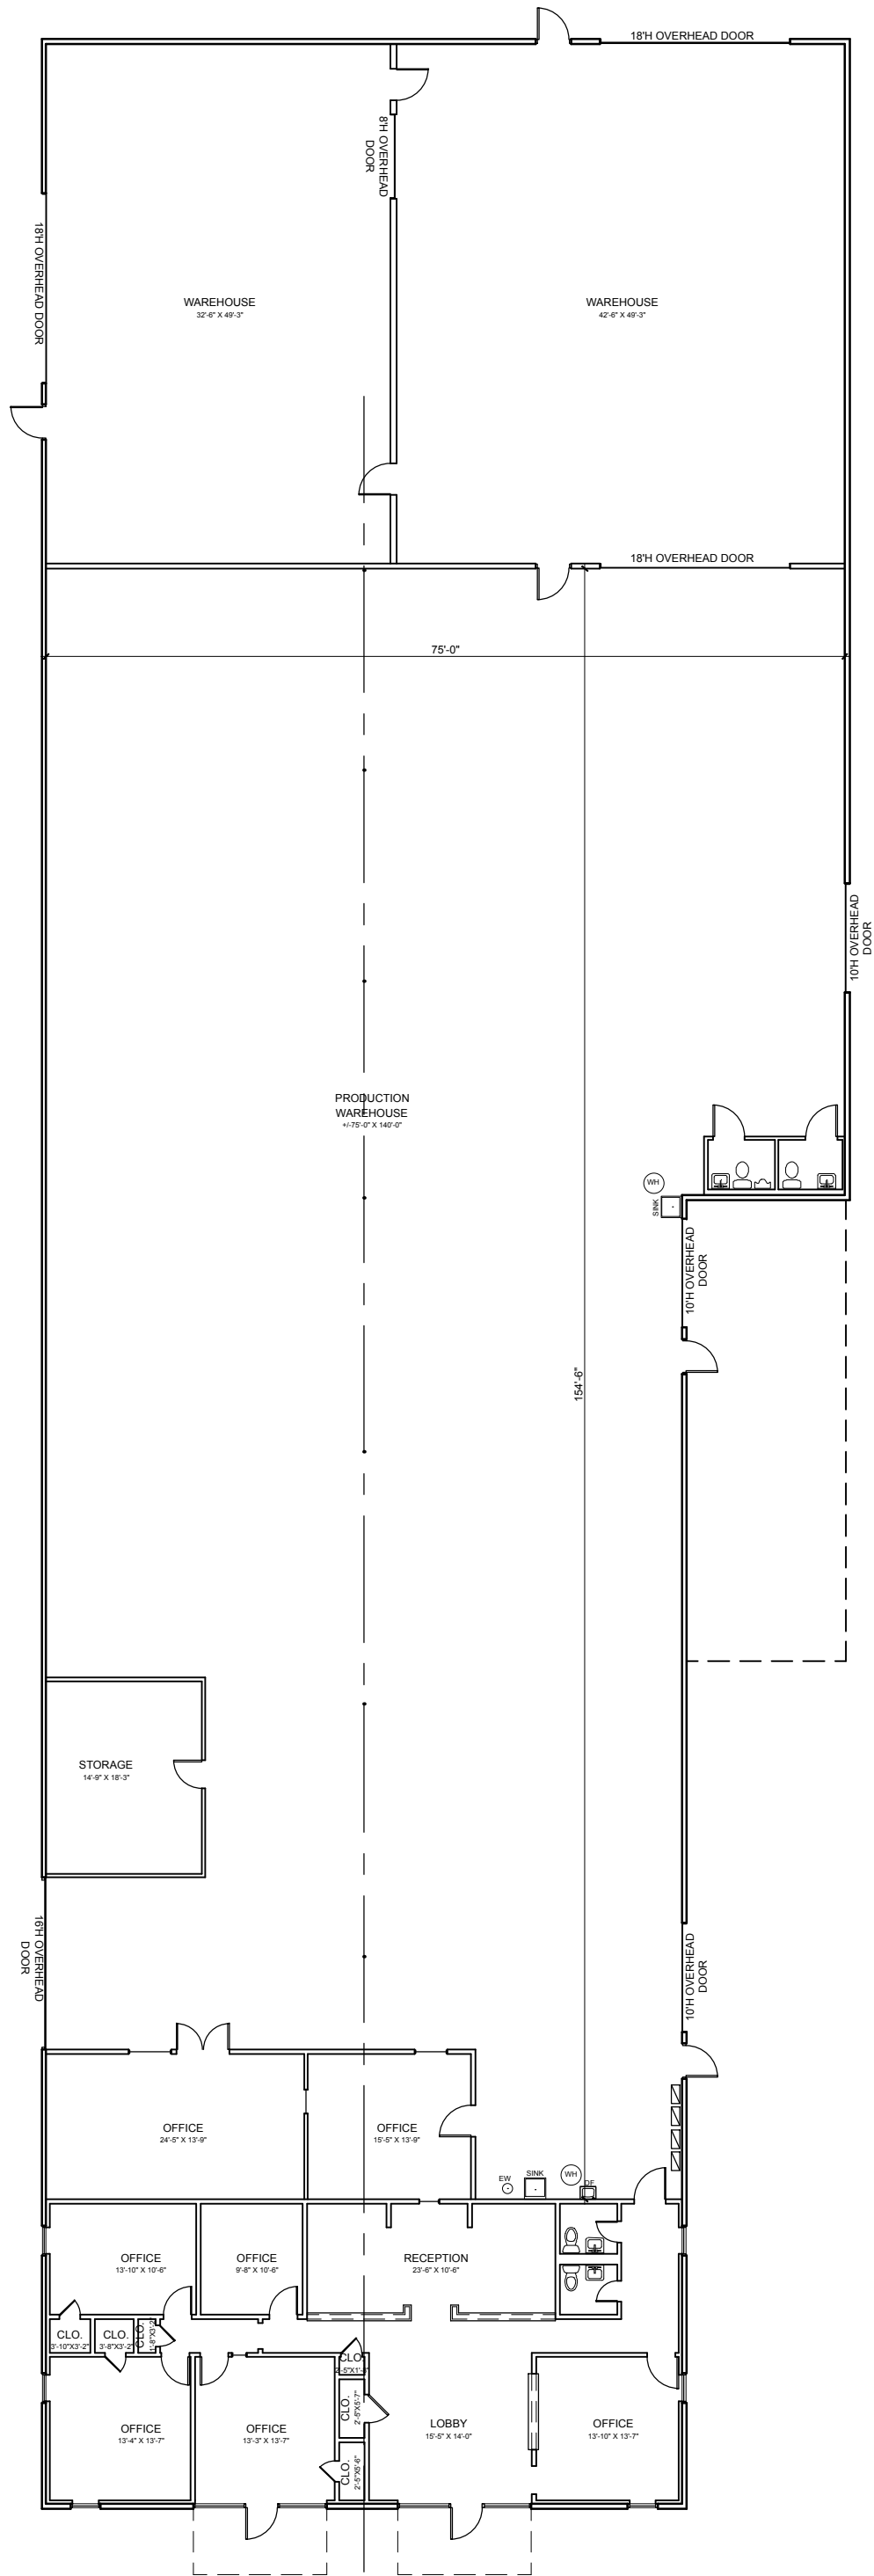

NORTH
SCALE: 1/8" = 1'-0"
PRINT ON 11x17 SHEET

01

AS-BUILT FLOOR PLAN
1616 N Interstate 35E, Lancaster, Texas 75134
13 March 2025

351 W JEFFERSON
BOULEVARD, SUITE 601
DALLAS, TEXAS 75208
2 1 4 . 2 9 3 . 3 4 9 8
THRASHERWORKS.COM
15,690 SF

