

L

Lynnea Jean Interiors
5374 West Pico Blvd
Los Angeles, CA 90019

254-723-6340


These drawings, specifications, ideas and arrangements presented thereby are and shall remain the property of Lynnea Jean Interiors. No part thereof shall be copied, disclosed to others or used in connection with any project other than the specific project for which it was prepared. Any such use or copying without the written consent of Lynnea Jean Interiors, Visual contact with these drawings or specifications shall constitute conclusive evidence of acceptance of these restrictions.

PROJECT DIRECTORY:

DESIGNER:
Lynnea Jean Schwieters

Contractor:

CLIENT: Paloma Realty

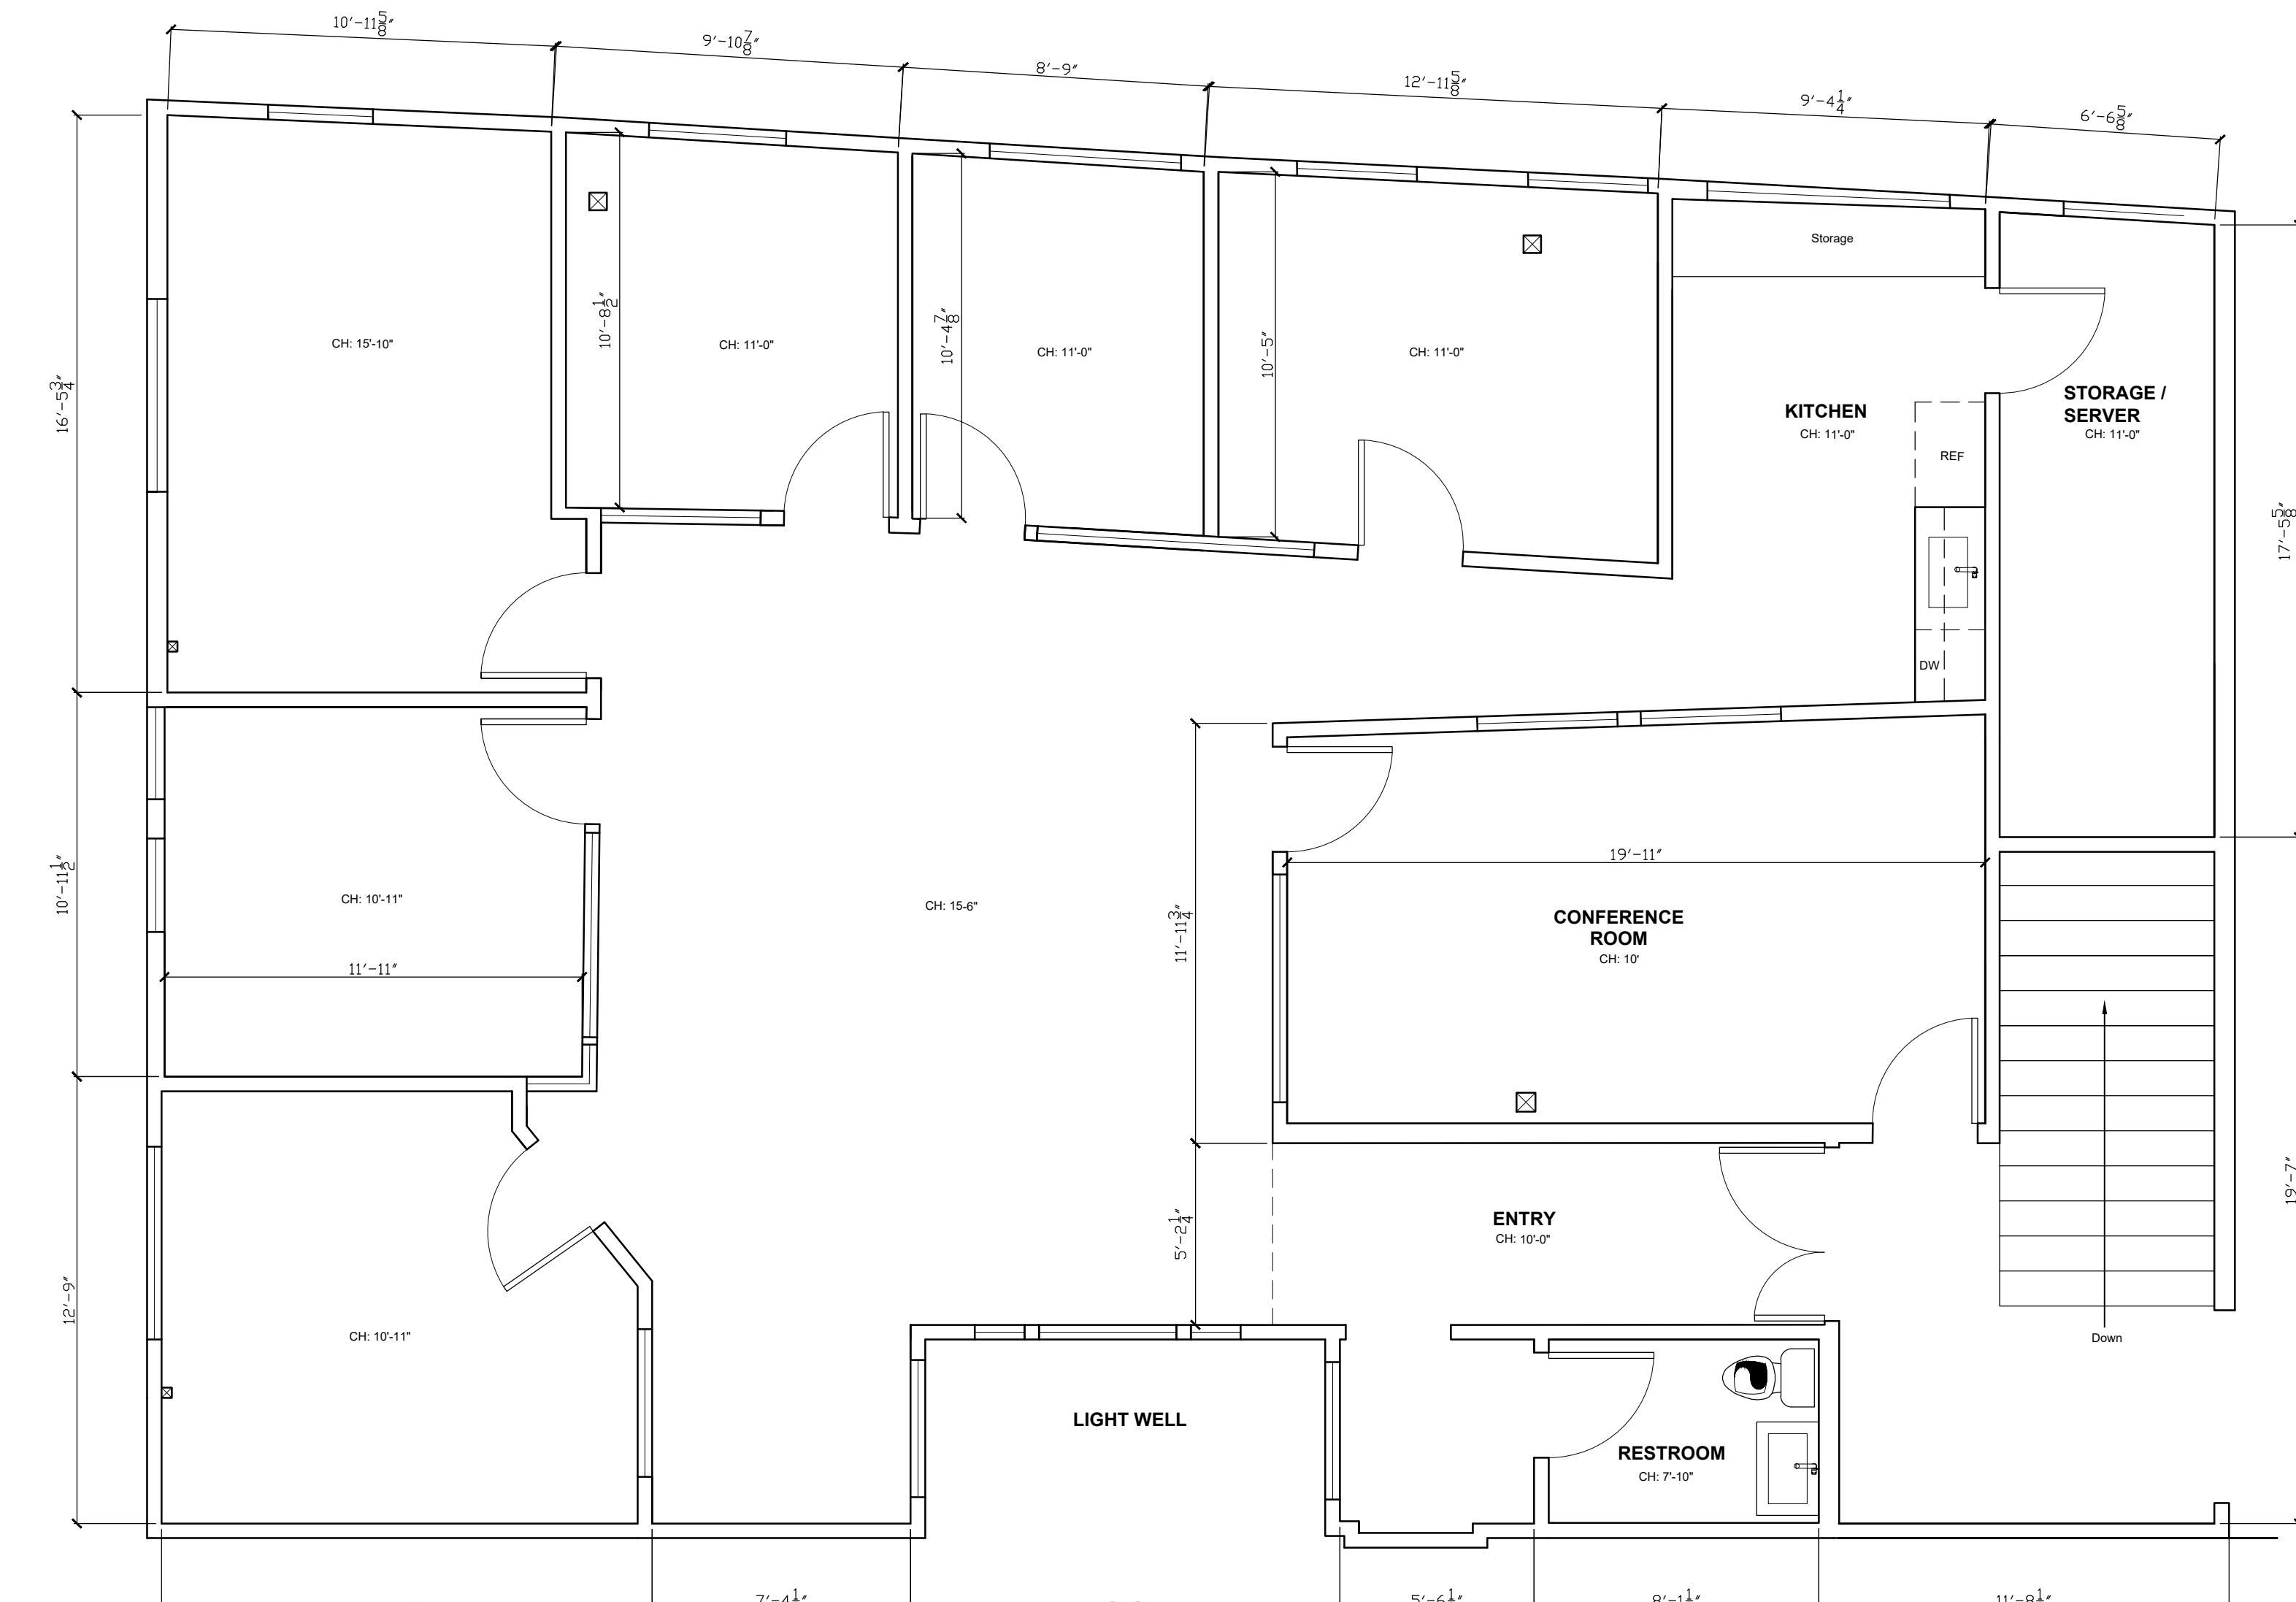

Existing Floor Plan

Project Address & Owners:	
Upper 80	
DATE PRINTED:	BENCHMARK:
4/16/19	As Built
SHEET TITLE:	
Upper 80	
Existing Floor Plan	
SCALE : 1/4" = 1'-0"	
SHEET NO:	
I-2.0	