


SCALE: N.T.S.

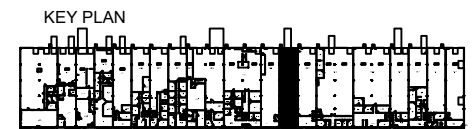

AS-BUILT PLAN--SUITE 415
4,050 RSF

14 PRYOR DRIVE
CHATTANOOGA, TN 37421