

36700 Woodward Avenue

Ground Floor

BIRMINGHAM, MICHIGAN



2075 West Big Beaver, Suite 100

Troy, Michigan 48084

Telephone 248.341.3999

Facsimile 248.646.3744

www.dietzpropertygroup.com

FLOOR PLAN

Available

Suite 50
1,536 RSF

Available

Suite 60
1,062 RSF

Kotz Sangster Wysocki, P.C.

Suite 55
1,142 RSF
1,038 USF

Kotz Sangster Wysocki, P.C.

Suite 40
1,659 RSF
1,508 USF

Reading & Language Arts Centers, Inc.

Suite 20
1,881 RSF

P & C Industries
Suite 15
159 RSF

State Farm Insurance
Suite 10
1,241 RSF

- (Available) Storage
- Remax Storage
- Remax Storage
- Remax Storage
- Oakland Dermatology Storage
- Oakland Dermatology Storage
- Dr. Nafso Storage
- DPG/DRC Storage

Advanced Techniques Massage


Suite 45
440 RSF
400 USF

Jim & Bill Holmes

Suite 70
858 RSF
780 USF

Sarah Radke, P.C.

Suite 30
1,409 RSF

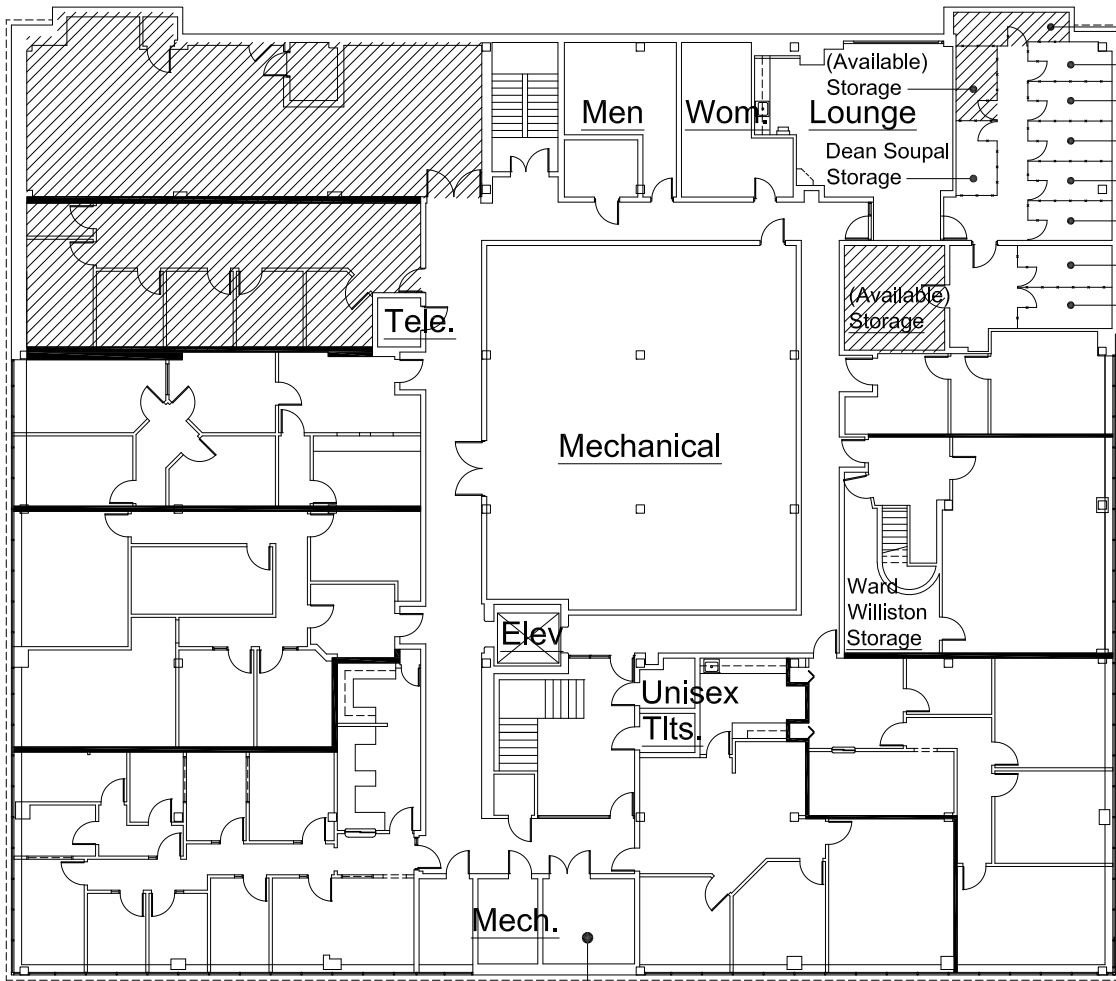

AS-BUILT FLOOR PLAN

0 8' 16' 32'



GRAPHIC SCALE

FOR LEASING INFORMATION,
CONTACT: BRIAN SALLIOTTE
(248) 341-3320

22-590

07/12/22