Drawing scale and dimensions are provided for reference only. Refer to CAD files for exact measurements.

©2010 2-D As-Built Floor Plans, Inc. All Rights Reserved.

Area Analysis performed in accordance with ANSI/BOMA Z65.1 - 2017 Method A Standard.

Project: C23-462

Date	Action	
Project		
06/01/2023	Initial Site Measure	
C23-462	1	
	1	

Client:

Daniel J Stordahl P.O. Box 2268 Seattle, WA 98111

Office 5950 6th Avenue South Seattle, WA 98108




Lease Plan



0 10 20 30 40

Scale: 1/16" = 1'-0"

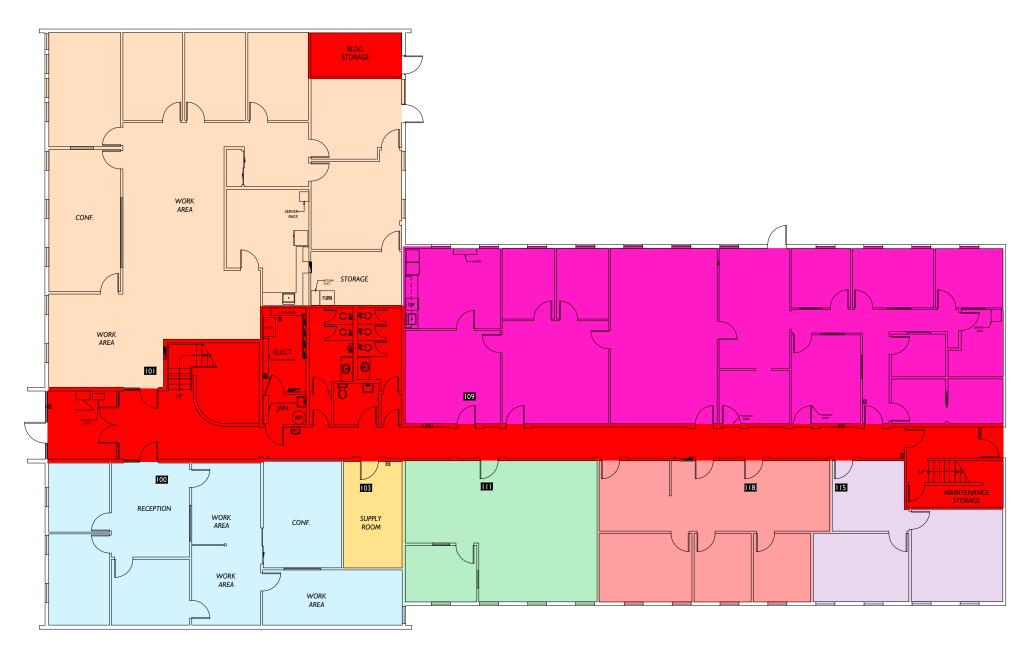

Floor Summary SQ. FT. Total Rentable Area 10,634.47 Total Occupant Area Load Factor 9,684.89 1.098048

Floor Service Area Inter Building Service Area Building Service Area 2,074.50 Total Vertical

Occupant Area	Rentable Area	Load Factor
1,425.51	1,565.28	1.098048
2,925.49	3,212.33	1.098048
182.31	200.19	1.098048
2,924.11	3,210.81	1.098048
766.24	841.37	1.098048
580.83	637.78	1.098048
880.40	966.72	1.098048
	Area 1,425.51 2,925.49 182.31 2,924.11 766.24 580.83	Area Area 1,425.51 1,565.28 2,925.49 3,212.33 182.31 200.19 2,924.11 3,210.81 766.24 841.37 580.83 637.78