
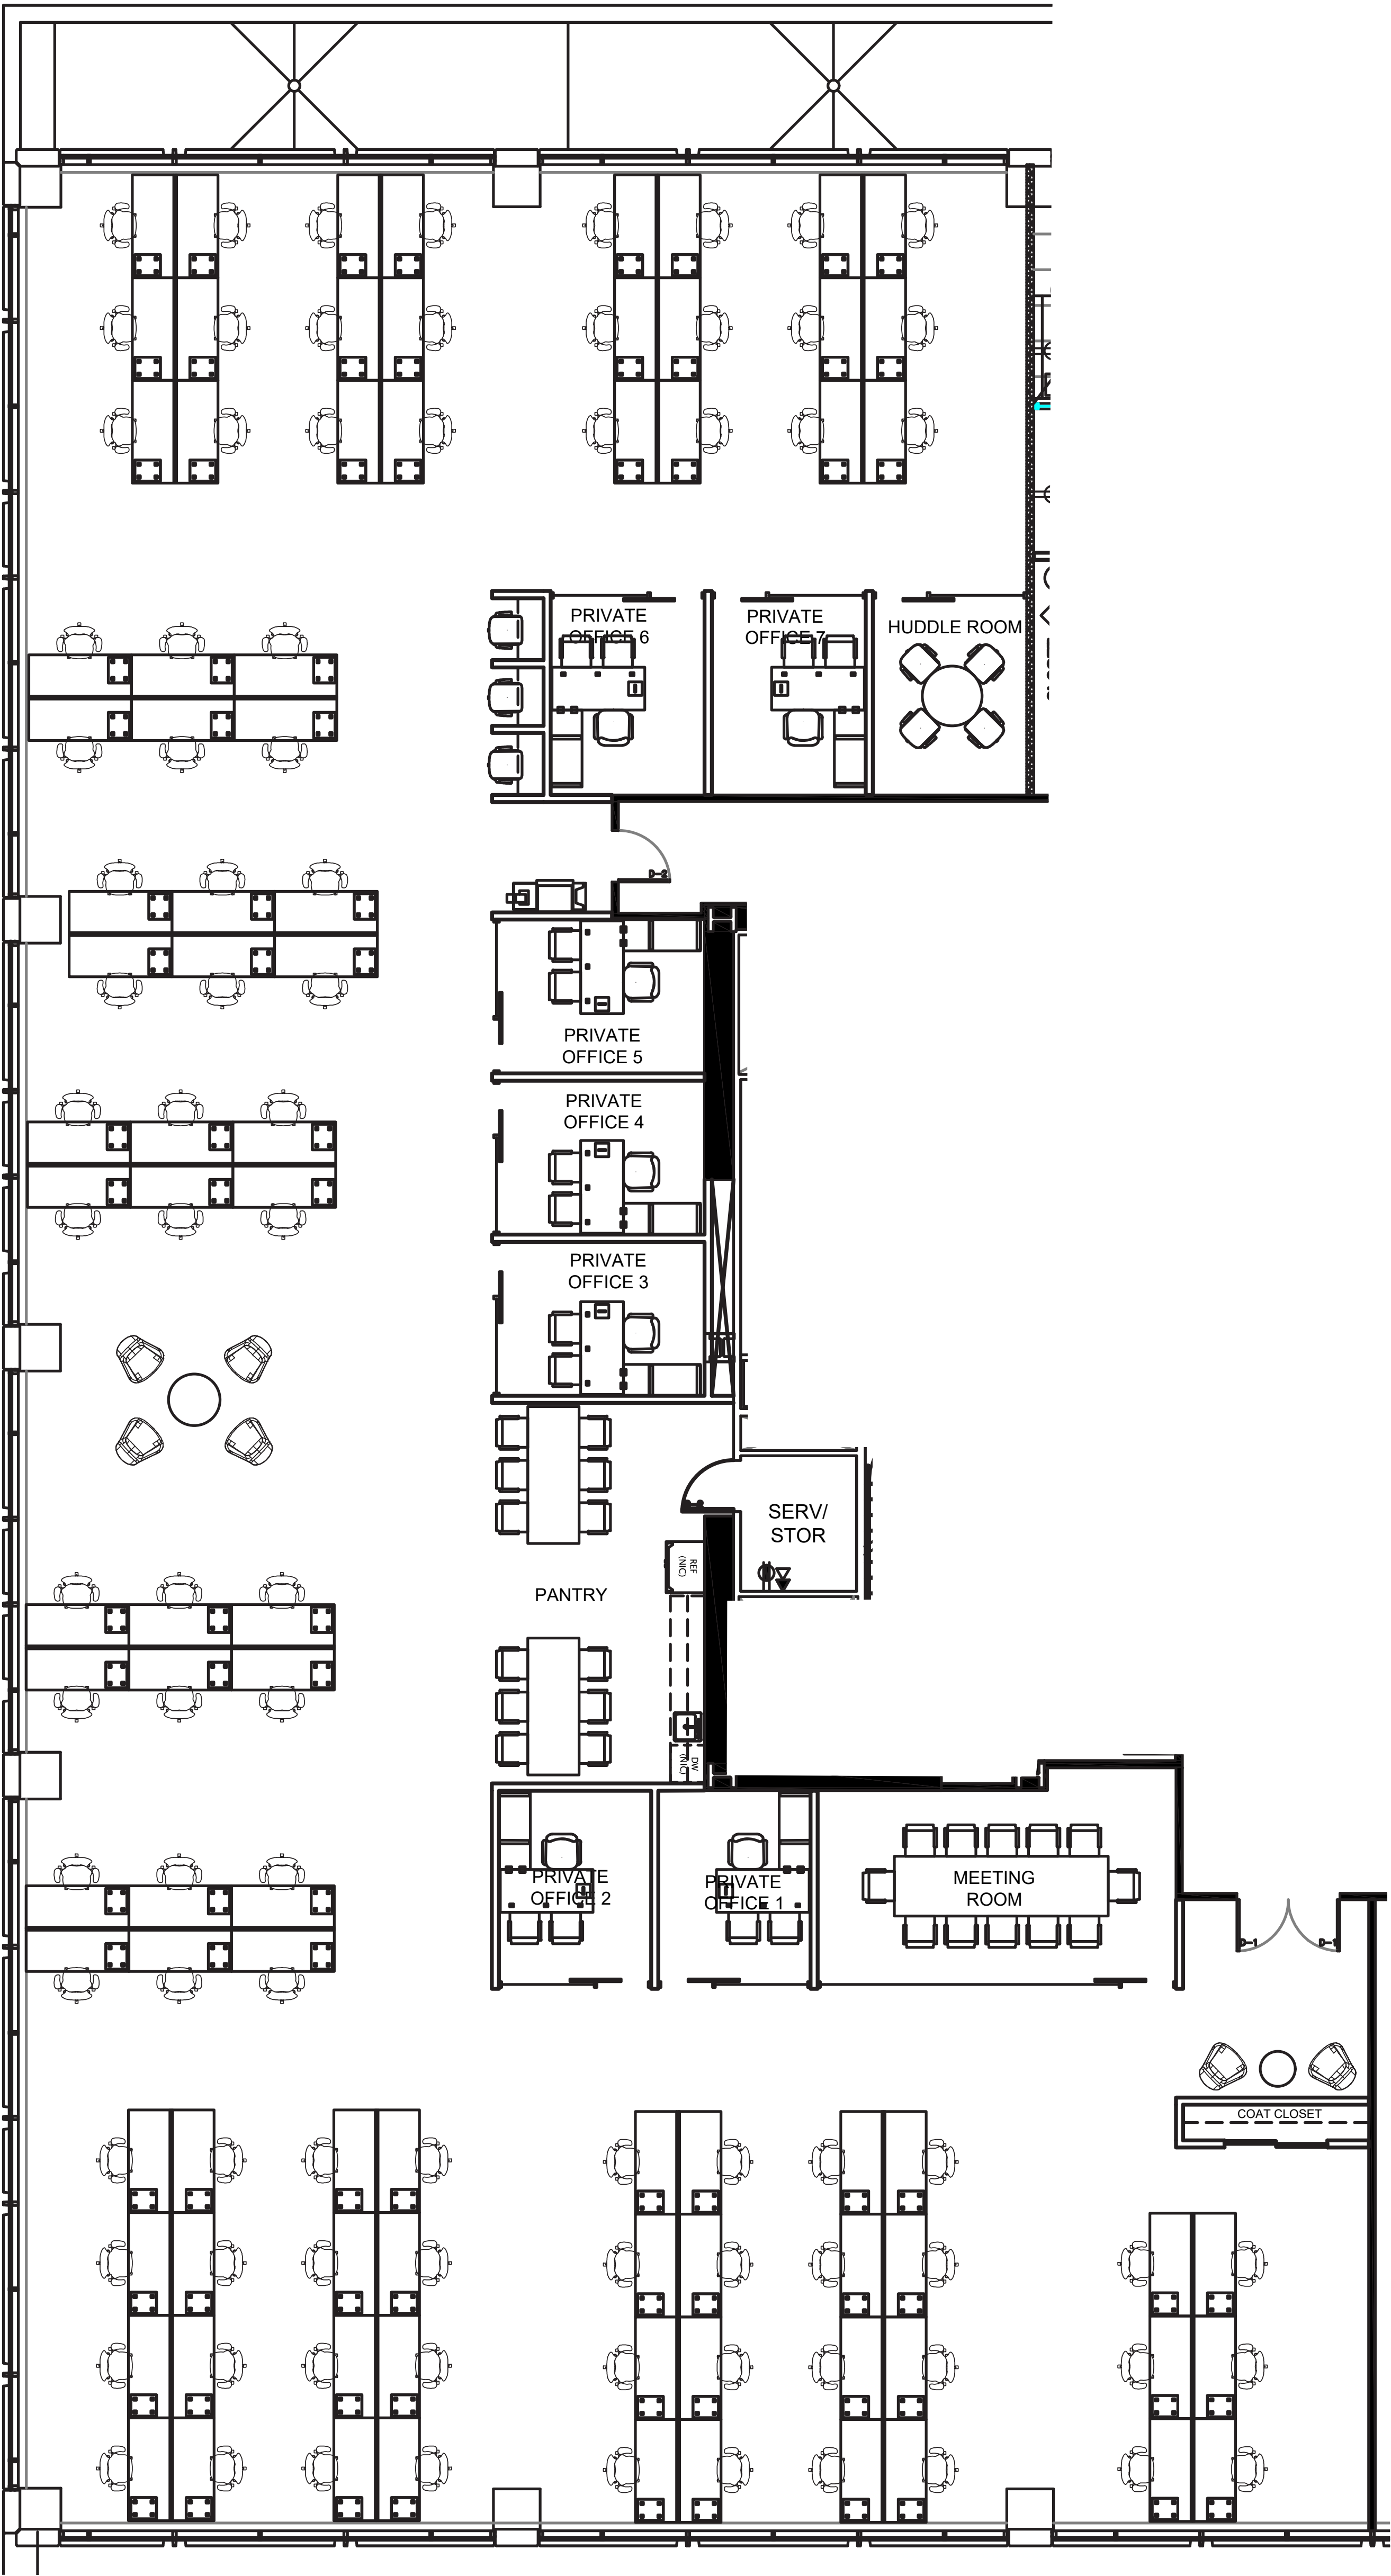


AS-BUILT CONFIGURATION

OFFICES.....	7
RECEPTION.....	1
CONFERENCE ROOMS.....	2
KITCHEN.....	1
OPEN WORK AREA.....	92

Not to scale, furniture and appliances not included

KEY PLAN

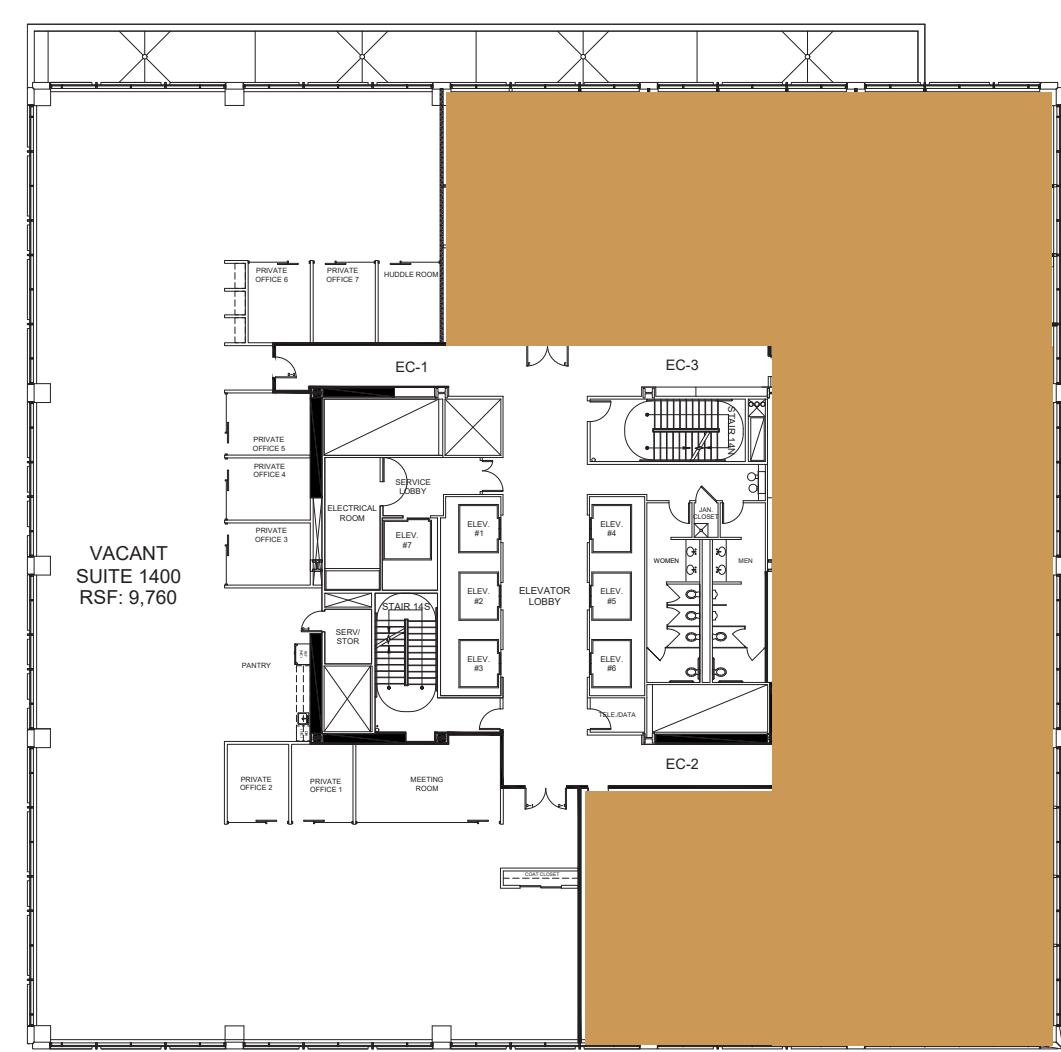

For leasing information please contact:
Mark J. Gunderson
312.819.1236
mark.gunderson@cushwake.com

Ben Cleveland
312.819.1236
ben.cleveland@cushwake.com