



Dean Associates
Architects Incorporated
Architecture & Interior Design

7 Kimball Lane Suite E6 Lynnfield, MA 01940
p. 781.397.8092 f. 781.397.8094
www.deanassoc.com

1	As-Built Survey	10/22/19
	Description	Date

DWG ISSUE & REVISION HISTORY

Stamp


Key Plan

Project Title:
**40 NAGOG PARK
ACTON MA**

Drawing Title:
**EXISTING CONDITIONS -
1ST FLOOR**

Project Number	2019.53
Scale	AS NOTED
Drawn By	PDG
Checked By	JWD
Date	10/22/19

Drawing Number
A-1.0

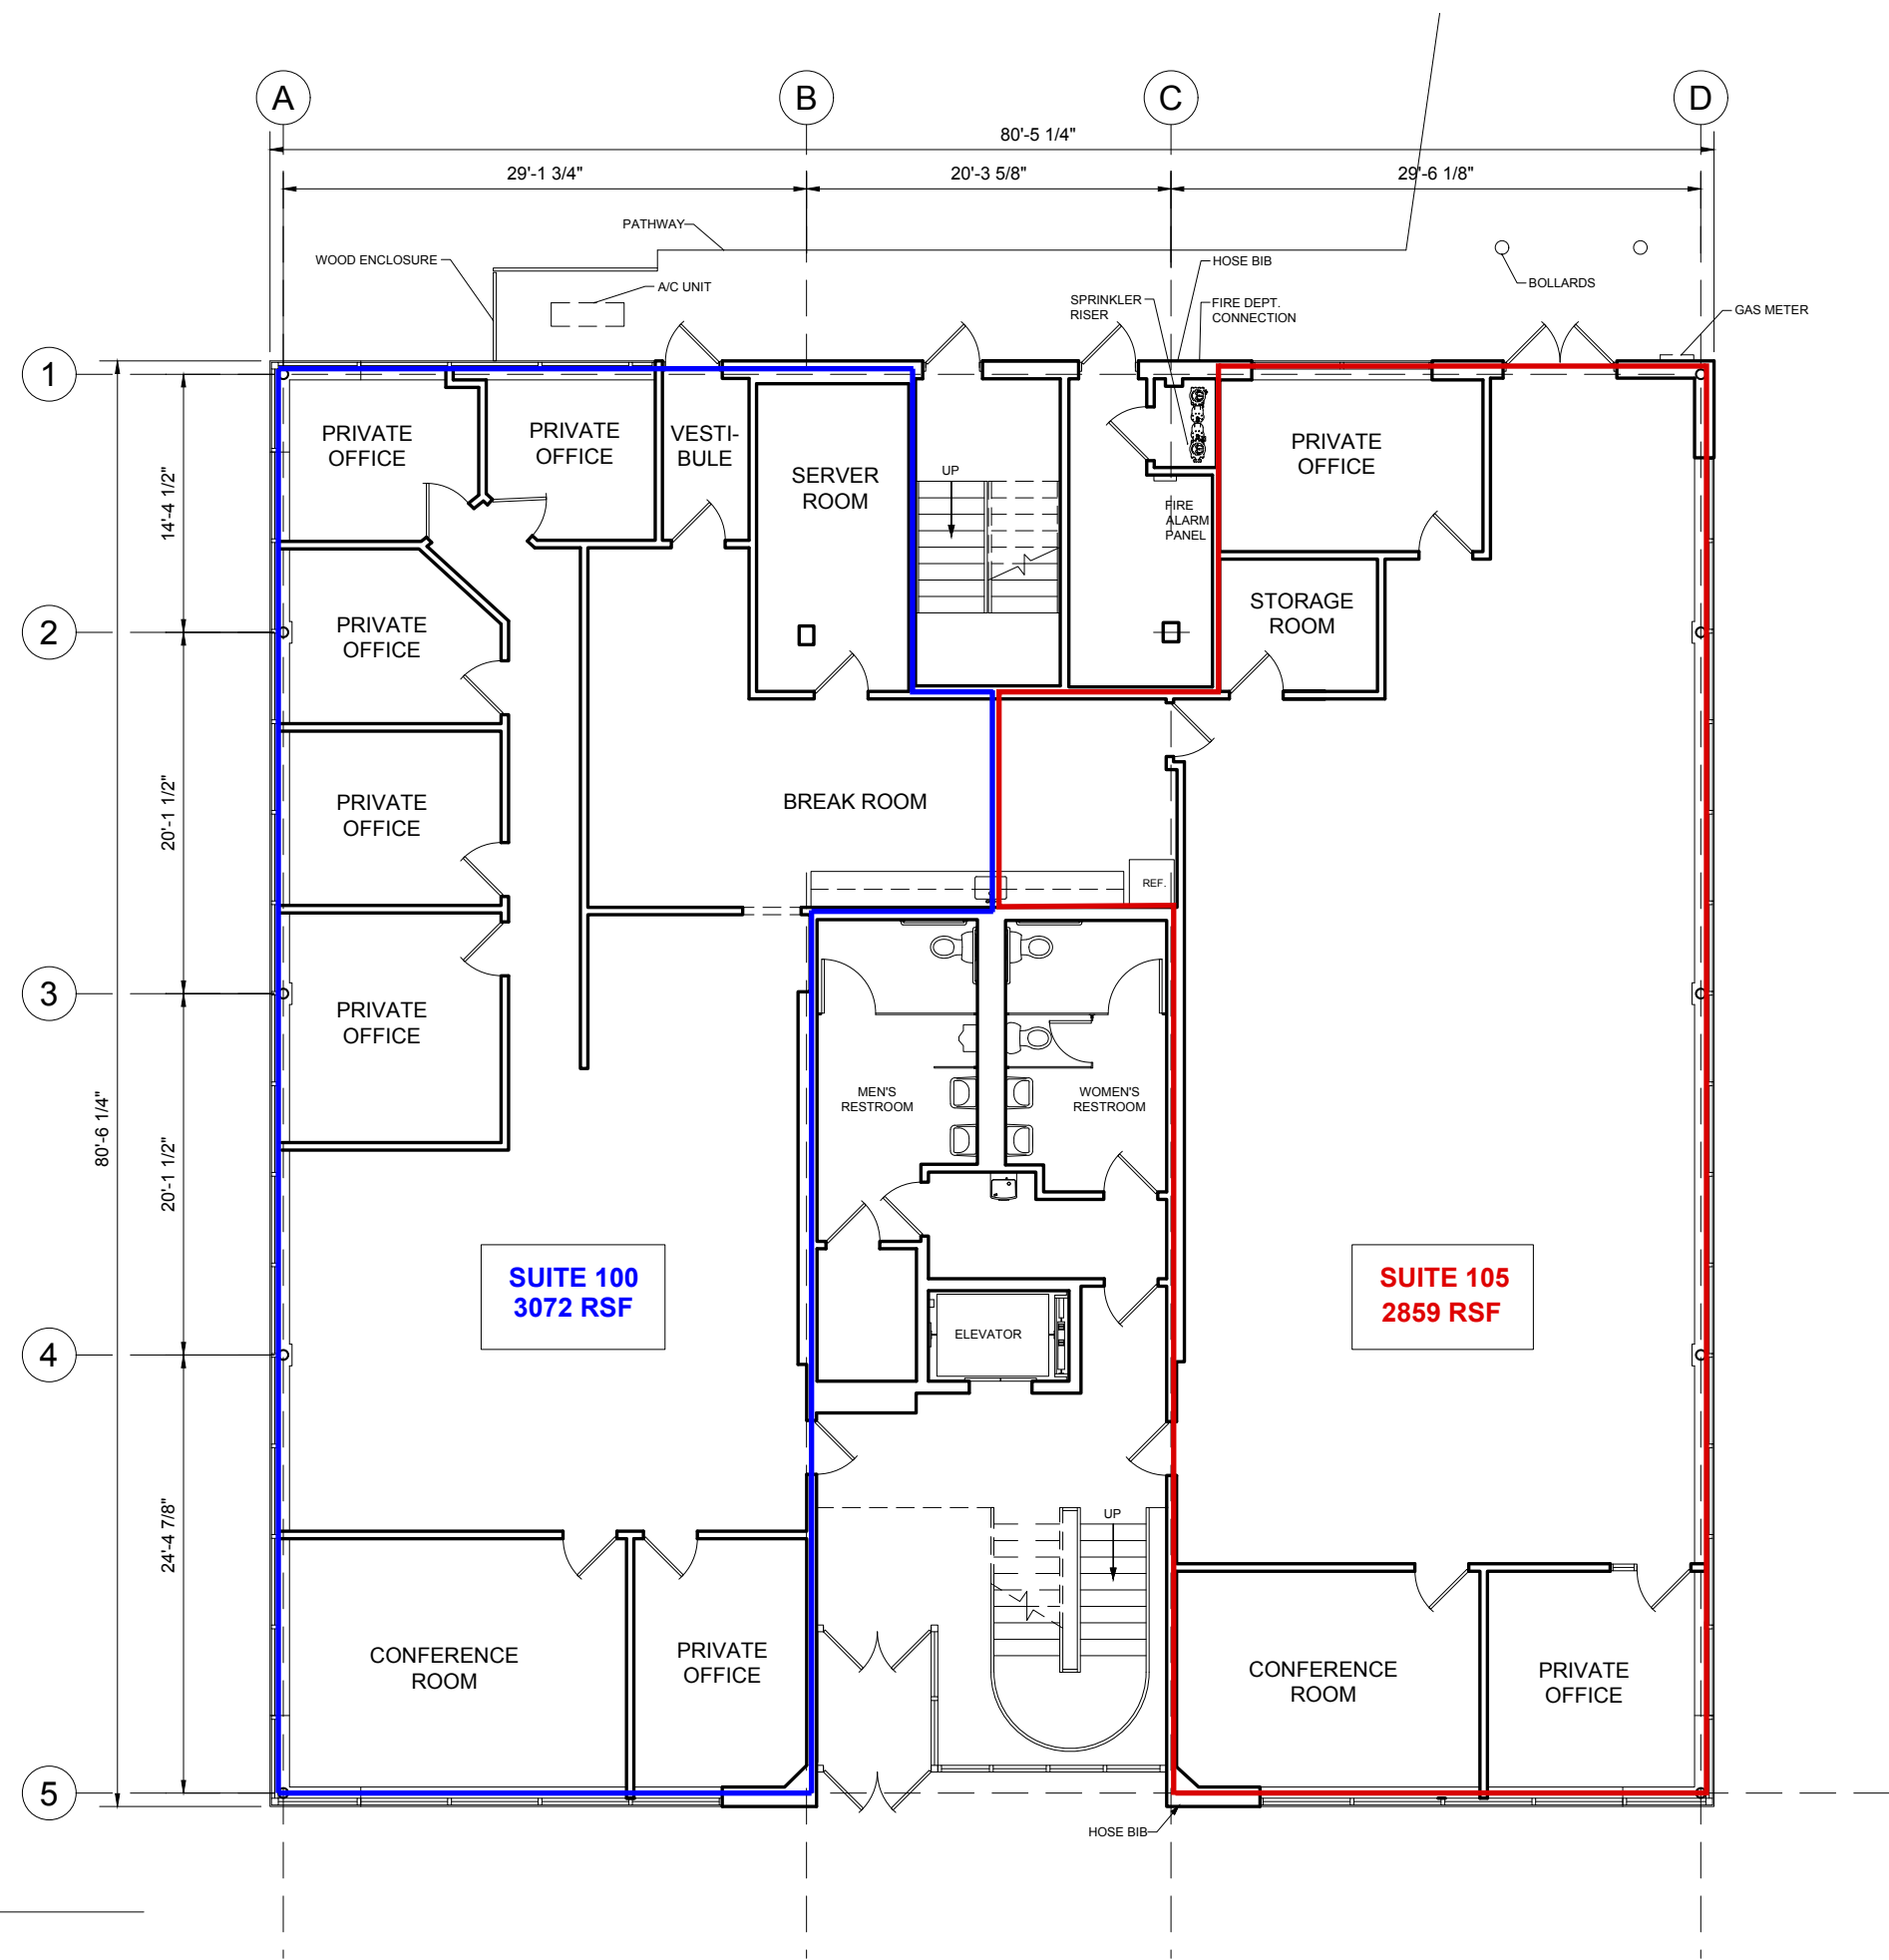

1 FIRST FLOOR PLAN
A-1.0 SCALE: 3/32" = 1'-0"