


AR Architecture, LLC.

7700 CONGRESS AVE. SUITE #1117  
 BOCA RATON, FLORIDA 33487  
 PH: 561.241.6376 CELL: 305.519.1178  
 adam@ar-architecturefirm.com

ALL DRAWINGS, SPECIFICATIONS AND RELATED DOCUMENTS ARE THE COPYRIGHT PROPERTY OF THE ARCHITECT AND MUST BE RETURNED UPON REQUEST. REPRODUCTION OF DRAWINGS, SPECIFICATIONS AND RELATED DOCUMENTS IN PART OR WHOLE IS FORBIDDEN WITHOUT THE ARCHITECT'S WRITTEN PERMISSION.

CONTRACTOR MUST CHECK AND VERIFY ALL DIMENSIONS AND FIELD CONDITIONS AND NOTIFY ARCHITECT/ENGINEER IMMEDIATELY OF ANY DISCREPANCIES.

NO.	DATE	REVISION

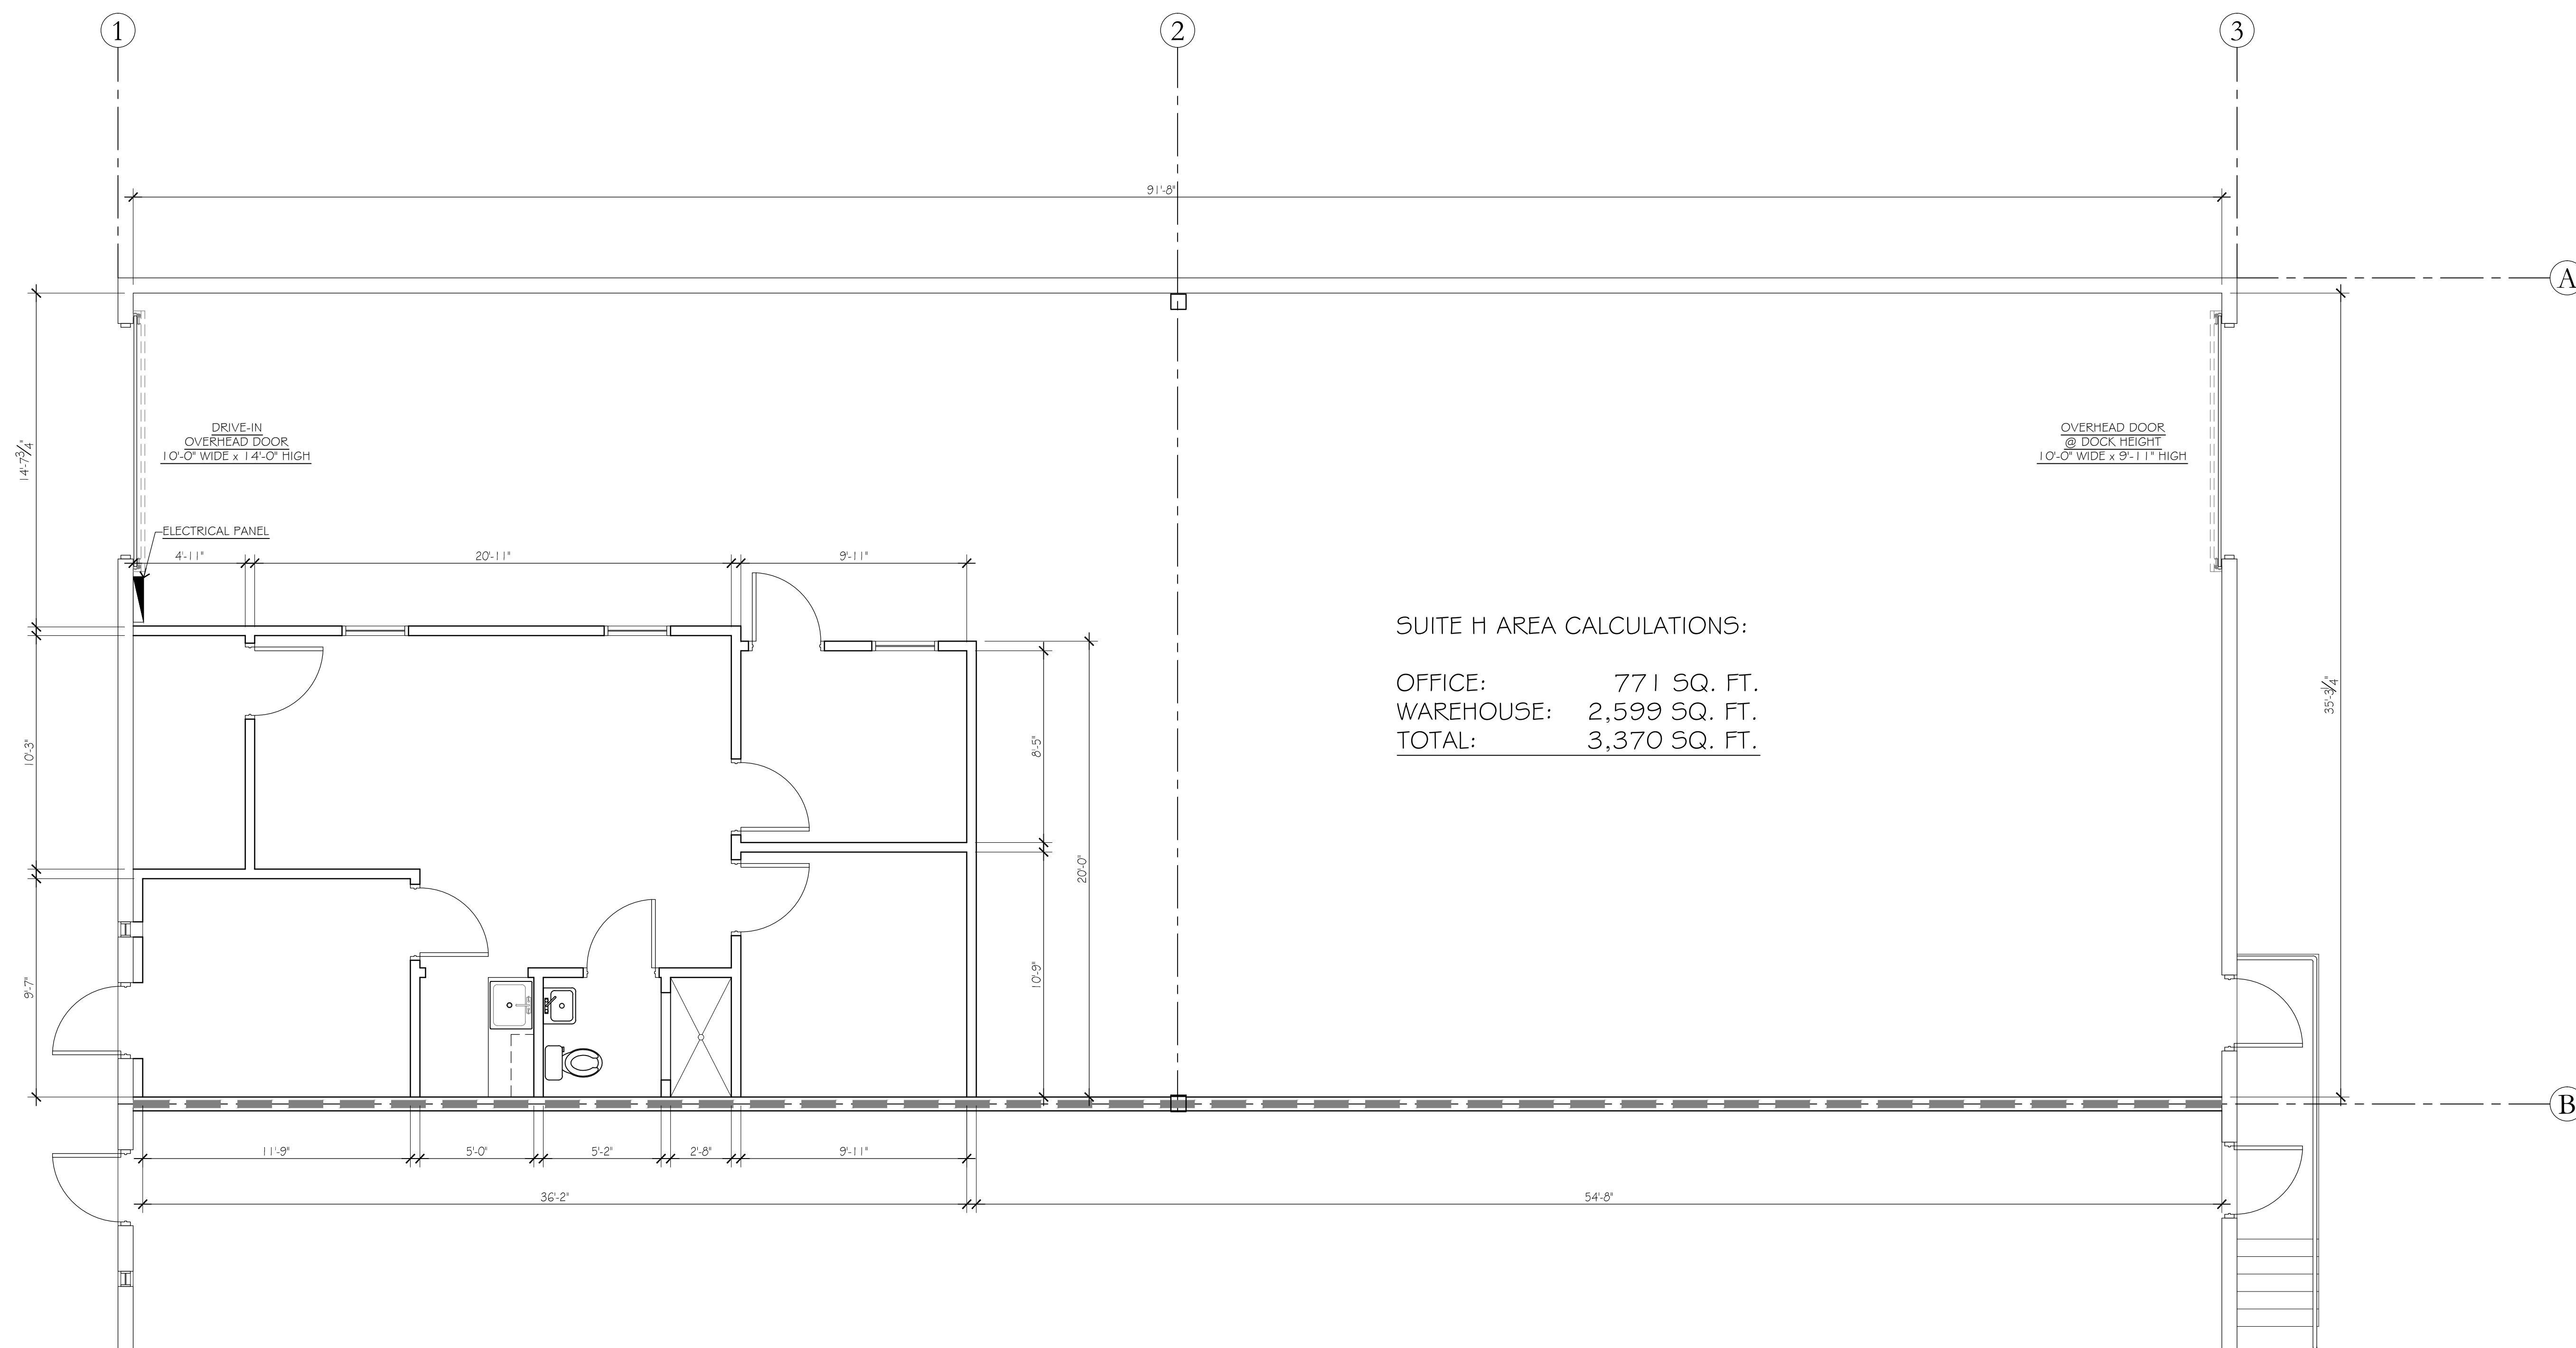

SUITE H AREA CALCULATIONS:


OFFICE: 771 SQ. FT.  
 WAREHOUSE: 2,599 SQ. FT.  
 TOTAL: 3,370 SQ. FT.

# AS-BUILTS

## Existing Conditions

3698 NW 16th Street, Suite H  
 Lauderhill, FL 33311

ADAM RYDZEWSKI  
 FLORIDA REGISTERED ARCHITECT  
 REGISTRATION NO. AR0892163

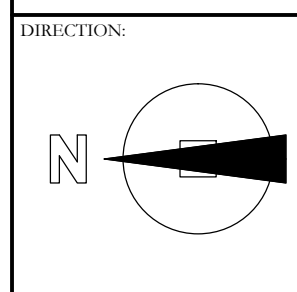

ISSUED DATE: 2017-11-27

DRAWN BY: E.D.

DATE PRINTED: 2017-11-27

CHECKED BY: A.R.

SCALE: AS NOTED

PROJECT NO. 17-150

TITLE:  
 EXISTING FLOOR PLAN

DRAWING NO.

# A-1.0