

01-25
09-04/75

57-4-02 57-9100

New # 9519
1110627

SEWAGE DISPOSAL RECORD

Stokes County Health Department
 Name of Occupant Robert Smith W. C. Harold Boles Location of Building Pinnacle R-1
 Name of Owner Same W. C. Date of Installation 2-22-60
 Type of Privy Constructed _____ Number _____ New or Repaired _____

Septic Tank Concrete (Material and Shape) Date Inspected 2-23-60 Permit No. 60-532
 Capacity 450 F.H.A. Case Yes No

Number of Bedrooms 2 Type Secondary Treatment Wrenfield

Source of Water Supply well (bored) Distance From Nearest Pollution 80 Ft.


Contractor or Plumber Adams Address Kelley St.

Approved by Charles R. Cole Sec

Remarks Use at independent Sec Sta. N. of Pinnacle (Over)

N. C. STATE BOARD OF HEALTH 3532 N 1d 52 Rd
 Form No. 473 - Rev. 4-57

NOTE: Make sketch of installation showing location of house septic tanks, privies, water supplies on adjacent property, etc. Write in measurements in order that installations may be located at later date.

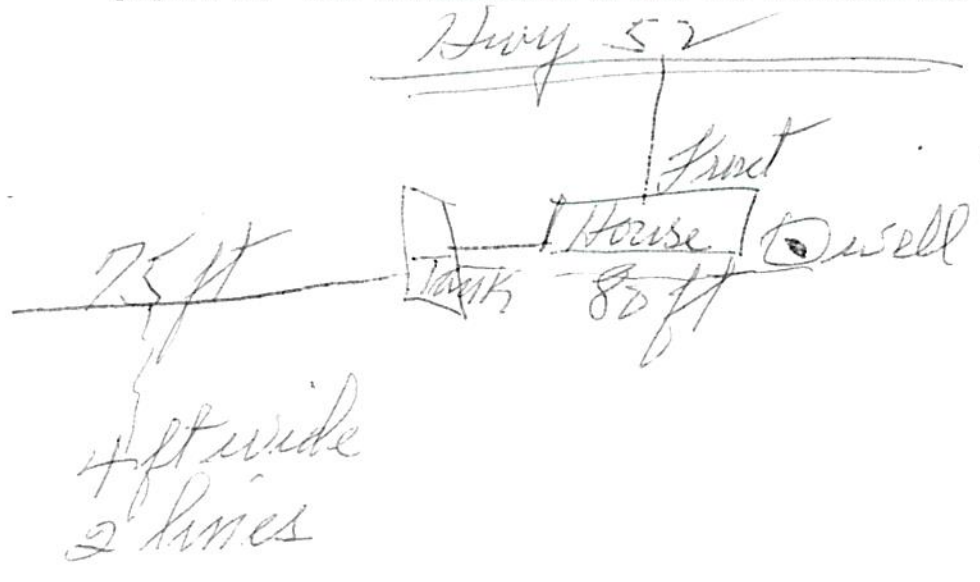


19808

STOKES COUNTY HEALTH DEPARTMENT SEPTIC TANK LAYOUT AND PERMIT

Owner or Contractor Jord Mabe Date 4-23-81
 Directions & S.R. Number Old Hwy # 52 past Pinnacle on R beside
stand type 3 in rd

Permit No.: 81-607
 House Business
 Mobile Home Other
 New Installation Repair
 No. of Bedrooms 2
 Lot Size _____
 Perc Tests (1) 60 (2) 60 (3) 60 MPI
 Size of Tank 800 Gal.
 Nitrification Line 660 Sq. Ft./ 220 Lin. Ft.
 Stone Depth 12 Inches
 Water Supply well
 Layout By cm

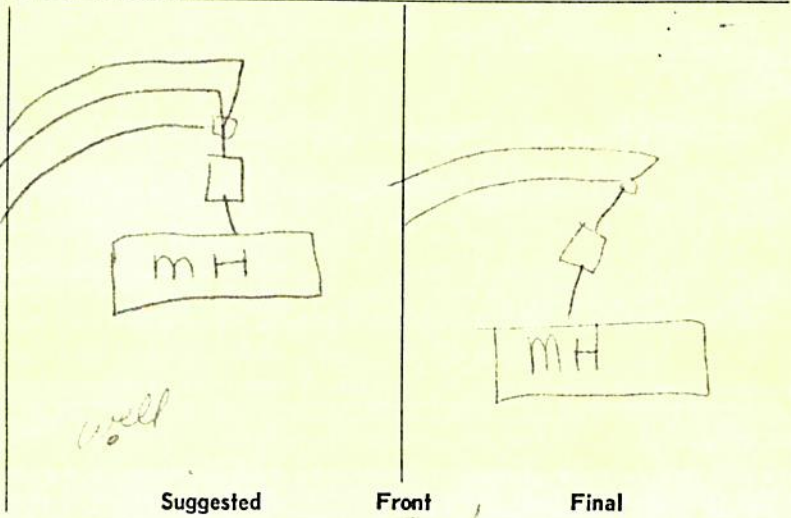

Comments _____
 Date 4-24-81 Installed By Bob McHone - Pinnacle Approved By [Signature]