

**New LED's,
Fresh White
Walls and
Deck!**

**One Month
Net Free Per
Year of Term**



FOR SALE/LEASE

INDUSTRIAL PARK BUSINESS CENTER

13310 INDUSTRIAL PARK BLVD, PLYMOUTH, MN

MATT OELSCHLAGER
+1 612 532 4747
matt.oelschlager@cbre.com

JOHN RYDEN
+1 612 723 9313
john.ryden@cbre.com

MIKE BOWEN
+1 612 597 8488
mike.bowen@cbre.com

JP MALONEY
+1 612 791 1171
jp.maloney@cbre.com

CBRE

 **Capital
Partners**

FOR SALE/LEASE

INDUSTRIAL PARK BUSINESS CENTER

13310 INDUSTRIAL PARK BLVD, PLYMOUTH, MN

PROPERTY FEATURES

- Immediate access to I-494 via County Road 6 or Hwy-55
- Mostly air-conditioned
- Expandable loading (dock & drive-in)
- Existing make up air system

DATE AVAILABLE

- Available Immediately

NET RENTAL RATES

- \$6.50 NNN

ASKING PRICE

- \$13,560,000 or \$120 psf

2026 CAM & REAL ESTATE TAXES

\$1.71 PSF CAM

\$2.54 PSF Taxes

\$4.25 PSF Total

PROPERTY SPECIFICATIONS

AVAILABLE SPACES

Suite 100

40,000 - 62,350 SF Total

- BTS Office

LOADING

2 dock doors

1 drive-in door

(Room for 5 additional docks or drive-ins)

TOTAL BUILDING SF

113,054 SF

POWER

277/480V, 1200A

CLEAR HEIGHT

16'


COLUMN SPACING

40' x 30'

PARKING RATIO

1.59/1000

AS-BUILT PLAN

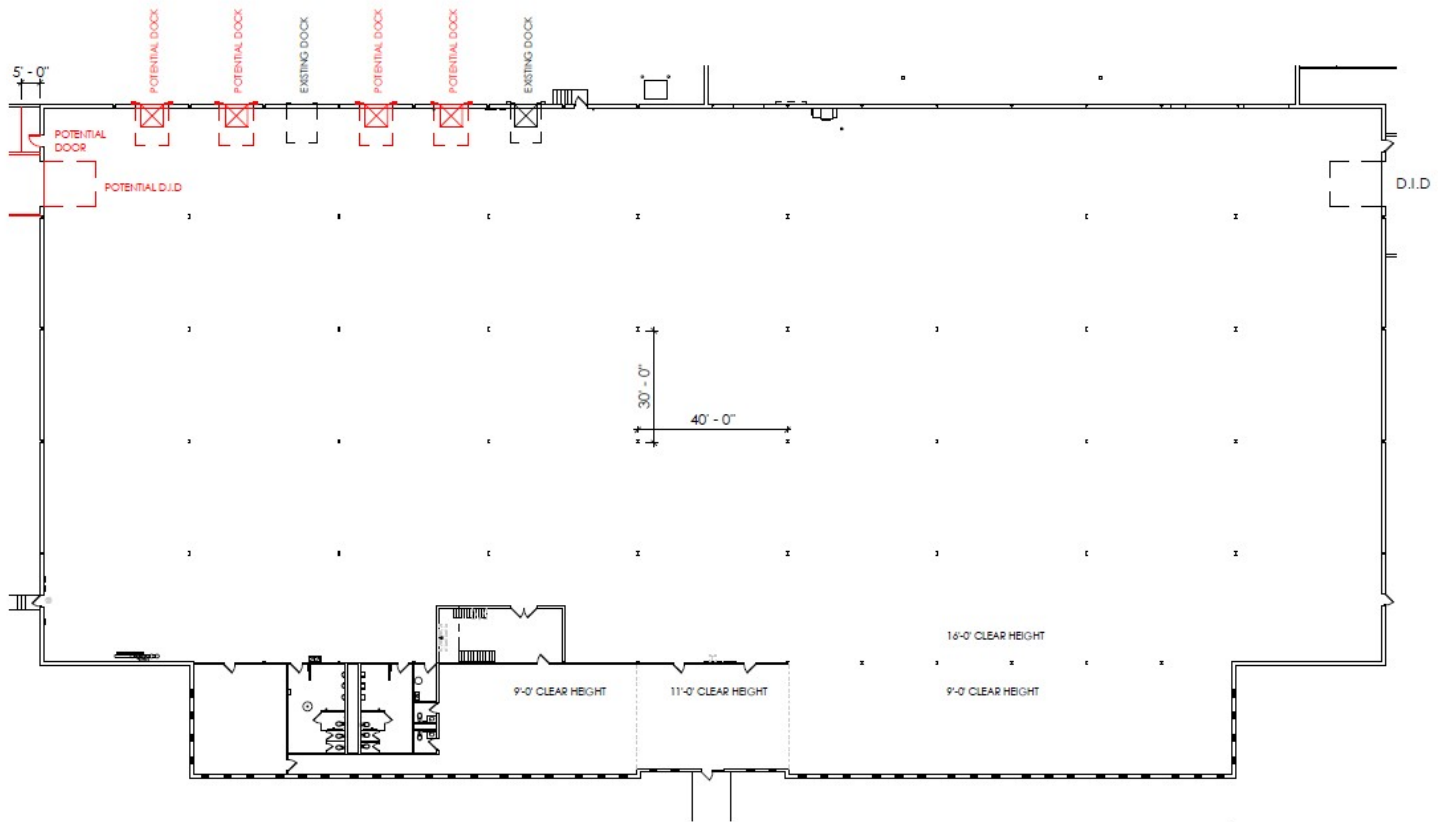


1 | Suite 100 - Existing Conditions
SCALE: 1" = 30'-0"







INTERIOR PHOTOS

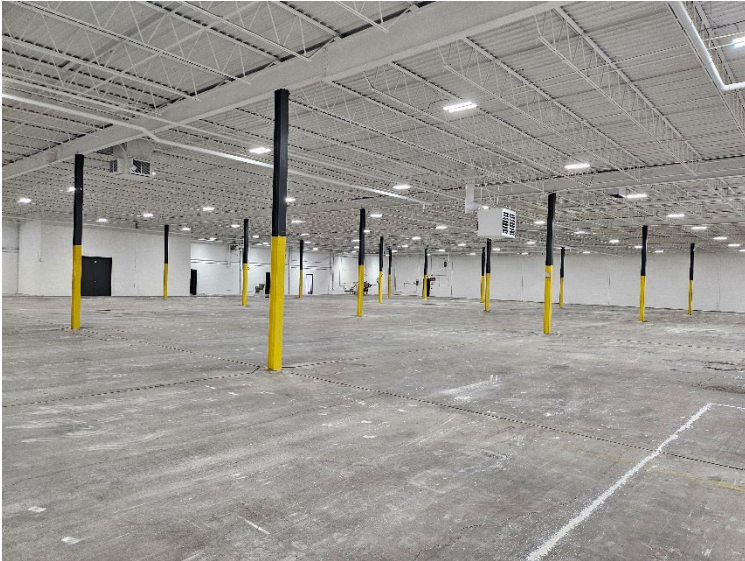

ADDITIONAL LOADING CONCEPT

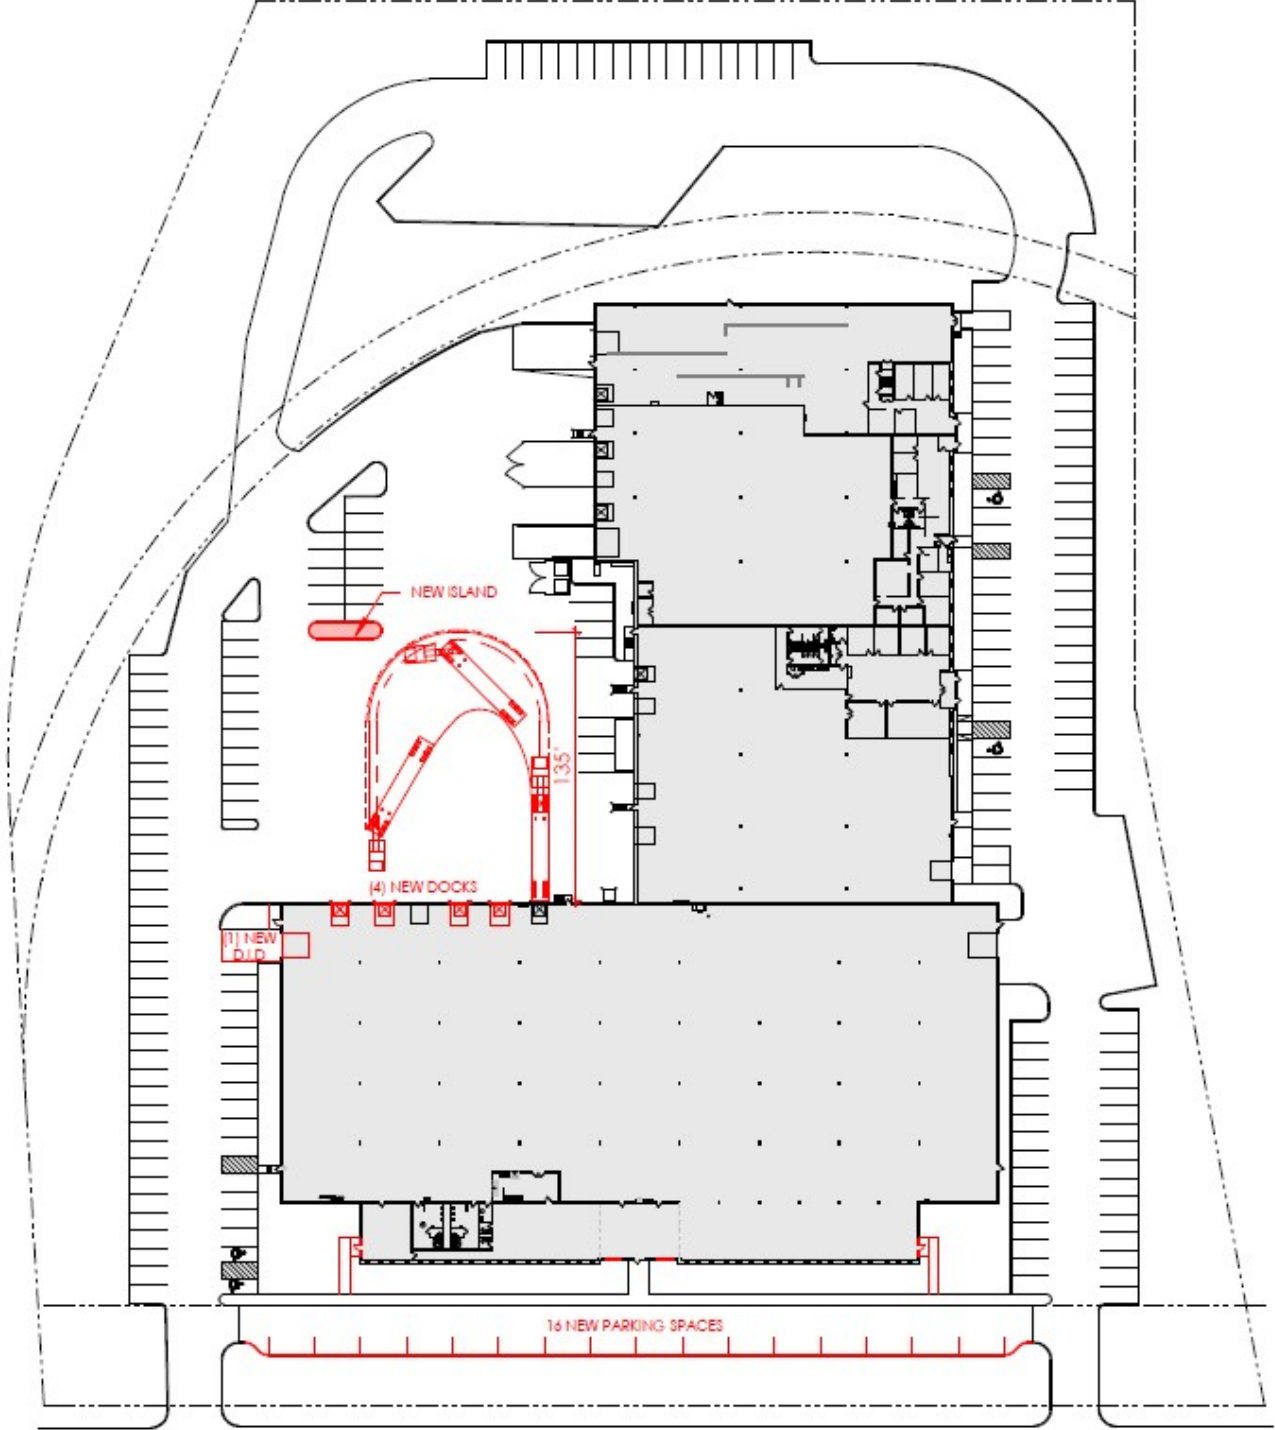

ADDITIONAL PARKING

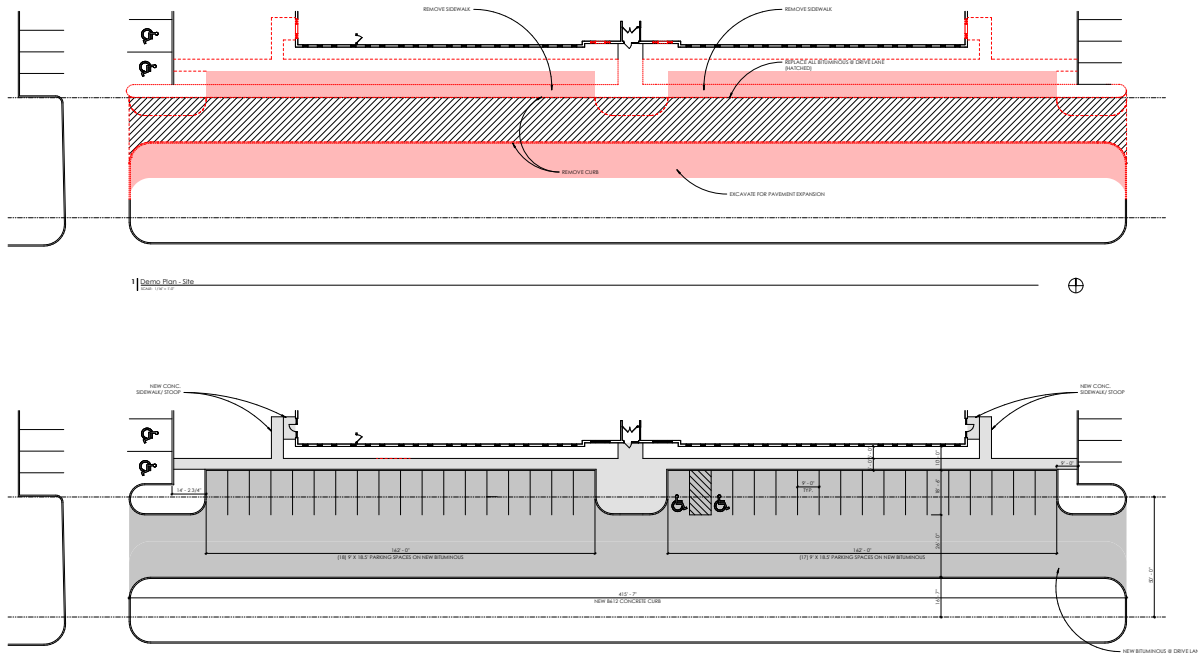


EXTERIOR RENOVATION CONCEPT



2 | Perspective - Option 3
SCALE:



1 | South Elevation - Proposed Option 3
SCALE: 1" = 20'-0"

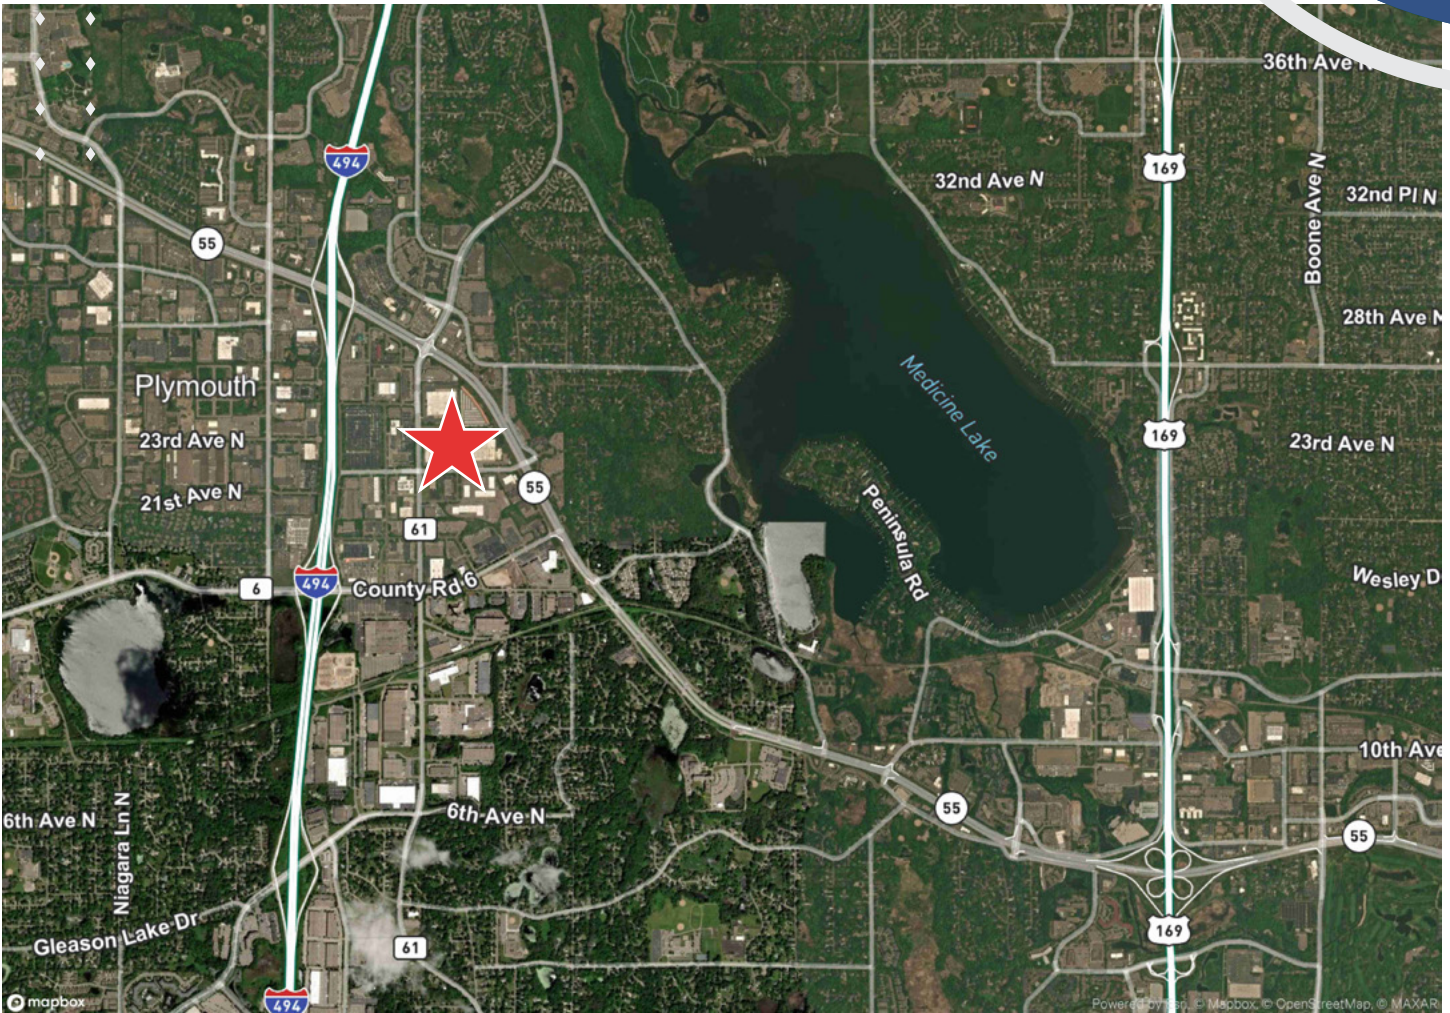

FOR SALE/LEASE

INDUSTRIAL PARK BUSINESS CENTER

13310 INDUSTRIAL PARK BLVD, PLYMOUTH, MN

CONTACT US

MATT OELSCHLAGER
+1 612 532 4747
matt.oelschlager@cbre.com

JOHN RYDEN
+1 612 723 9313
john.ryden@cbre.com

MIKE BOWEN
+1 612 597 8488
mike.bowen@cbre.com

JP MALONEY
+1 612 791 1171
jp.maloney@cbre.com



© 2025 CBRE, Inc. All rights reserved. This information has been obtained from sources believed reliable but has not been verified for accuracy or completeness. CBRE, Inc. makes no guarantee, representation or warranty and accepts no responsibility or liability as to the accuracy, completeness, or reliability of the information contained herein. You should conduct a careful, independent investigation of the property and verify all information. Any reliance on this information is solely at your own risk. CBRE and the CBRE logo are service marks of CBRE, Inc. All other marks displayed on this document are the property of their respective owners, and the use of such marks does not imply any affiliation with or endorsement of CBRE. Photos herein are the property of their respective owners. Use of these images without the express written consent of the owner is prohibited.