
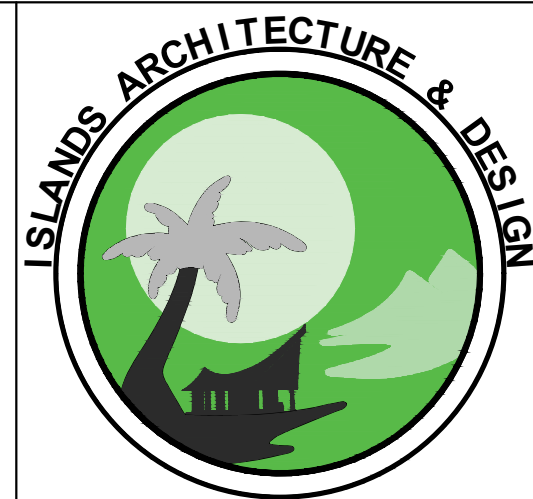


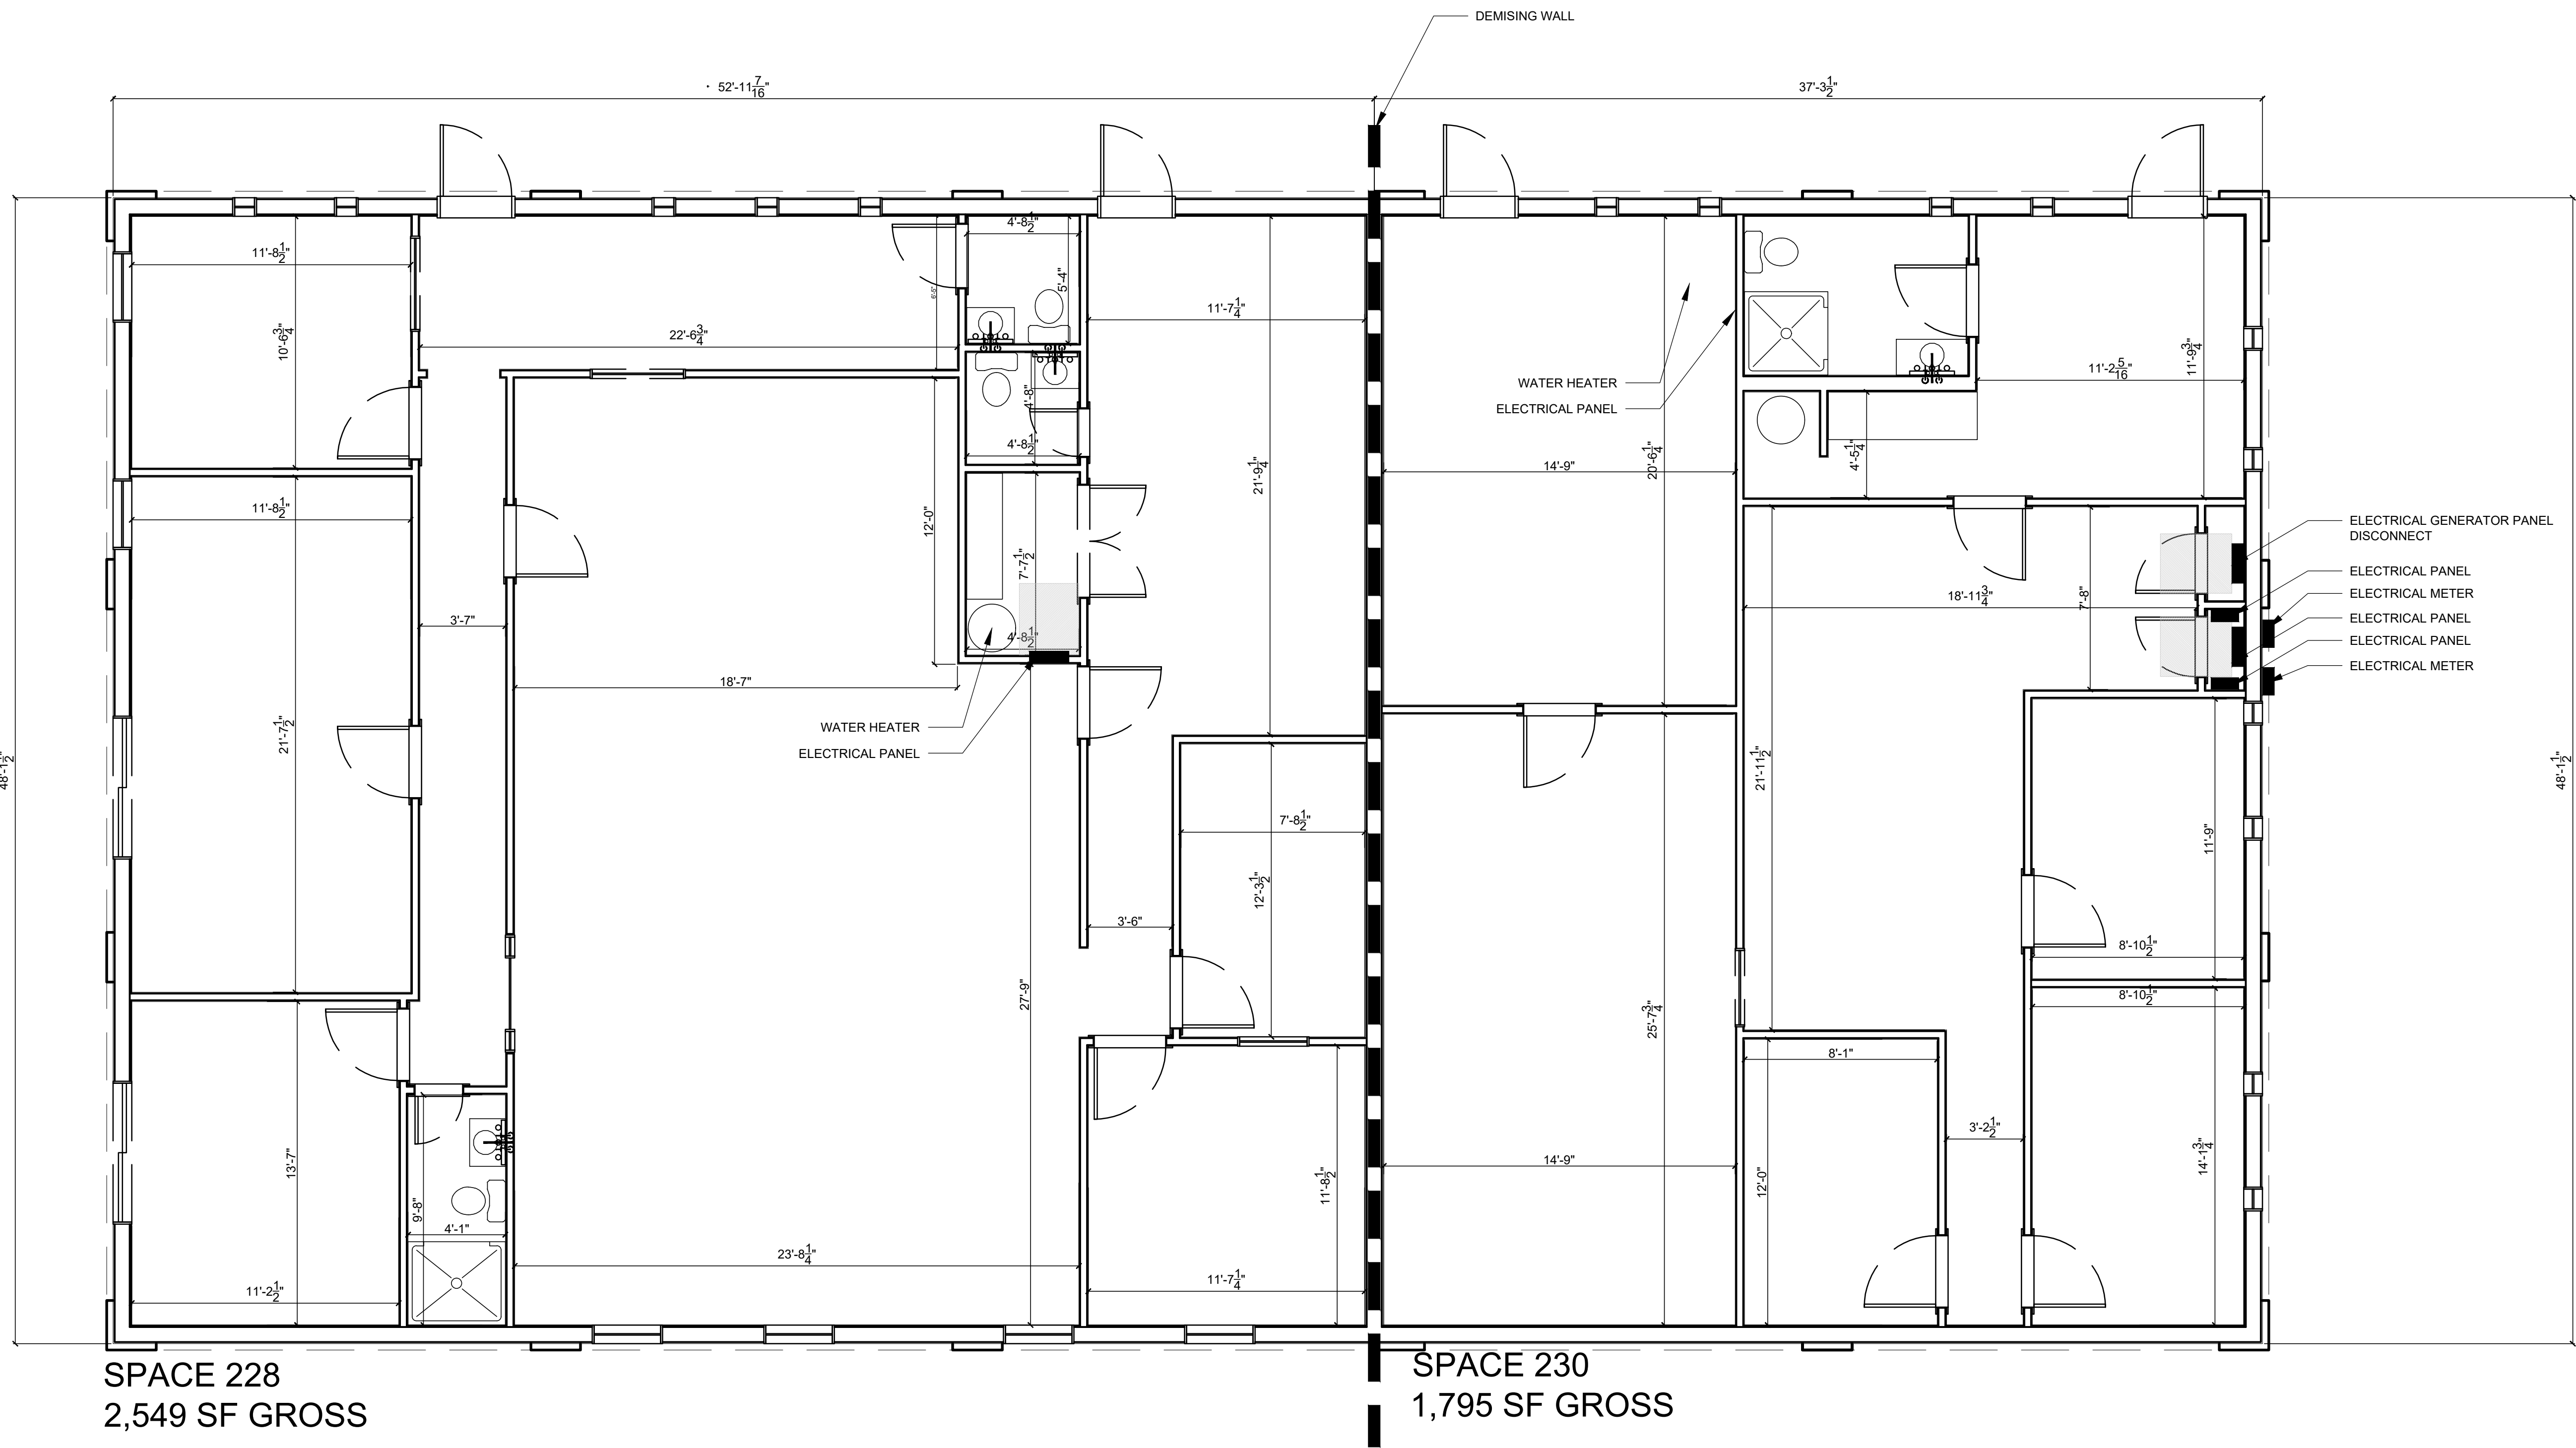

CLIENT
FRED POLLITT

SHEET TITLE
**AS-BUILT
PLAN**

AS-BUILT DOCUMENTATION
230 ARLINGTON RD N.,
JACKSONVILLE, FL 32211

NO.	BY	DATE	DESCRIPTION
0	JB	12.31.2025	AS-BUILT DOCUMENTS FOR SALES AND MARKETING
REVISIONS			

AS-BUILTS

CHECKED BY:	JMB
DRAWN BY:	JMB,JPB,SMB
ISSUE DATE:	12.31.2025

A001