 


BY	REVISED	#
		△
		△



**Law Office of
William R. Brenske**
630 S. 3rd St.
Las Vegas, NV 89101


AS-BUILT FLOOR PLAN

DATE: 08/20/2014
DRAWN BY:
SCALE: AS NOTED



SHEET
A1.00

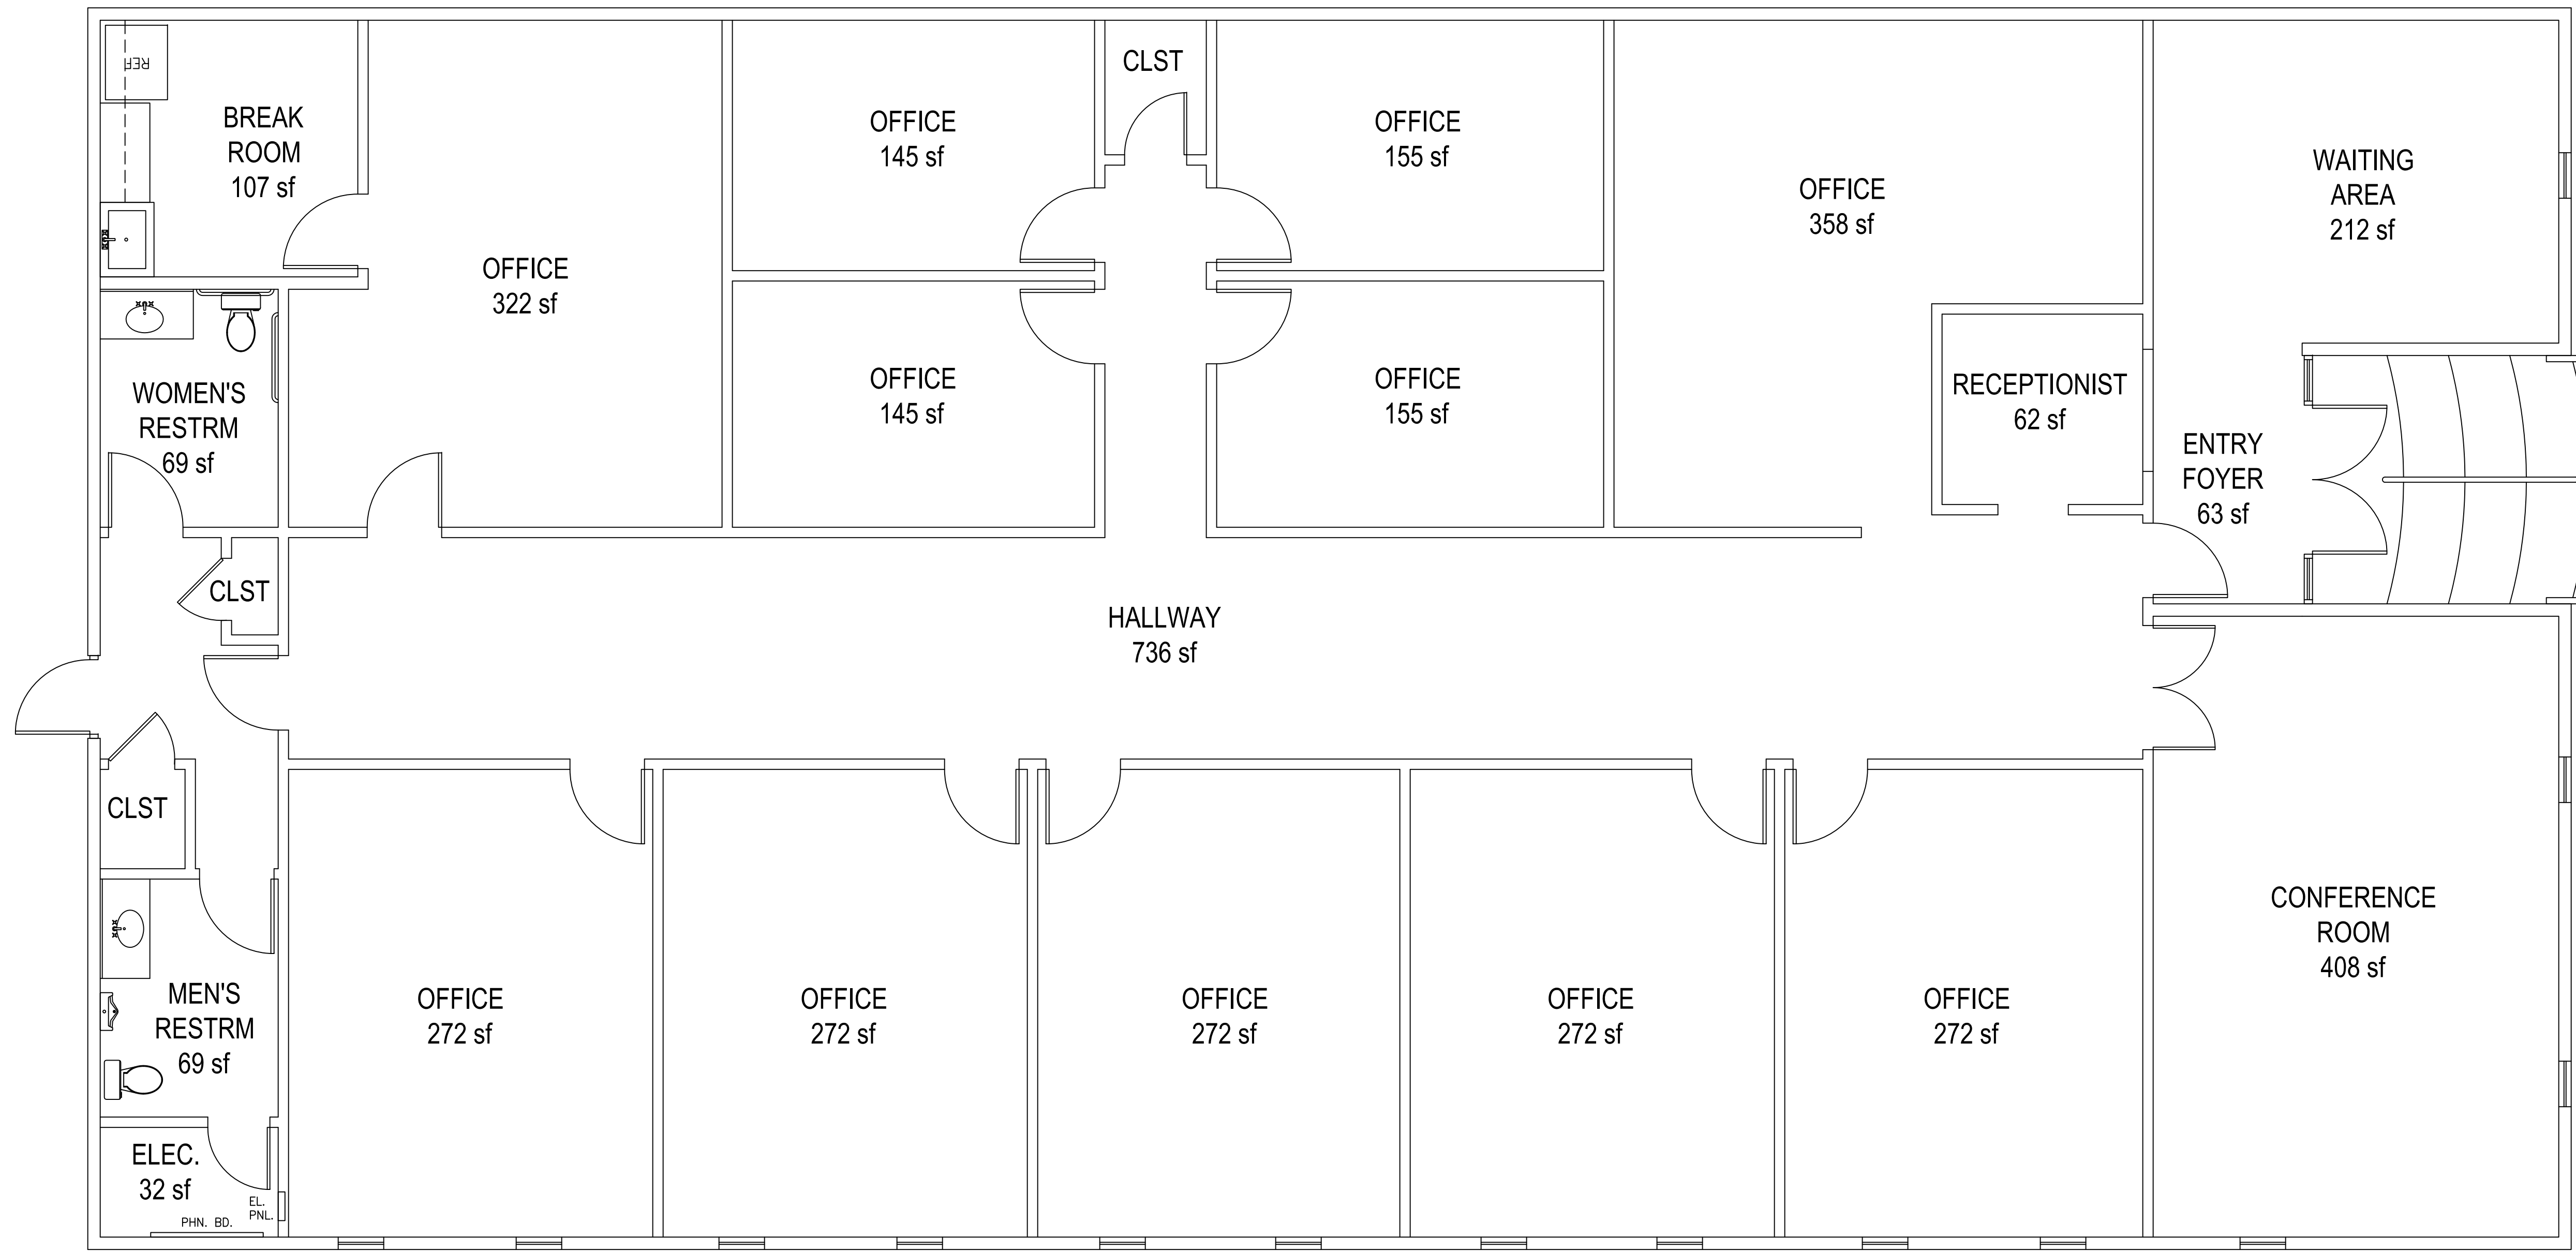

1 As-Built Floor Plan
A1.00 SCALE: 1/4" = 1'-0"

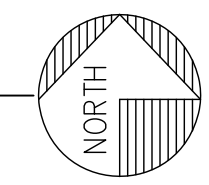


#	REVISED	BY
△		
△		
  

**Law Office of
William R. Brenske**
 630 S. 3rd St.
 Las Vegas, NV 89101
SITE PLAN

DATE: 08/20/2014
 DRAWN BY:
 SCALE: AS NOTED

SHEET
A2.00

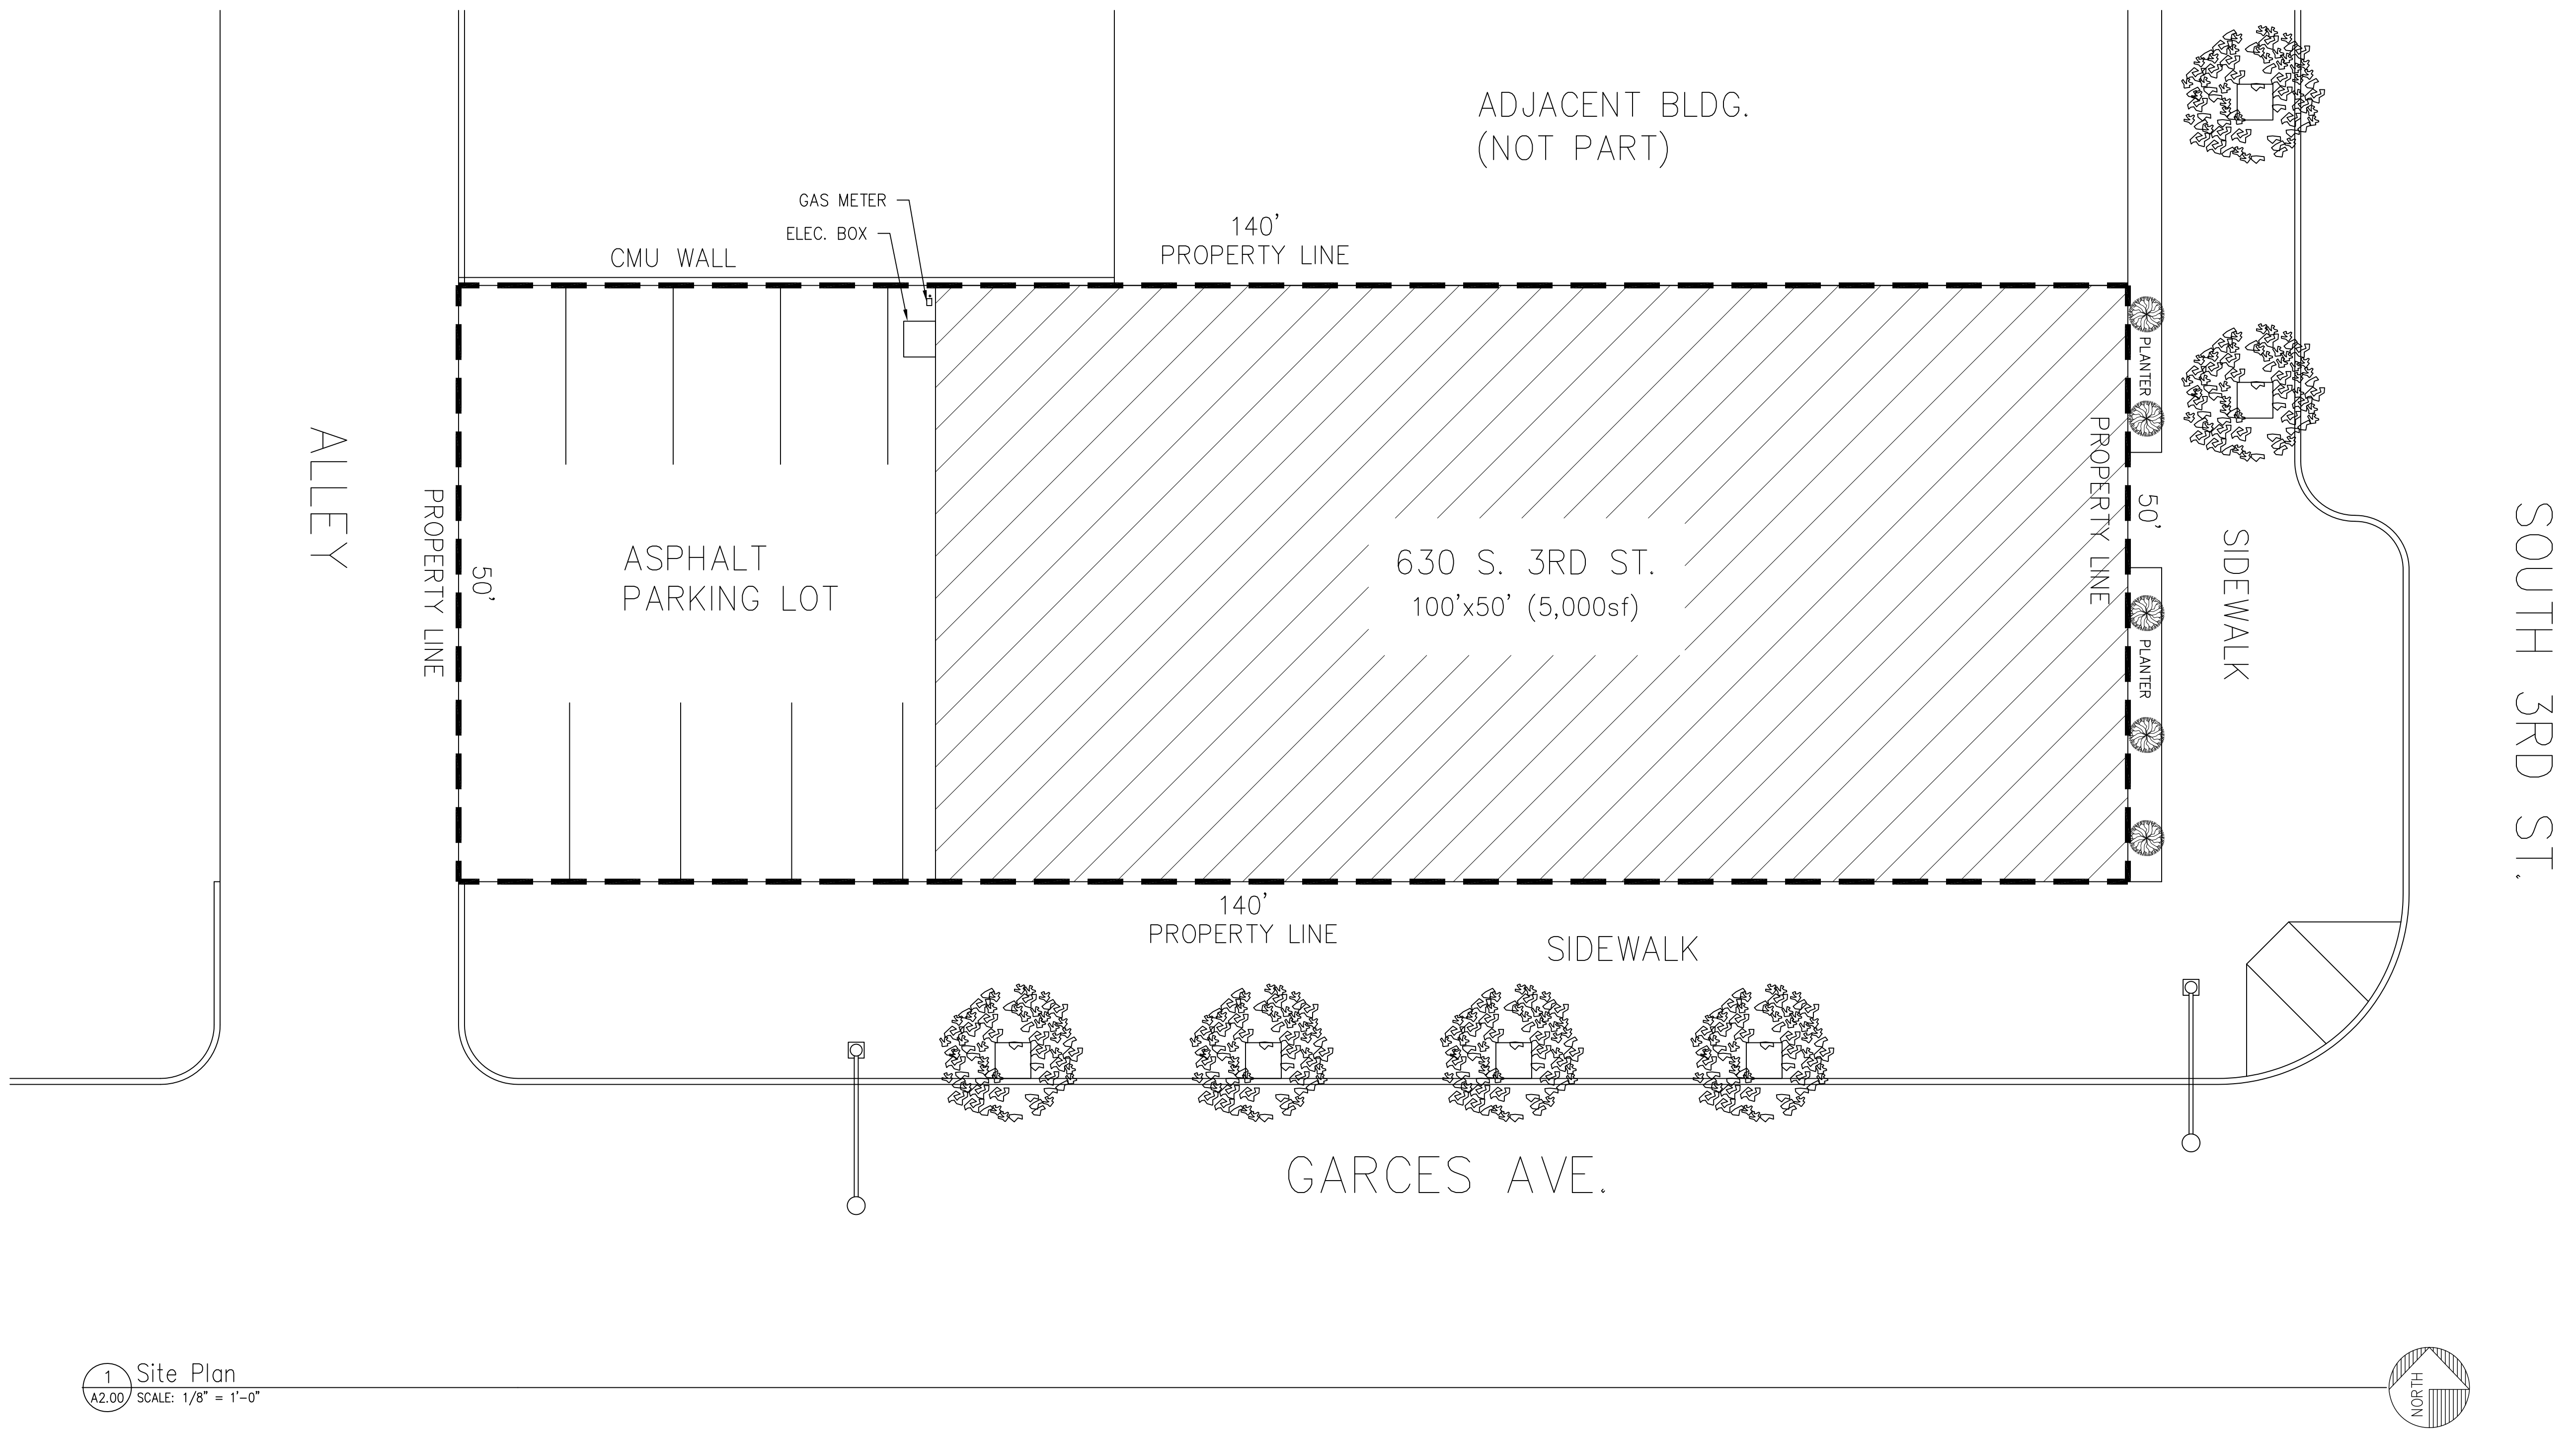

1 Site Plan
 A2.00 SCALE: 1/8" = 1'-0"