


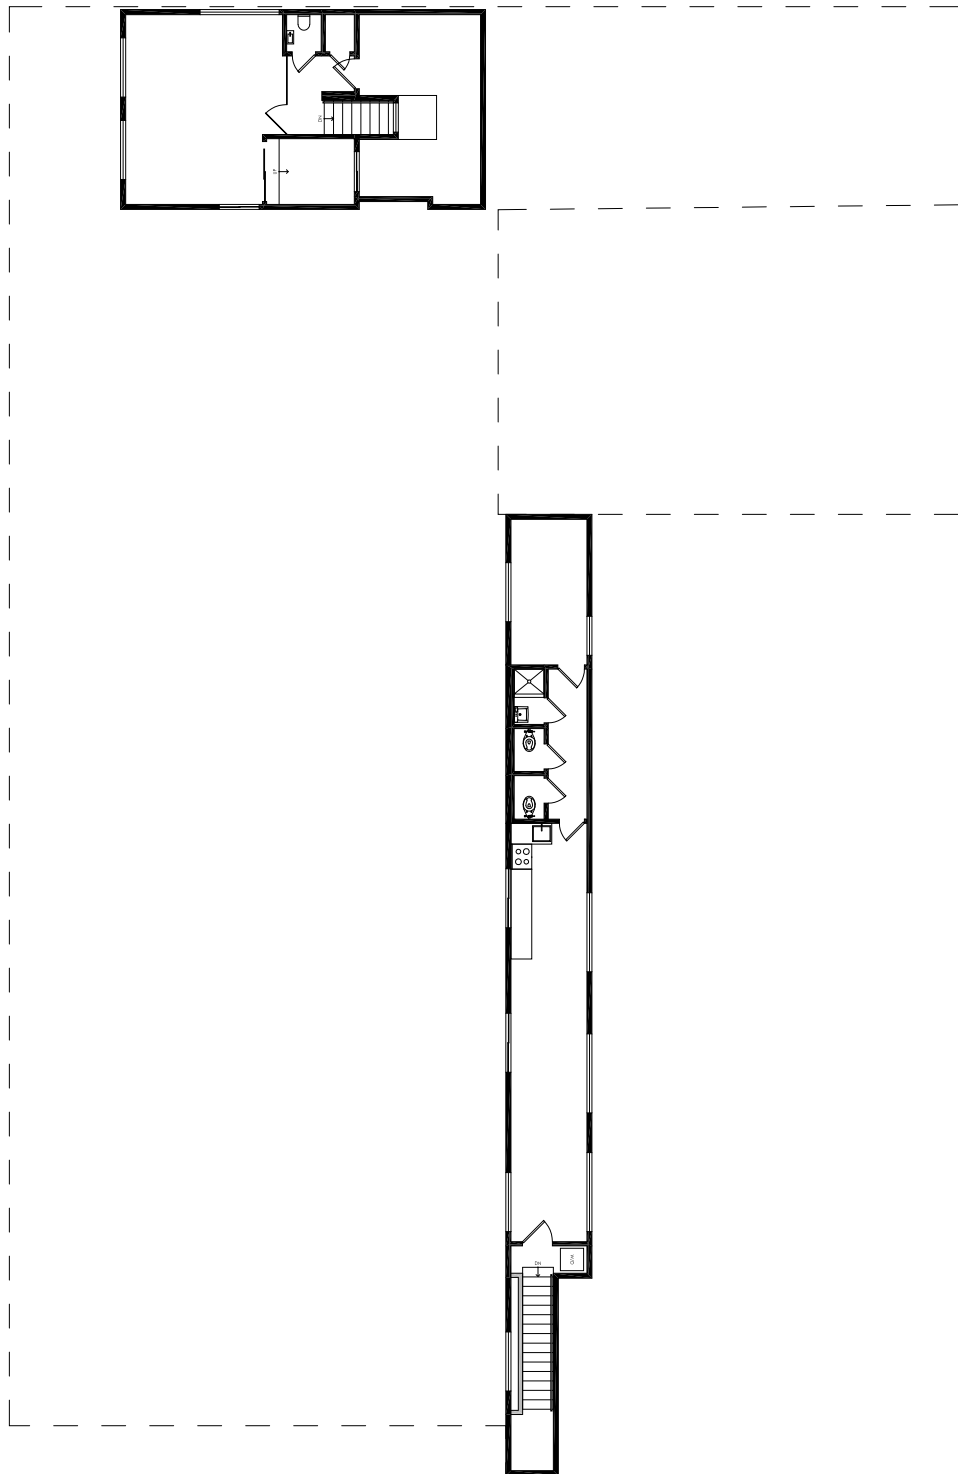

Danette Munir
architecture | interiors
227 South Madison Avenue, Suite 103
Pasadena, California 91101
almunir@gmail.com | p: 626.201.3082

1744 W.166th St.
GARDENA, CA 90247


Project 25-046

2nd FLOOR
AS-BUILT

AB.1-2

Date: 12.20.25

Scale: N.T.S.

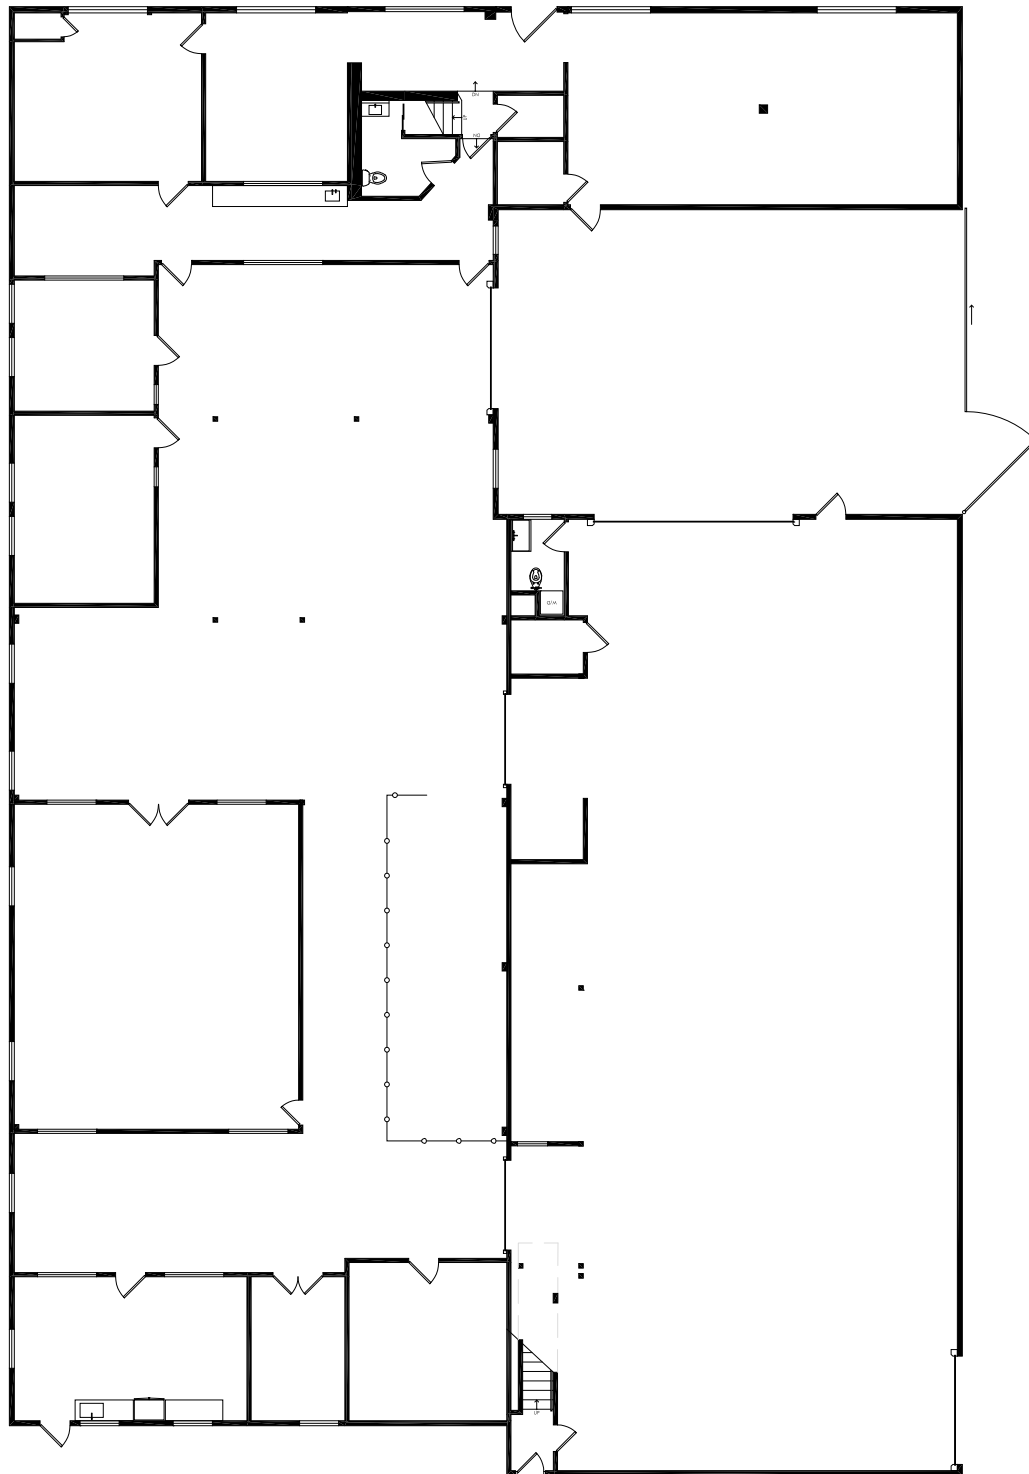

Danette Munir
architecture | interiors
227 South Madison Avenue, Suite 103
Pasadena, California 91101
almunir@gmail.com | p: 626.201.3082

1744 W.166th St.
GARDENA, CA 90247

Project 25-046

1st FLOOR
AS-BUILT

AB.1-1

Date: 12.20.25

Scale: N.T.S.



Danette Munir
architecture | interior
227 South Madison Avenue, Suite 103
Pasadena, California 91101
dmunir@gmail.com | p. 626.201.3082

Date	Issue
12.20.26	OWNER REVIEW

Self Issue Dates

1744 WEST 166th STREET

GARDENA, CALIFORNIA 90247

Project 25-046

No.	Date	Description

Sheet Revisions

Seal


PLAN WITH
DIMENSIONS

AB.2

Sheet Scale: 1/8" = 1'-0"



W. 166th ST.

S. HOBART BLVD.

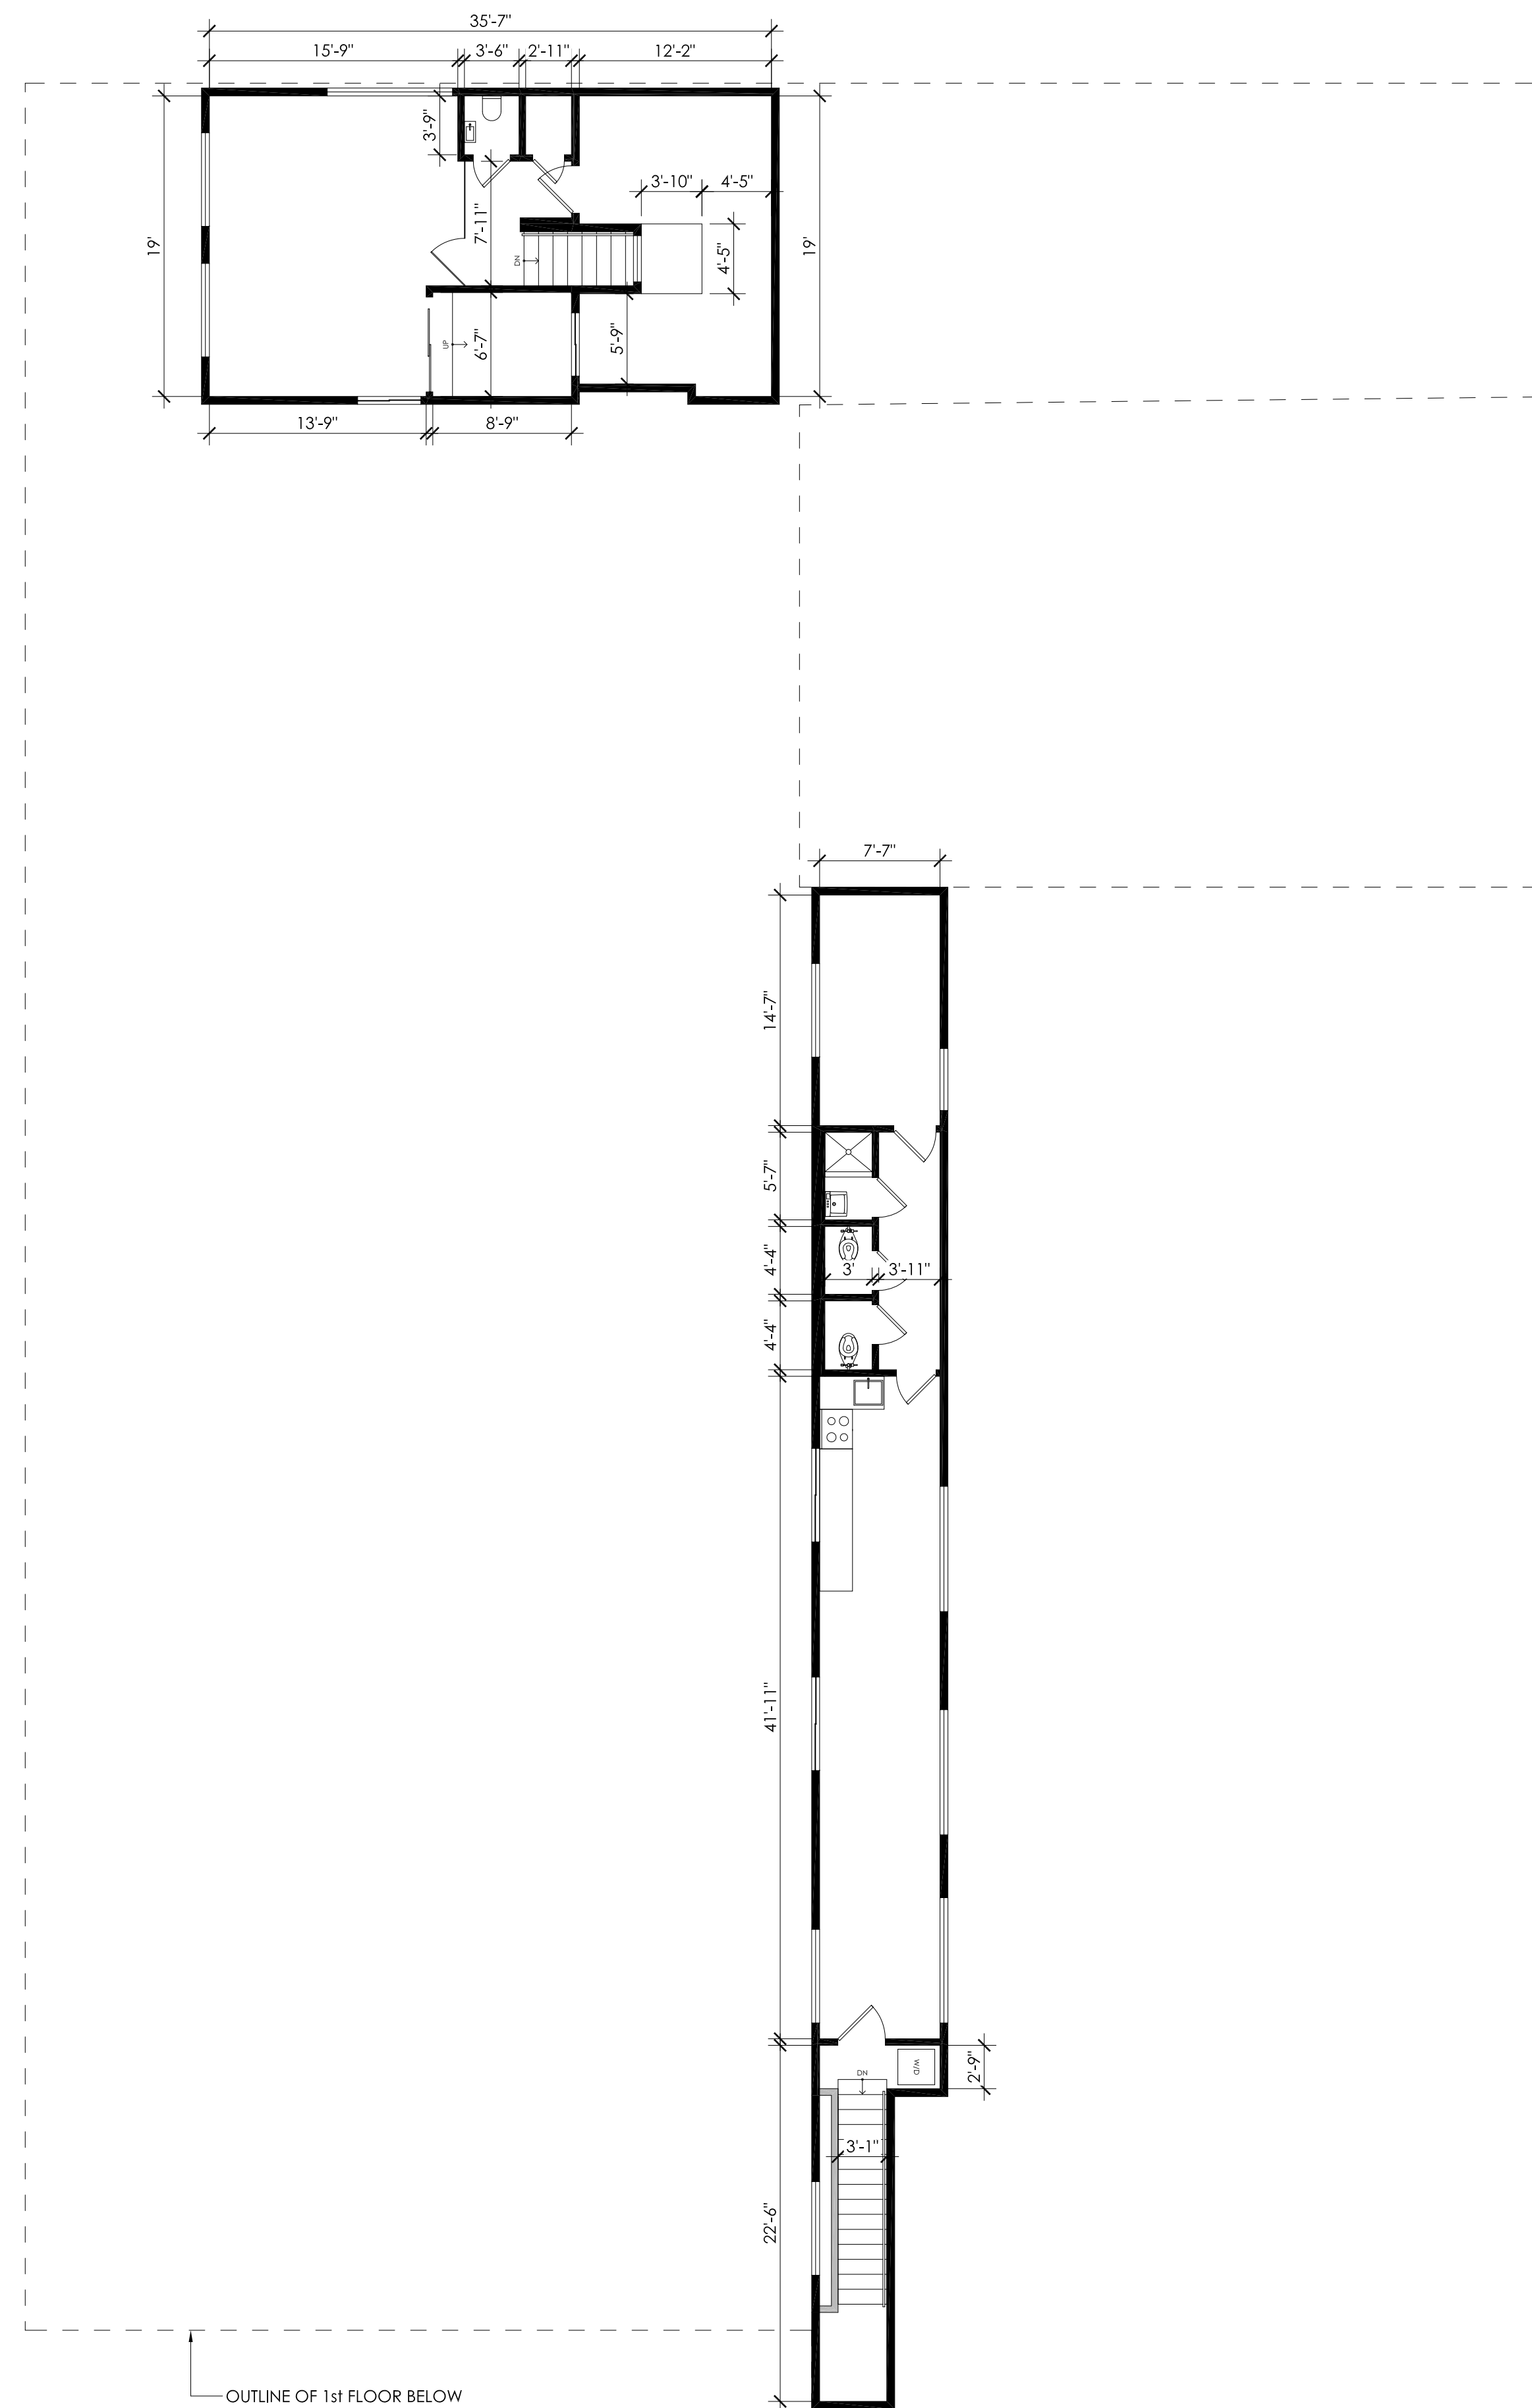

2nd FLOOR PLAN

1/8" = 1'-0"

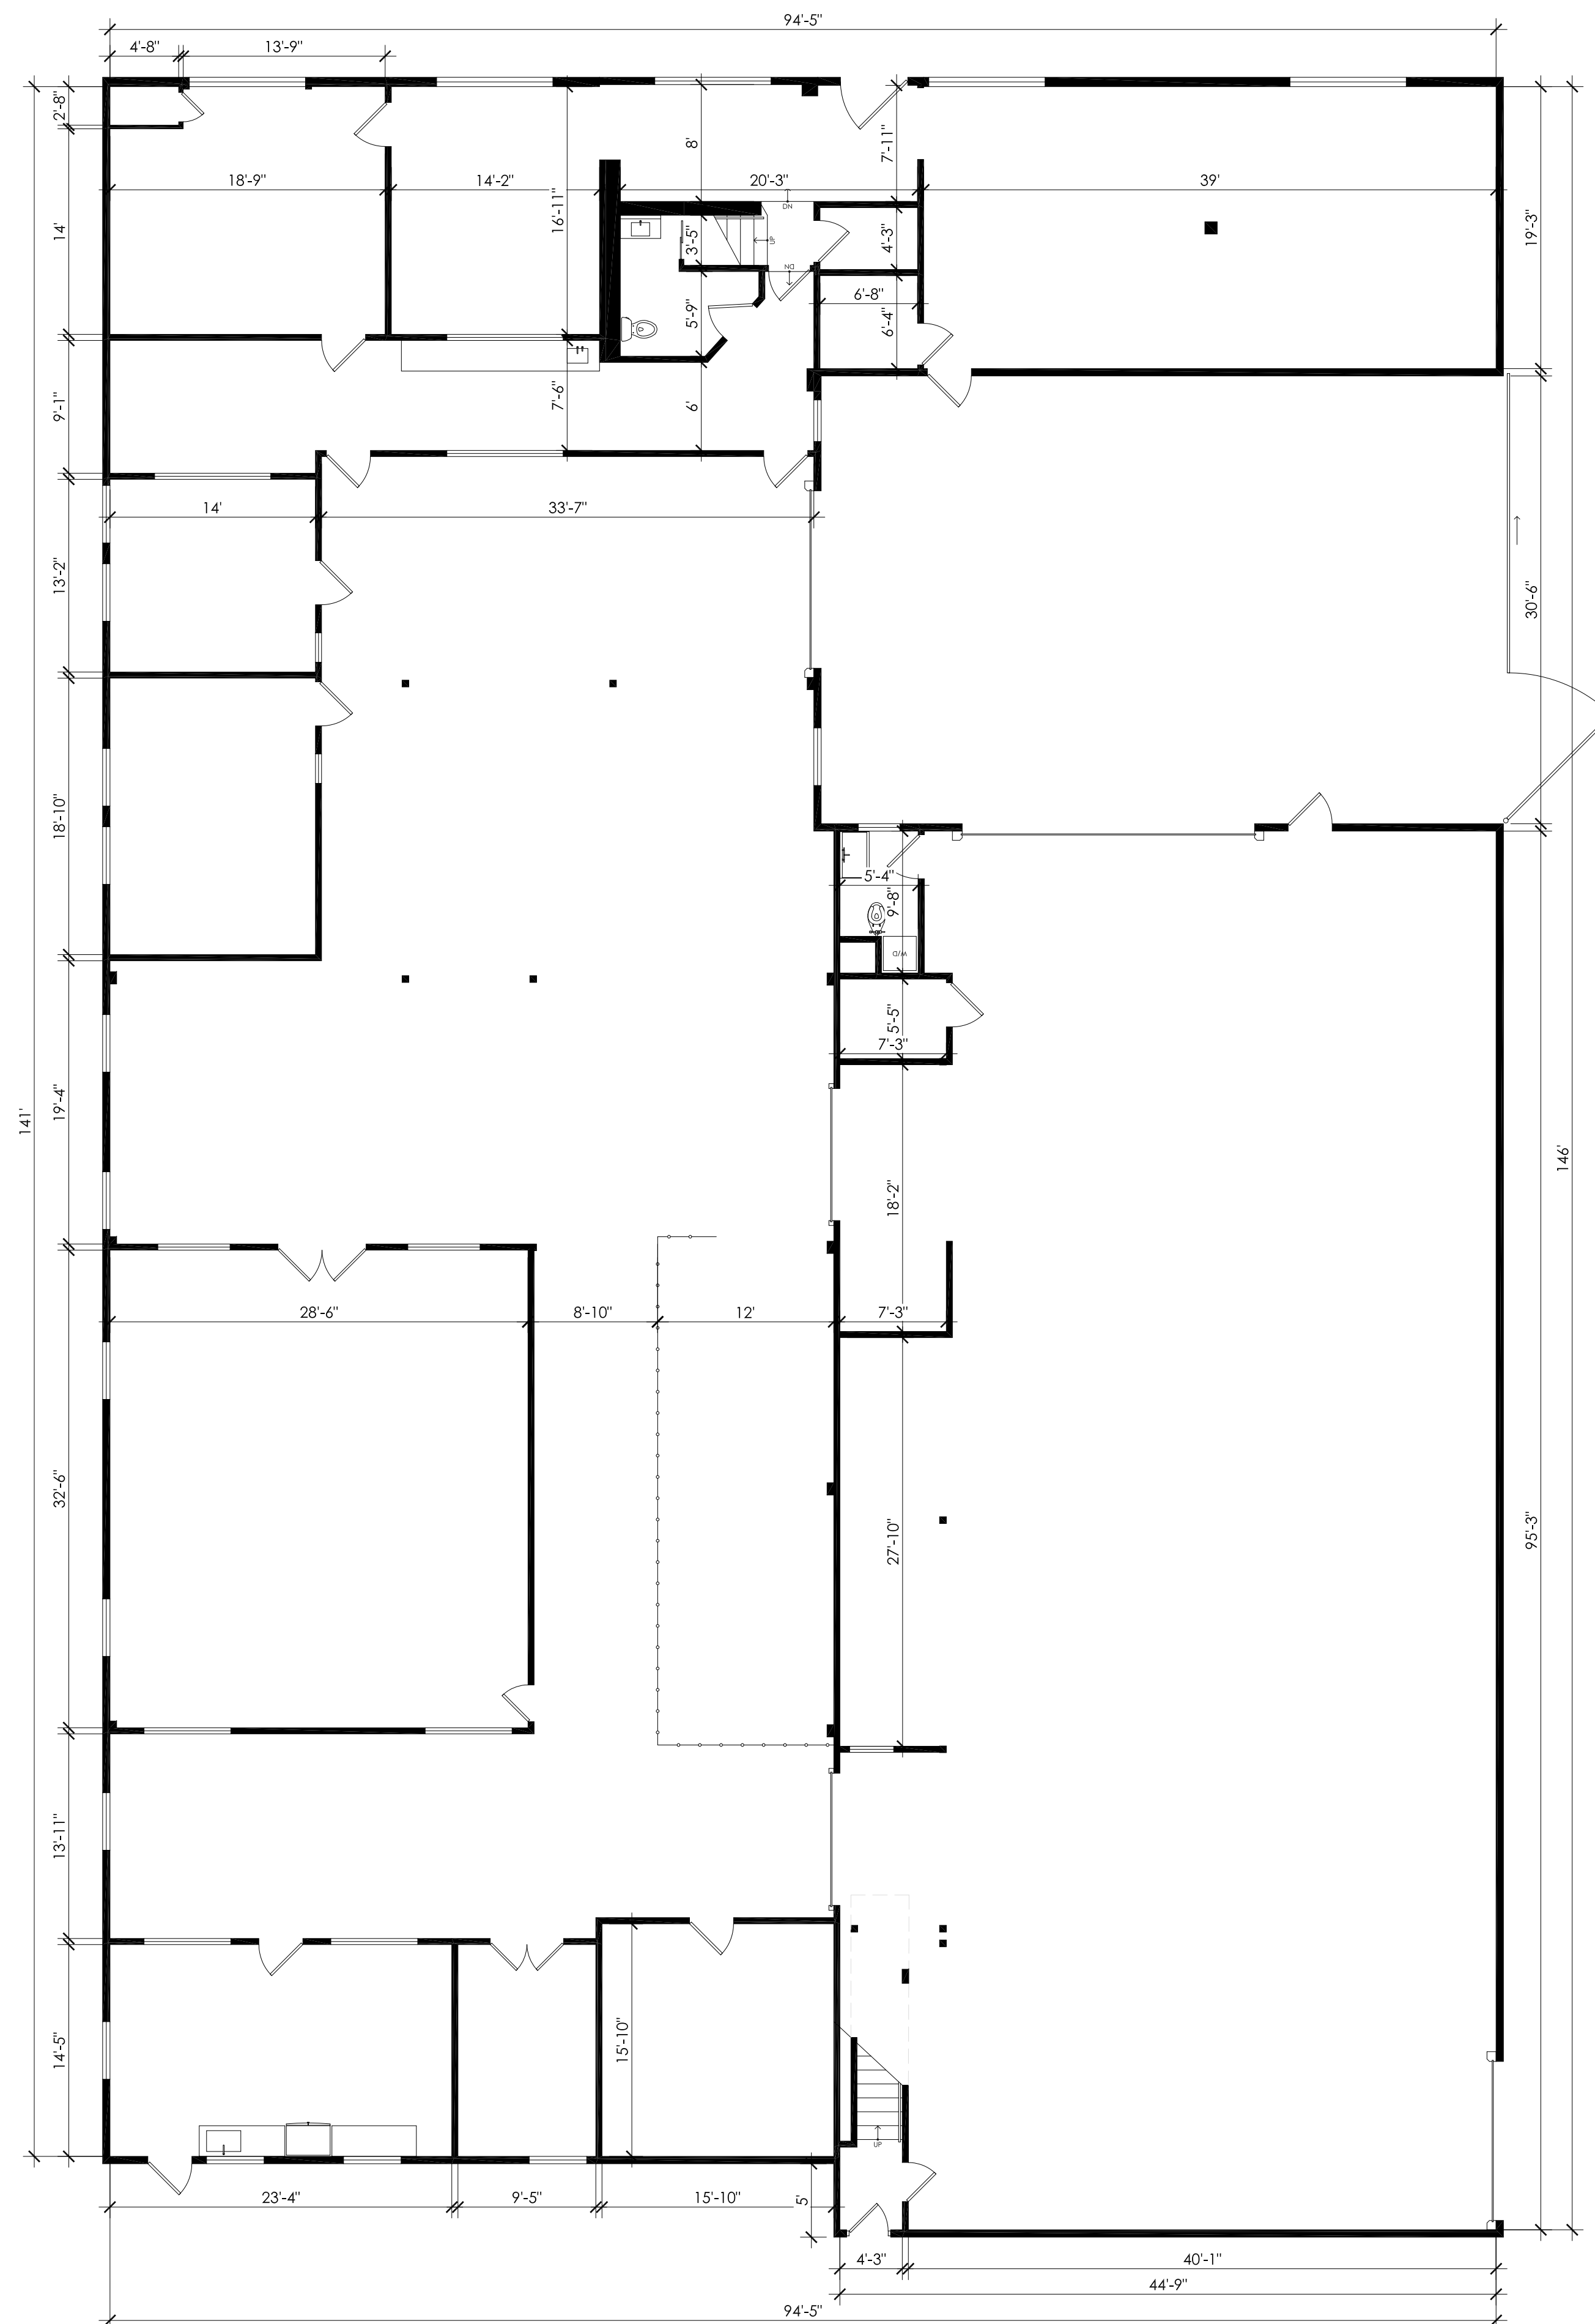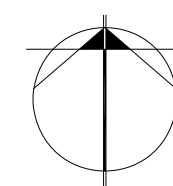

1st FLOOR PLAN

1/8" = 1'-0"

