

CLALLAM COUNTY DEPARTMENT OF COMMUNITY DEVELOPMENT
 DIVISION OF ENVIRONMENTAL HEALTH
 DIVISION OF ENVIRONMENTAL HEALTH
 223 EAST FOURTH STREET
 PORT ANGELES, WA 98362
 (360) 417-2332

ON-SITE SEWAGE CONSTRUCTION PERMIT

PRO-RENTALS

SEP - 95-0100

APPLICANT INFORMATION (Property Title Owner)*
 NAME: Priest & Ziegler
FIRST MI LAST
 CURRENT MAILING ADDRESS: P.O. Box 1205
 CITY: Port Angeles STATE: WA ZIP: 98362
 PHONE: (H) () (W) ()
 Denial or approval of an On-Site Sewage Disposal Permit may be appealed to the Health Officer within 15 days of the decision date.
 This permit expires 3 years from date of issuance.
 Any change in building or sewage disposal plans or location invalidates this permit unless prior approval is obtained from the Environmental Health Division and Certified Designer.
 I hereby acknowledge that I have read this application and state that the information supplied is correct. I agree to comply with all County and State laws regulating activities covered by this permit. No refund available after plan review completed.
 *Purchaser may also be listed here:
John N. Nove 3/30/95
APPLICANT SIGNATURE DATE
 Name: _____ Phone: _____
 Address: _____

PROJECT INFORMATION
 DIRECTIONS TO PROJECT SITE (from nearest County Road):
From Hwy 101 in Port Angeles go east of town to Pro Rentals located at 3368 East Highway 101
 PROJECT ADDRESS:
3368 East Highway 101 P.A.
 LOT SIZE 1.4 DSF ZONING C1 # BEDROOMS N/A
 WATER SYSTEM PUD #1
 PROJECT DESCRIPTION: (NEW EXPANSION REPAIR
New Drainfield for Proposed New Pro Rentals **DJS**

PLOT PLAN
 Draw a scaled or dimensioned plot plan of the proposed site. Include all applicable items listed in instructions.
 SCALE: 1" = _____
 NORTH
See Attached Site Plan

SITE REGISTRATION # 95-0062
 Designer: John N. Nove
 APPROVED: _____ DATE: 09-28-95
 DENIED: _____ DATE: _____
 Expiration: Date _____
 Installer: Pajimo
 FILED BY: _____ DATE: 10-16-96 Inspection () As Built

ELEVATIONS:
See Attached Site plan

SYSTEM TYPE AP
 COMMUNITY SYSTEM NAME: N/A
 NUMBER OF CONNECTIONS: N/A
 SYST USE: Comm
 GAL/DAY 250
 APP RATE 1.2
 TANK SIZE 1000
 DRAINFIELD Length 70'
 Width 3'
 Depth 21"
 Total Fees 280.00
 Date Received 3/31/95
 Receipt # 32381 Check # 1112
32384 79315-30.00

Priest & Ziegler

Parcel # 053007419080
 NEW 05-30-07-419110
 Subdiv/Plat M.P.C. Start Plat
 Vol 24 Page 48
 Lot 1
 BK/DIV

CLALLAM COUNTY DEPARTMENT OF COMMUNITY DEVELOPMENT
 DIVISION OF ENVIRONMENTAL HEALTH
SITE REGISTRATION

DIVISION OF ENVIRONMENTAL HEALTH
 223 EAST FOURTH STREET
 PORT ANOBLIS, WA 98362
 (360) 417-2332

SR# 95-0062

APPLICANT INFORMATION (Property Title Owner)*

NAME: Priest & Ziegler
FIRST MI LAST
 CURRENT MAILING ADDRESS: P.O. Box 1205
 CITY Port Angeles STATE WA ZIP 98362
 PHONE: (H) () (W) ()
 FEES 200.00 RECEIPT # 32381 DATE 3-31-95
1118

*The purpose of this evaluation is to provide the applicant with information as to whether or not a piece of property will generally support an on-site sewage disposal system. In no way should this form be used in lieu of nor does it constitute an on-site sewage disposal permit. The site/soils will be evaluated using regulations in effect at the time of this evaluation. If changes occur in the State or Local regulations governing on-site sewage disposal systems requirements, they will be enforced at the time of application for an on-site sewage disposal permit. No refund available after site work performed.

Jerry Newlin 3/30/95
 APPLICANT DATE

PROJECT INFORMATION

DIRECTIONS TO PROJECT SITE (from nearest County Road):

Go east of Port Angeles on Hwy 101 to the Pro Rentals shop located at 3368 East Highway 101

PROJECT ADDRESS:

3368 East Highway 101

LOT SIZE 1.4 ACRES ZONING C1

WATER SYSTEM PL/D#1

PROJECT DESCRIPTION: New Drain Field For new proposed Pro Rentals

DJS

NORTH
 SCALE: 1" = _____

PLOT PLAN

Draw a scaled or dimensioned plot plan of the proposed site. Include all applicable items listed in instructions.

See Attached Site Plan

SOIL/LOG COMMENTS:

ELEVATIONS:

1A 0-2" Concrete pavement
 2-10" M.C. S.L.
 10-19" Loamy Sand
 19-34" med. Sand & Gravel
 34-59" Compact Silt Loam

Z A
 0-2" Concrete Pavement
 2-51" G.S.L.
 51-96" Gravely medium sand
 Roots to 55"

Priest & Ziegler

The undersigned Clallam County Health Department representative has witnessed the following soil logs and finds them to be accurately represented. It appears that this site is capable of supporting an on-site sewage disposal system for a single family residence meeting all current Clallam County Health department policies and regulations, subject to any of the above comments and restrictions. (Any person may appeal this decision in writing within (10) days of the date of this decision.)

Note: Changes to this site, such as grading, cuts, filling, or clearing could make this certification NULL and VOID.


SITE VERIFICATION CONDITIONS
 Sanitarian: [Signature] Date 04-28-95 A.P.
 Designer: Jerry Newlin Date 3/30/95

Parcel # 053007419080

Subdiv/Plat M.P.C. Short Plat

Vol. 10 Page 66 Lot 1

BLK/DIV

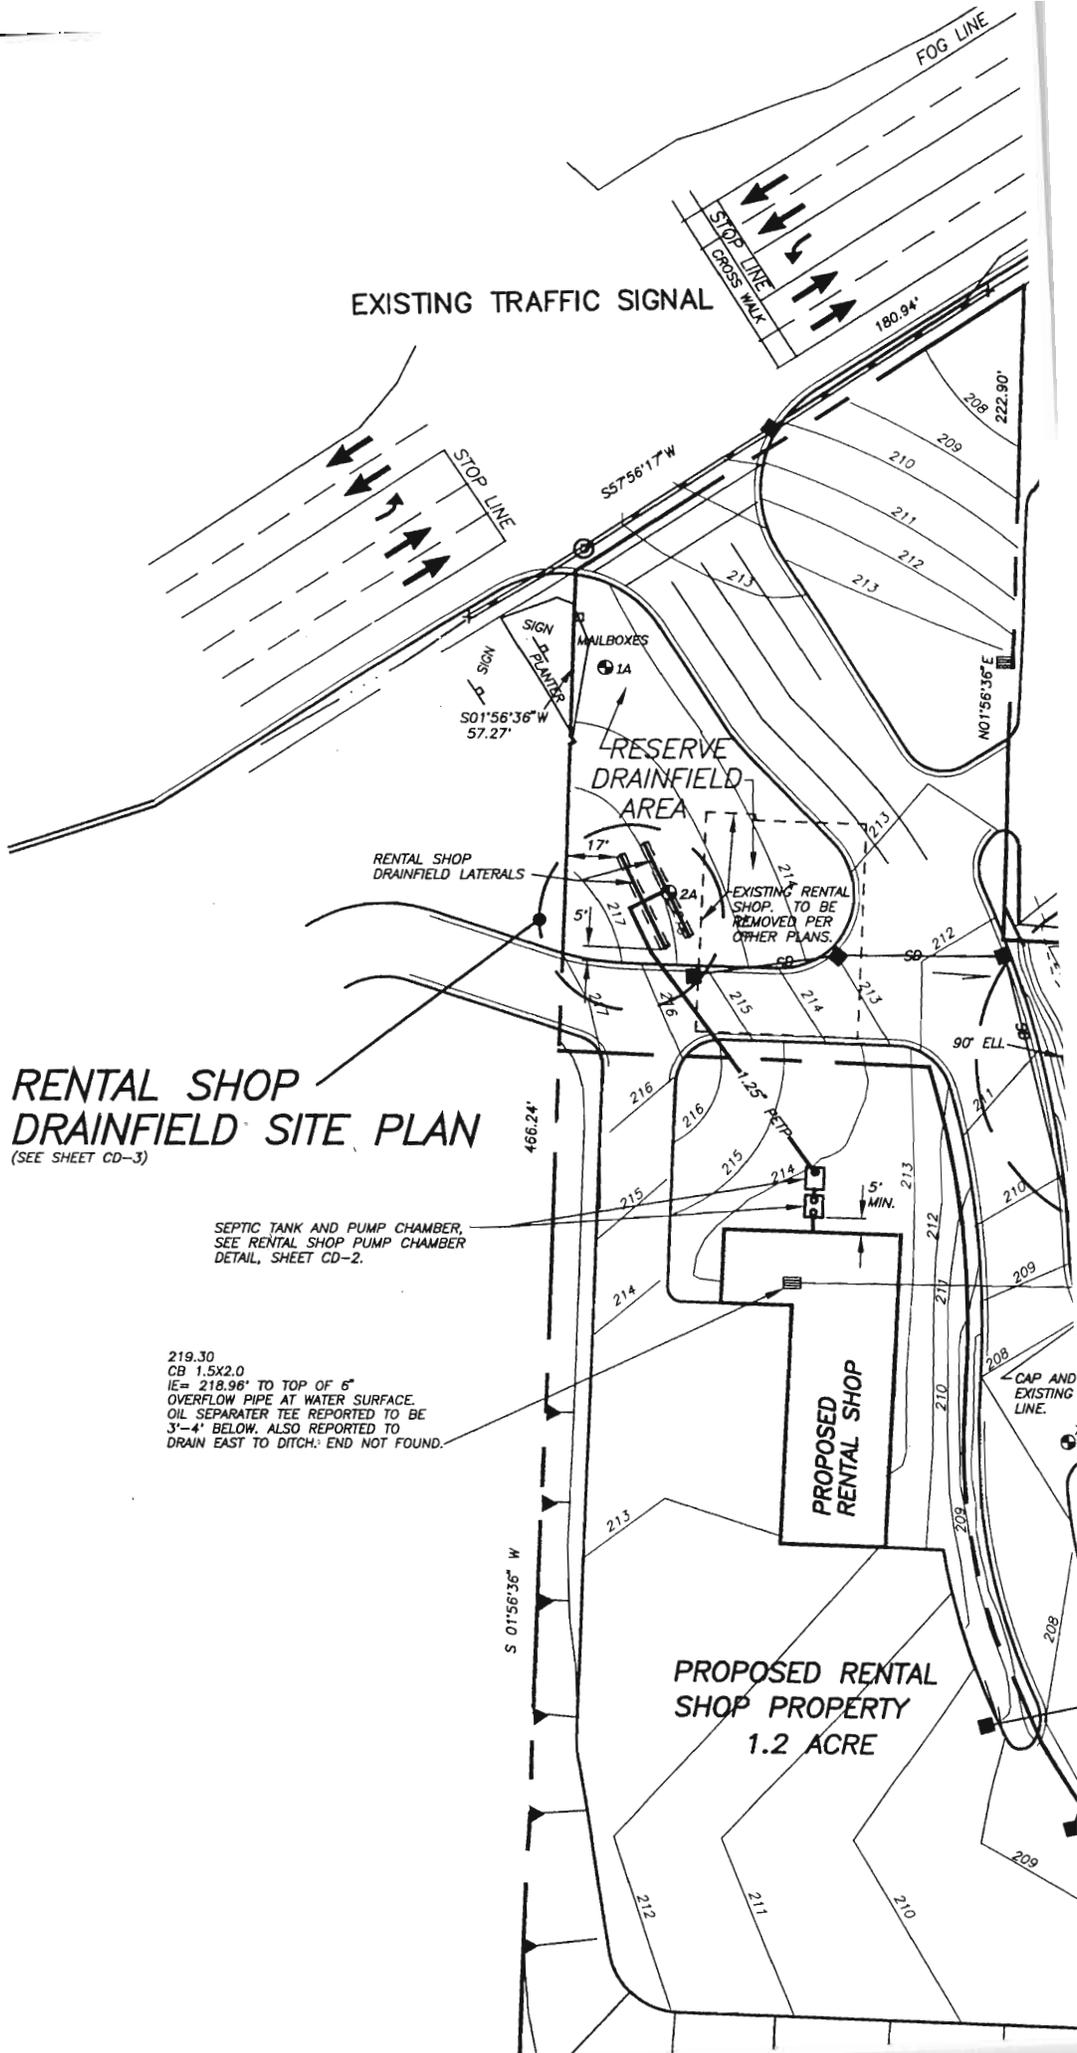

**RENTAL SHOP
DRAINFIELD SITE PLAN**
(SEE SHEET CD-3)

SEPTIC TANK AND PUMP CHAMBER,
SEE RENTAL SHOP PUMP CHAMBER
DETAIL, SHEET CD-2.

219.30
CB 1.5X2.0
IE= 218.96' TO TOP OF 6"
OVERFLOW PIPE AT WATER SURFACE.
OIL SEPARATOR TEE REPORTED TO BE
3'-4' BELOW. ALSO REPORTED TO
DRAIN EAST TO DITCH. END NOT FOUND.

**PROPOSED RENTAL SHOP
PROPERTY
1.2 ACRE**