

© 2023 Treat Architects, Inc.

ISSUED:
8/1/23

REVISIONS:
1 12/12/23 As-built edits

4404 COBBLERS LANE
DALLAS, TEXAS 75287
972-333-3617
btreat@svbdfirm.net




Proposed Alterations to Interiors
HR Industrial Park
SEC F.M. Hwy. No. 1417 & Heironimus Ln.
7350 N FM Hwy. 1417, Denison, Texas 75020

DRAWN: BT CHECKED: BT


JOB NO: 2023-06-28

TITLE
Suite 101
Floor, Power,
& Lighting
As-Built Plan

SHEET
A1
Sheet 1 of 1

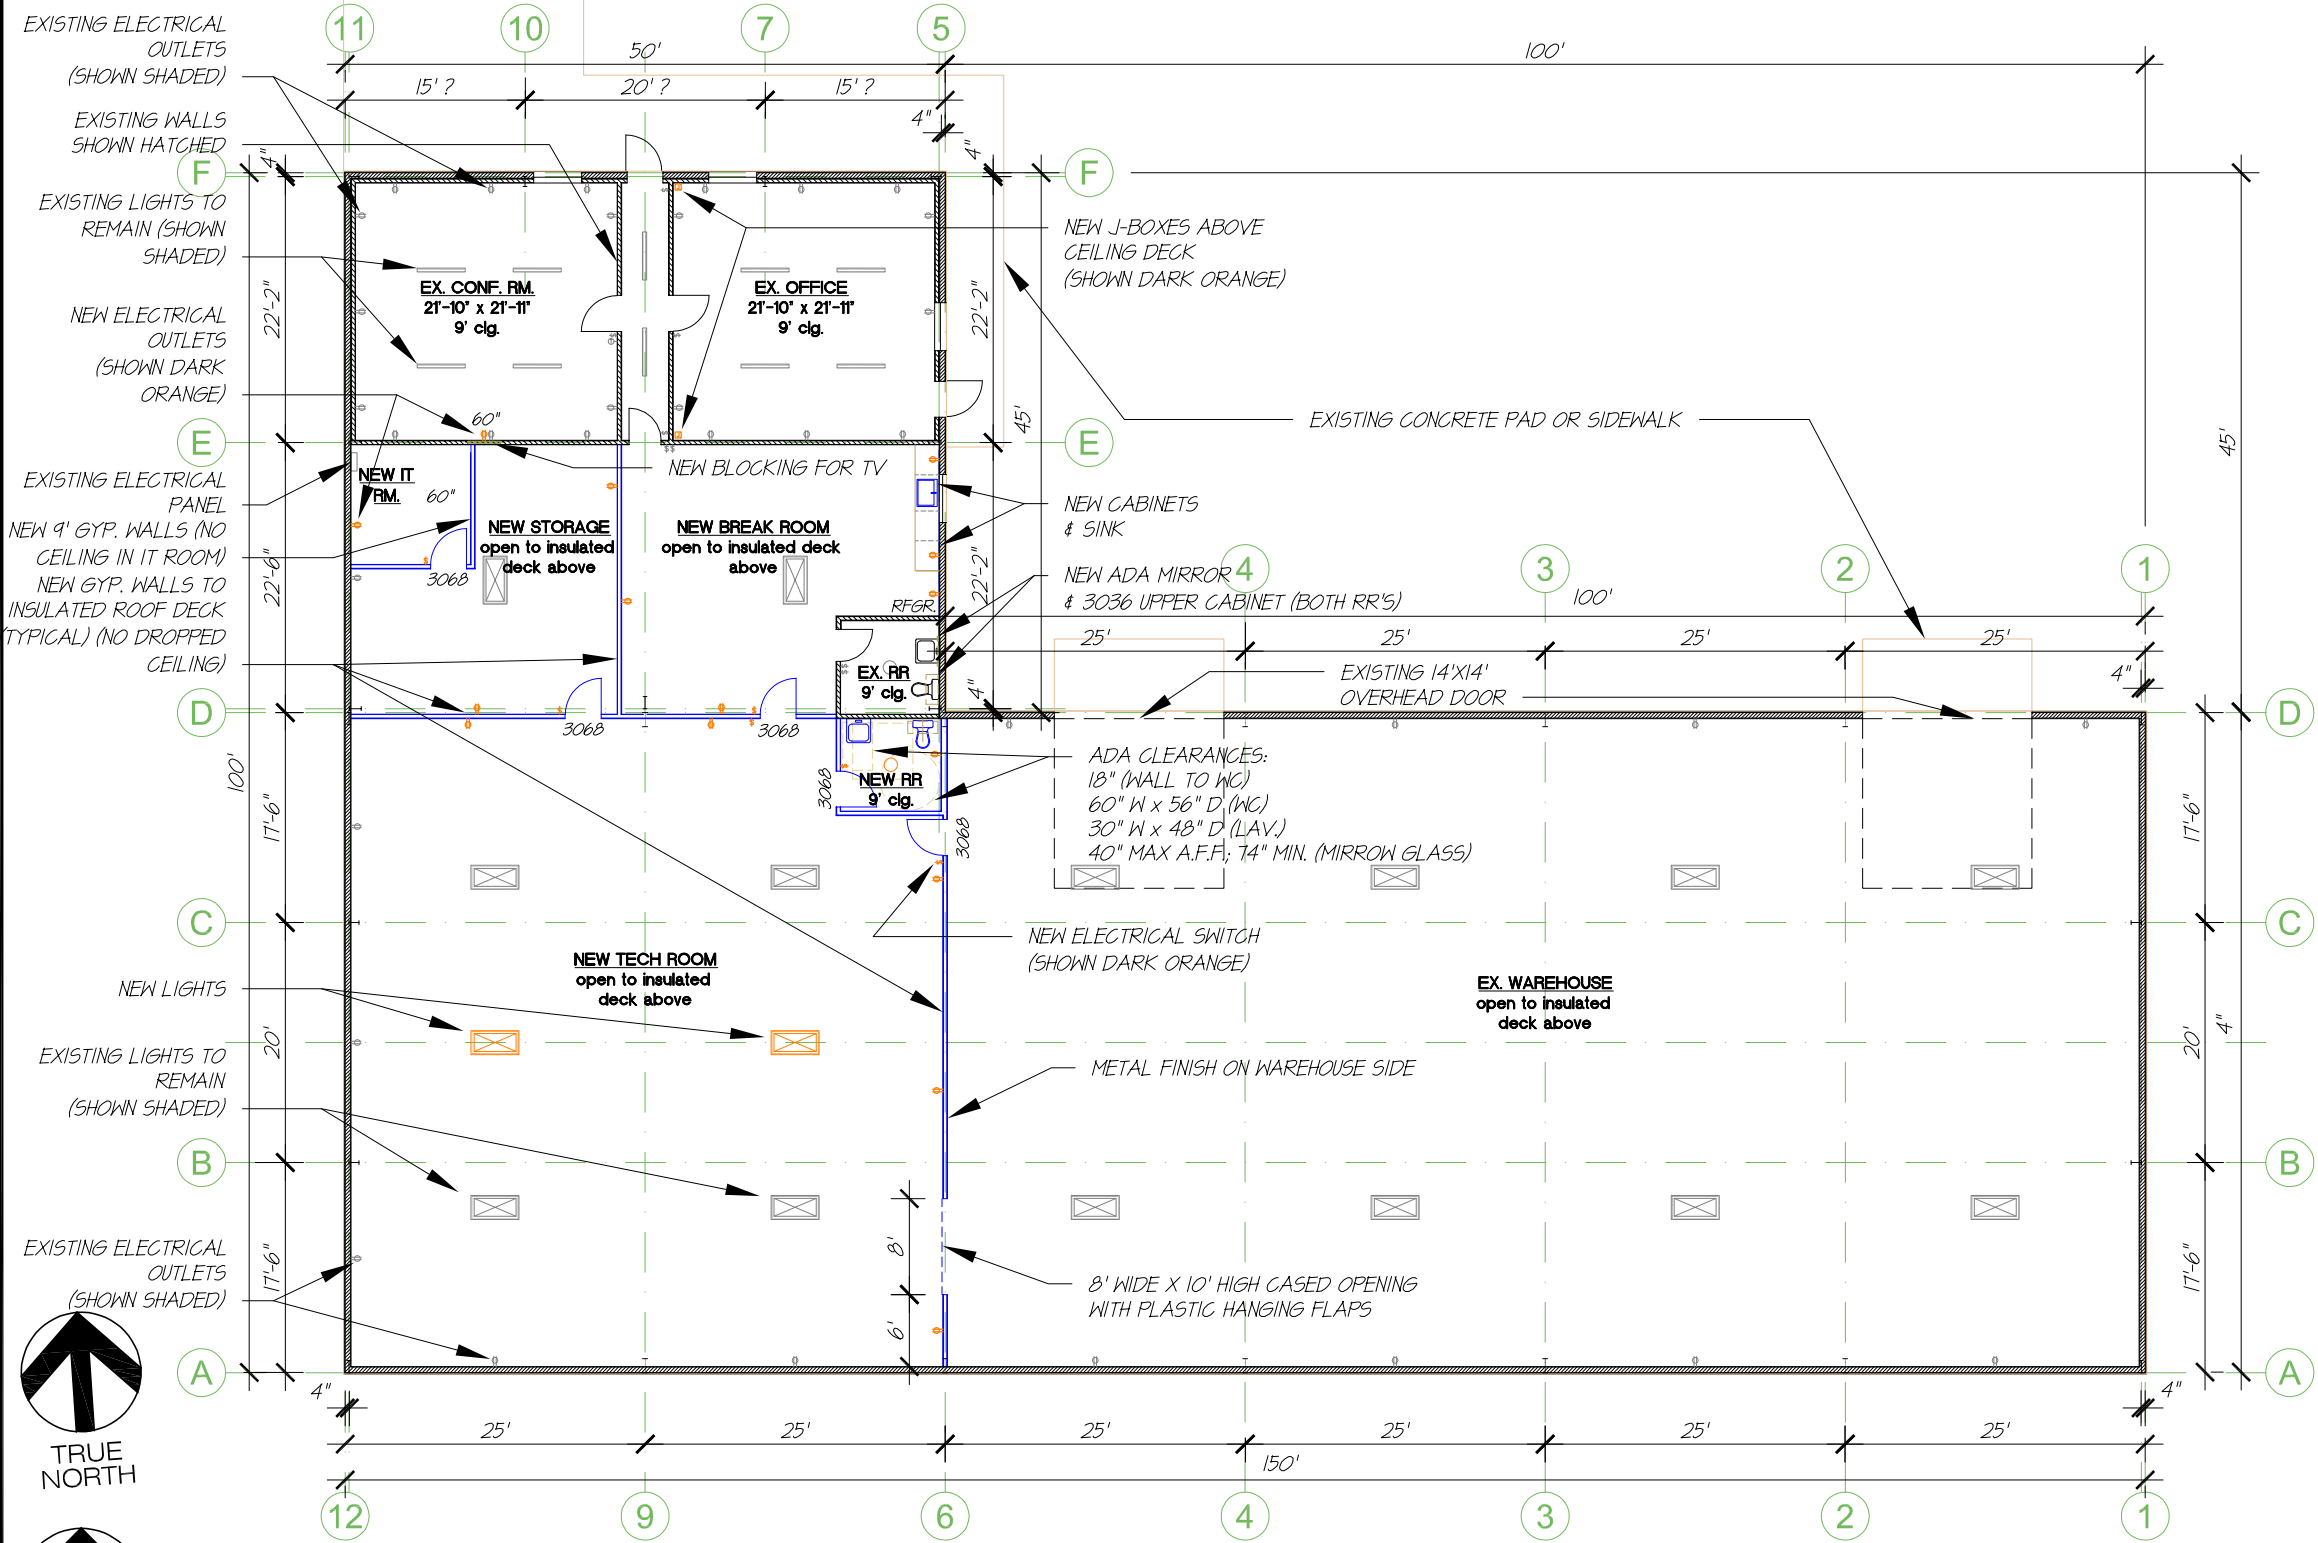

SUITE 101 - FLOOR PLAN

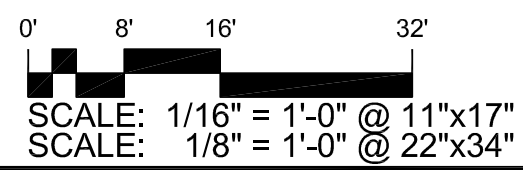

1