



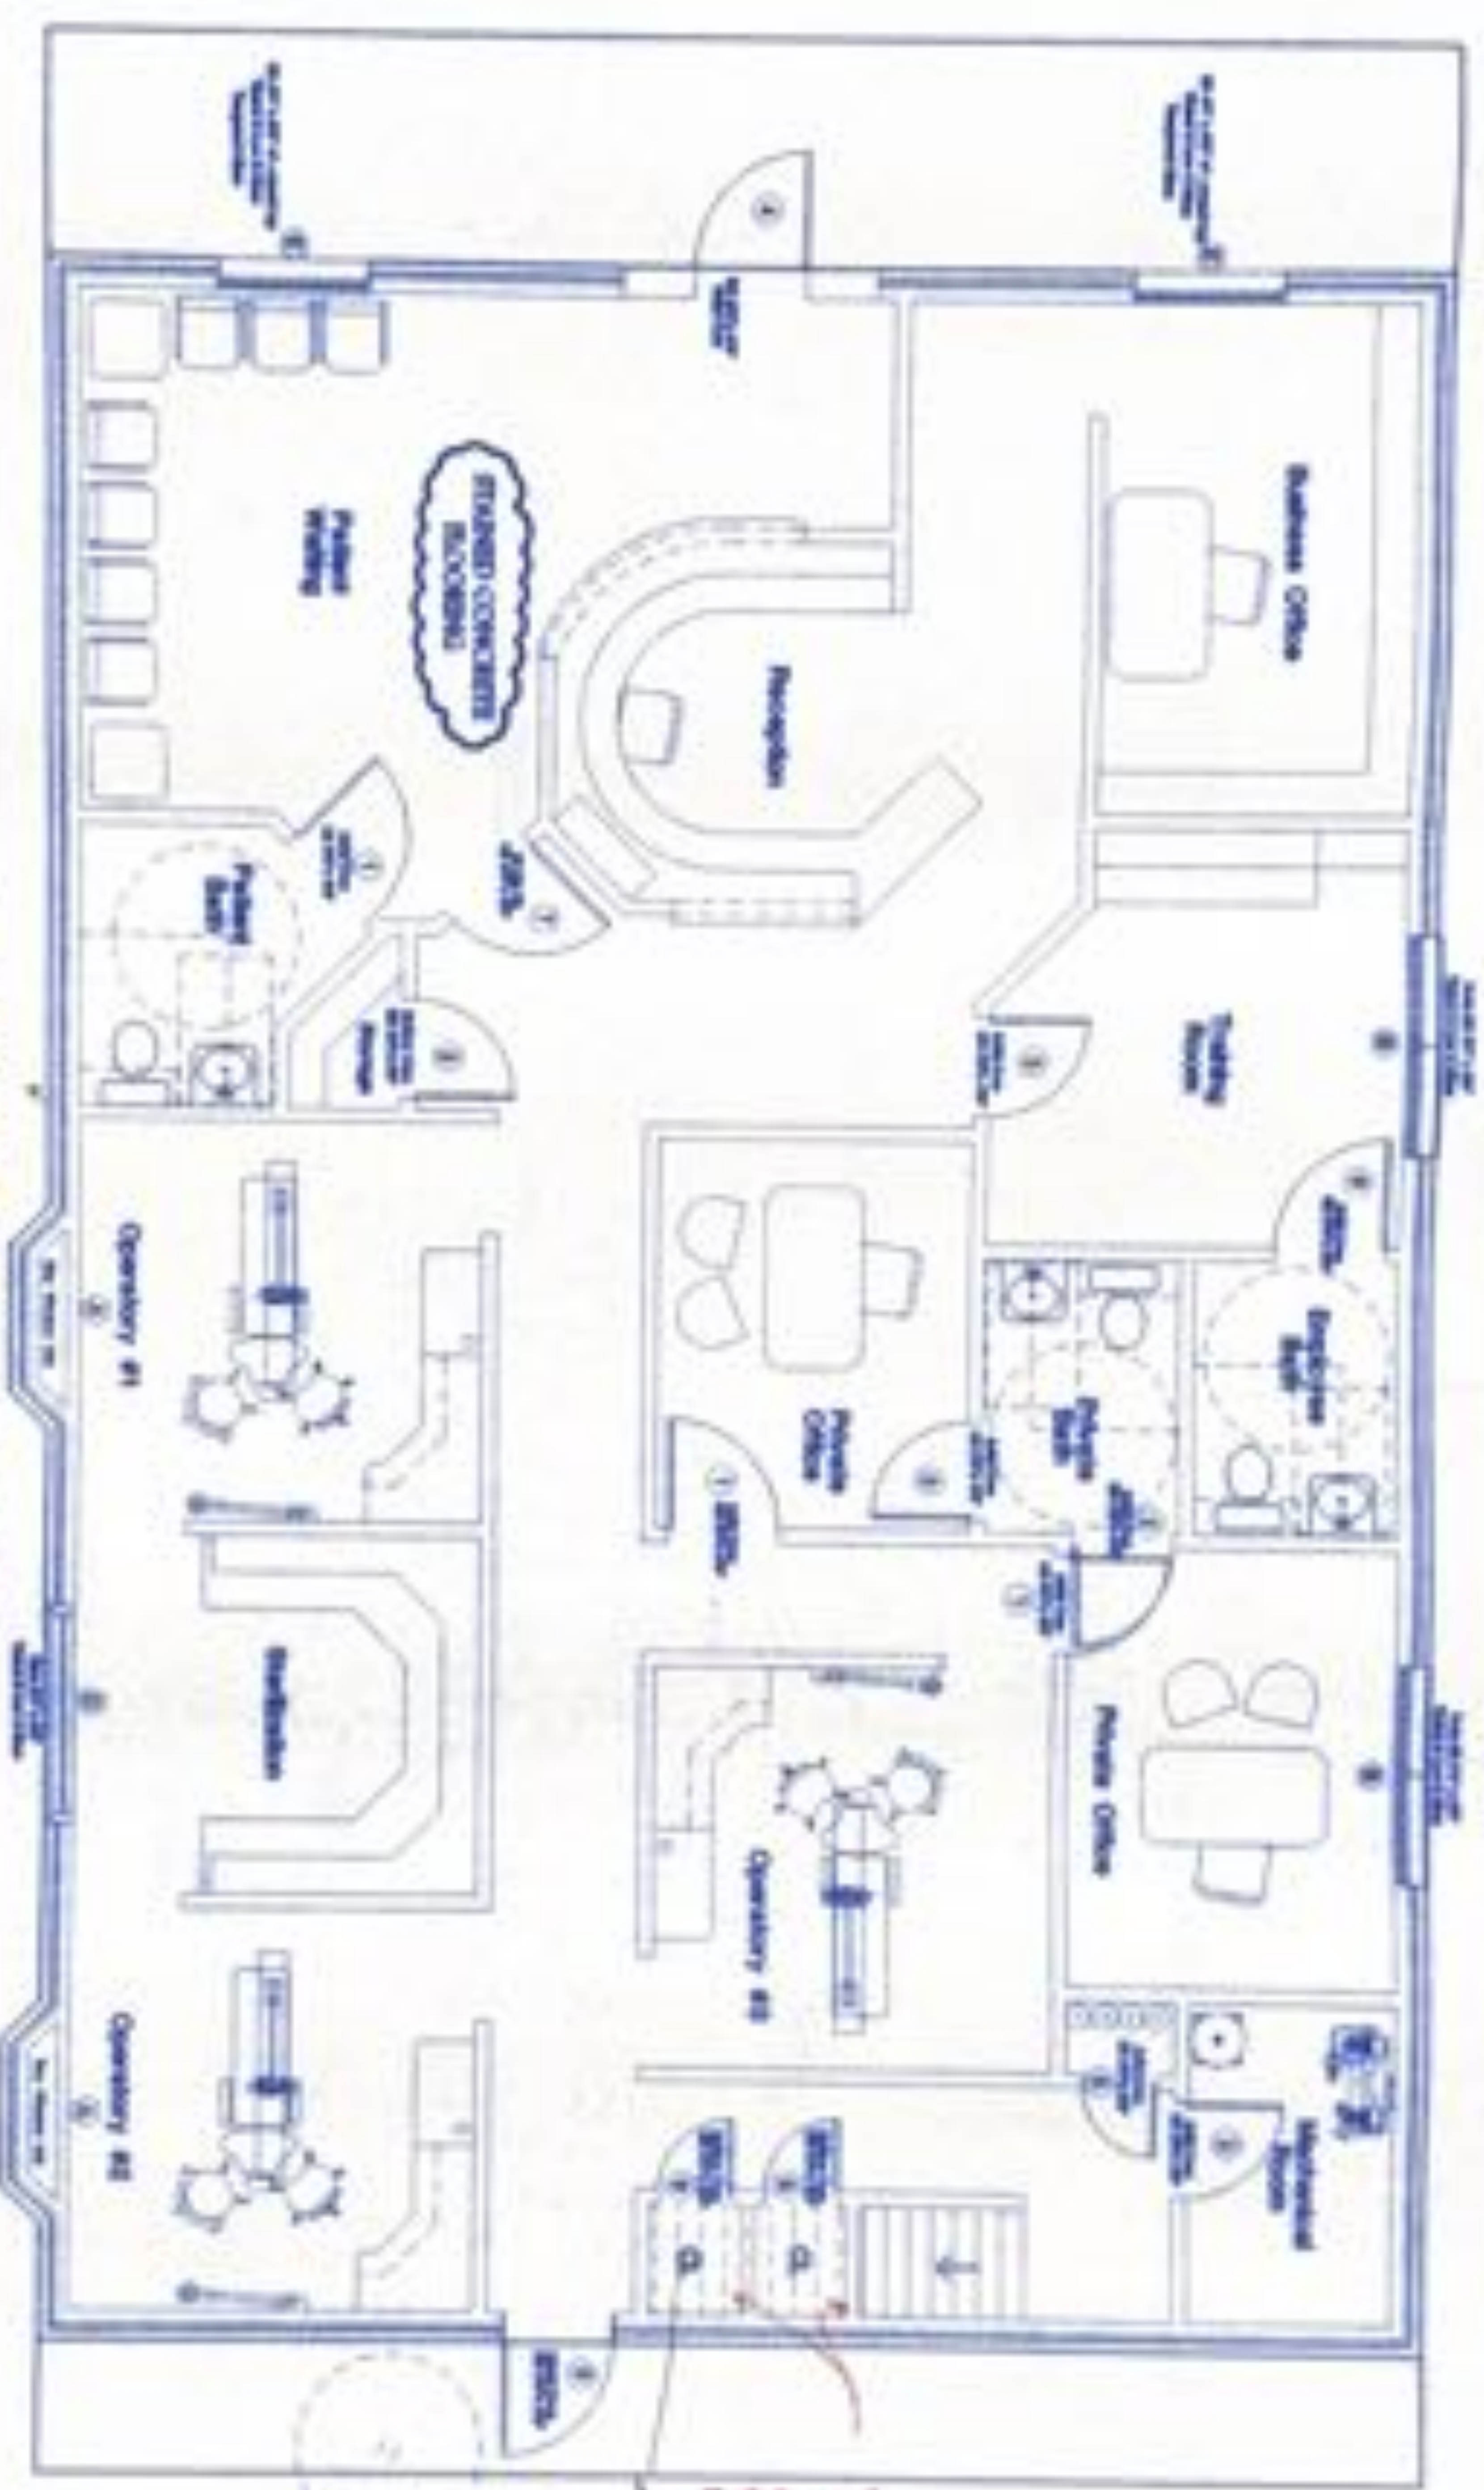

Handwritten notes in red ink:

- 1. 1st floor
- 2. 2nd floor
- 3. 3rd floor
- 4. 4th floor
- 5. 5th floor
- 6. 6th floor
- 7. 7th floor
- 8. 8th floor
- 9. 9th floor
- 10. 10th floor

1 FLOOR PLAN (1st Floor)
SCALE: 1/4" = 1'-0"

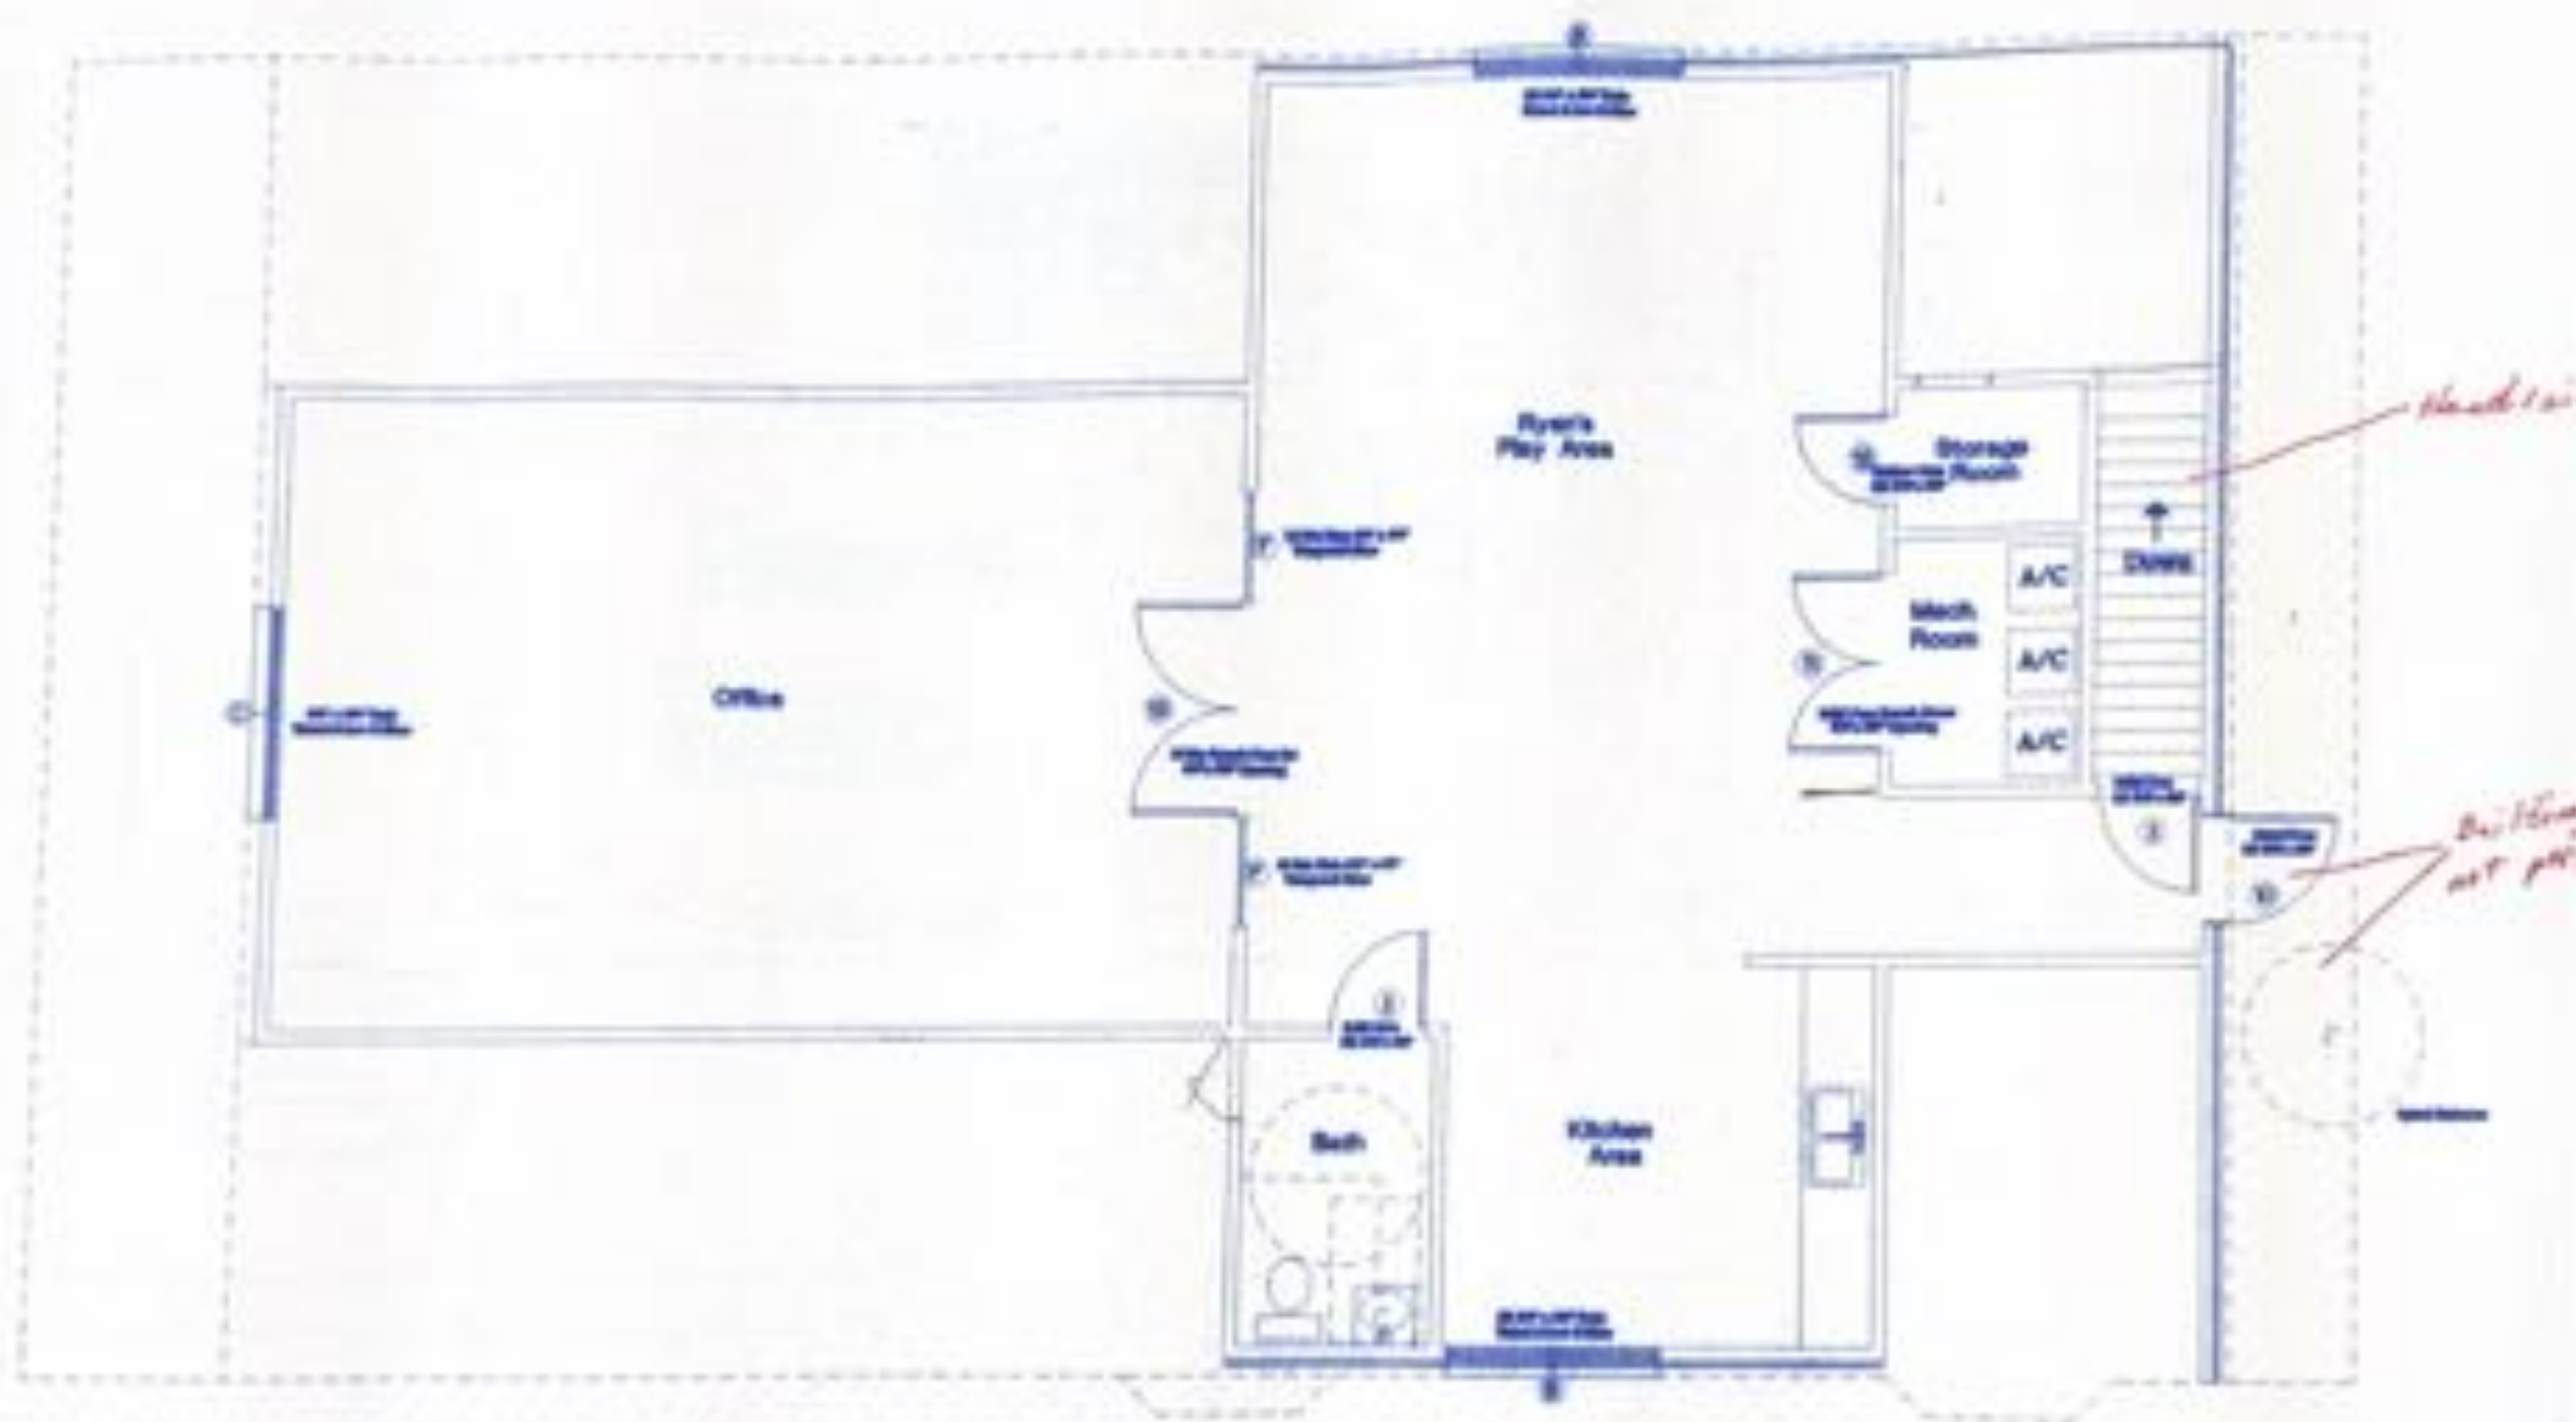

2 FLOOR PLAN (2nd Floor)

SCALE : 1/4" = 1'-0"