


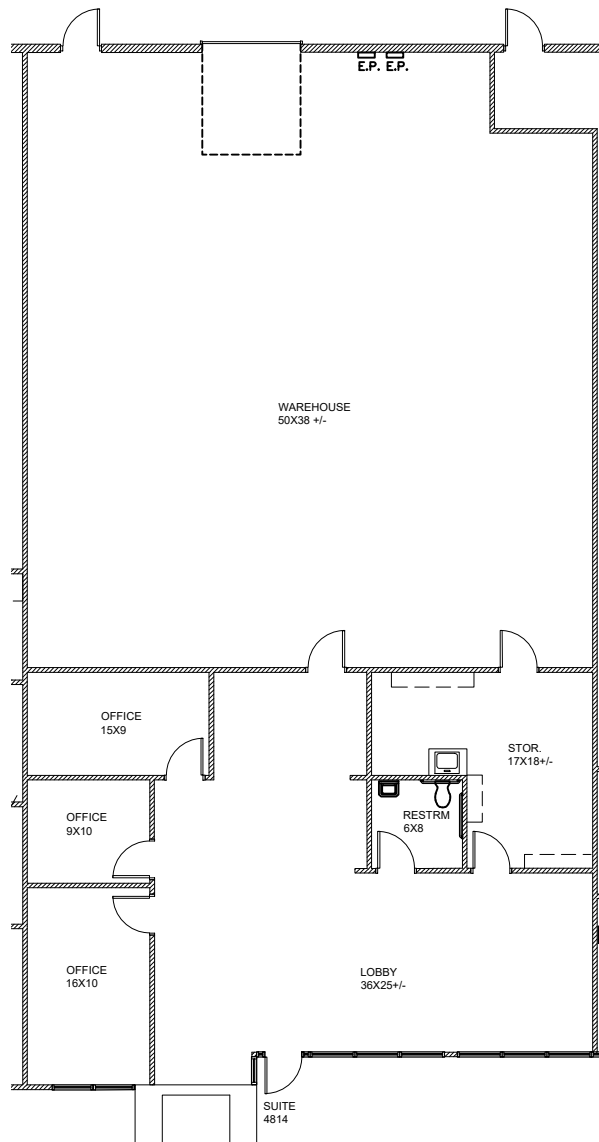

SCALE: N.T.S.

AS-BUILT PLAN SUITE 4814
4,078 RSF

4814 OLD NATIONAL HWY
COLLEGE PARK, GA 30337