



NOTES

Store front openings are subject to change
store fronts are 10' tall

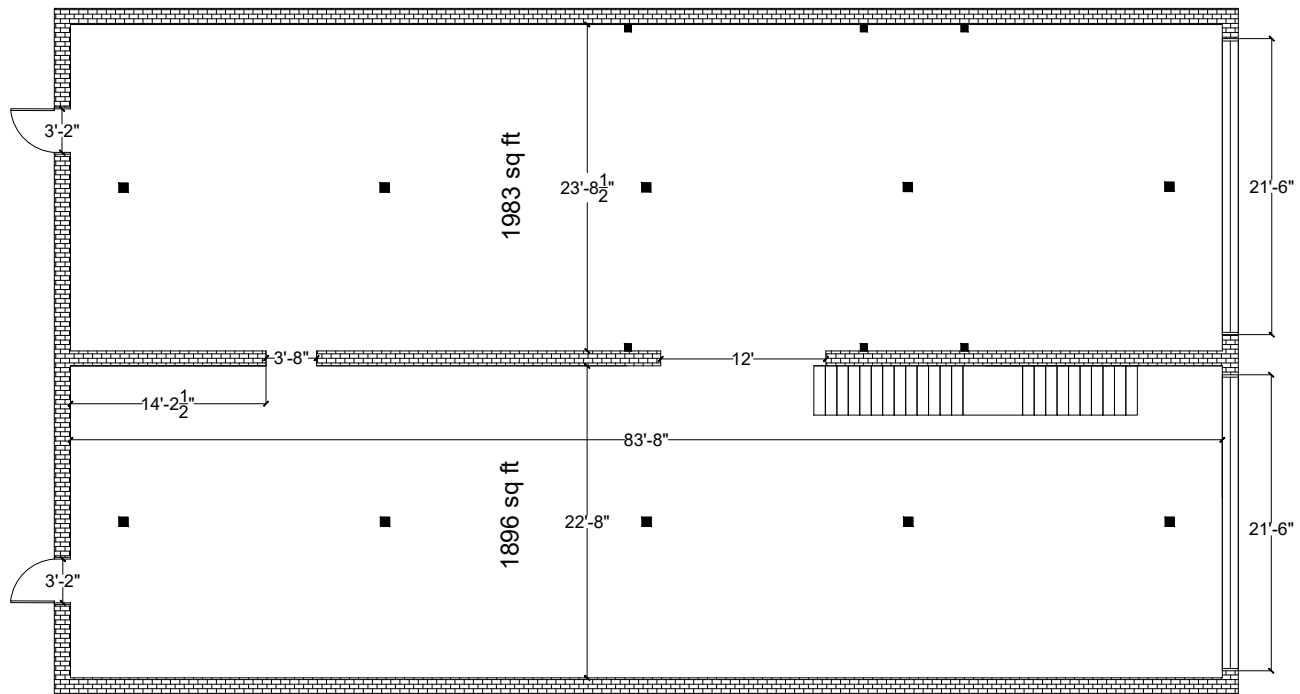

As Built First Floor

1/4" = 1' DO NOT SCALE DRAWING

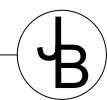

LISCENCE #
ROOFING CCC1332860
BUILDING CBC1262444
GENERAL CGC1532573
ELECTRICAL EC13012641

JBKENT CONSTRUCTION
1300 N EAST AVE SARASOTA FL, 34237
(941)955-1466 jay@jbkentconstruction.com

PROPOSED PROJECT FOR
416/420 12th St W


DATE
2/22/2024

SHEET NO.
1.0

NOTES

The back door is a fire escape
all windows are 66" tall on this floor

There is a 14" step to the opening for the rooftop deck

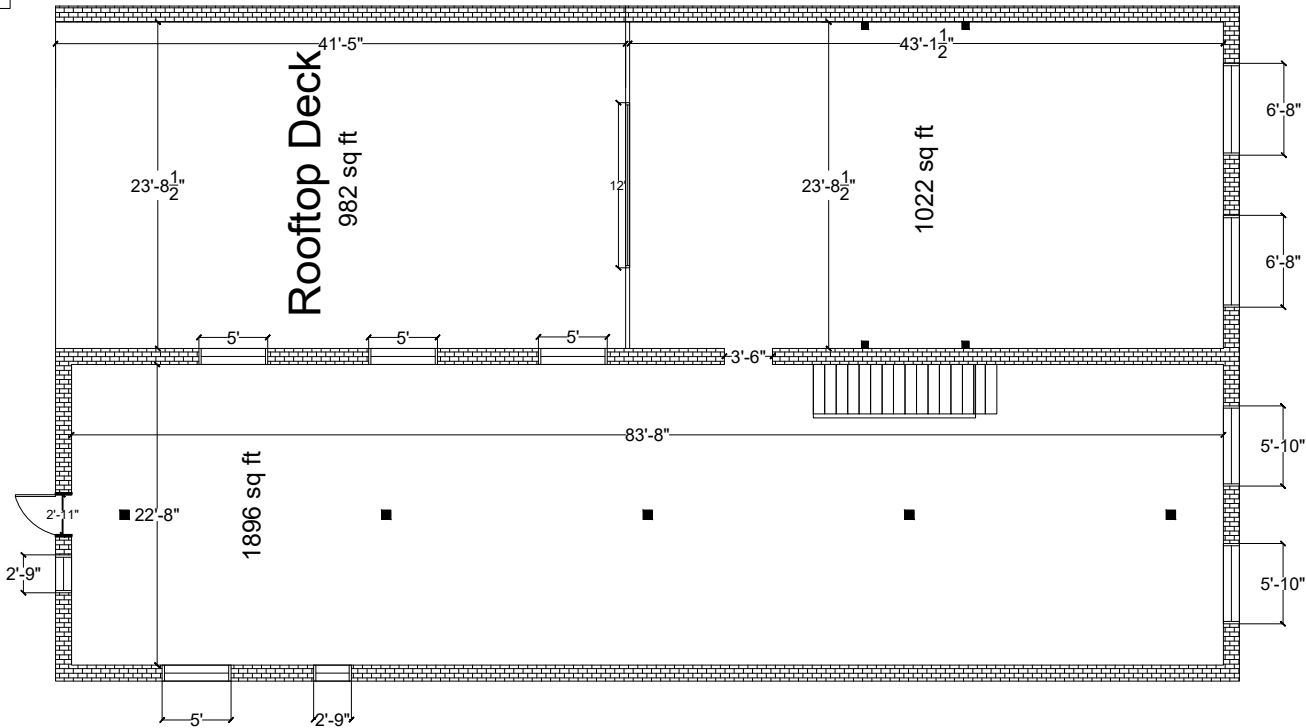

As Built second Floor

1/4' = 1' DO NOT SCALE DRAWING



LISCENCE #
ROOFING CCC1332860
BUILDING CBC1262444
GENERAL CGC1532573
ELECTRICAL EC13012641

JBKENT CONSTRUCTION
1300 N EAST AVE SARASOTA FL, 34237
(941)955-1466 jay@jbkentconstruction.com


PROPOSED PROJECT FOR
416/420 12th St W

DATE
2/22/2024

SHEET NO.
2.0


NOTES

All window heights are 66" tall

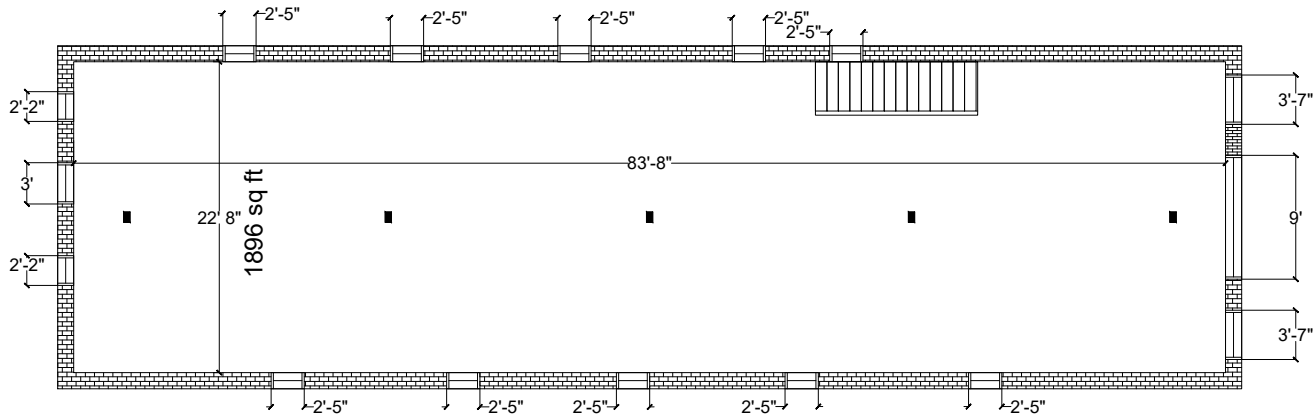

As Built Third Floor

1/4' = 1' DO NOT SCALE DRAWING

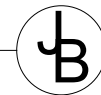

LISCENCE #
 ROOFING CCC1332860
 BUILDING CBC1262444
 GENERAL CGC1532573
 ELECTRICAL EC13012641

JBKENT CONSTRUCTION
 1300 N EAST AVE SARASOTA FL, 34237
 (941)955-1466 jay@jbkentconstruction.com

PROPOSED PROJECT FOR
 416/420 12th St W

DATE
 2/22/2024

SHEET NO.
 3.0