


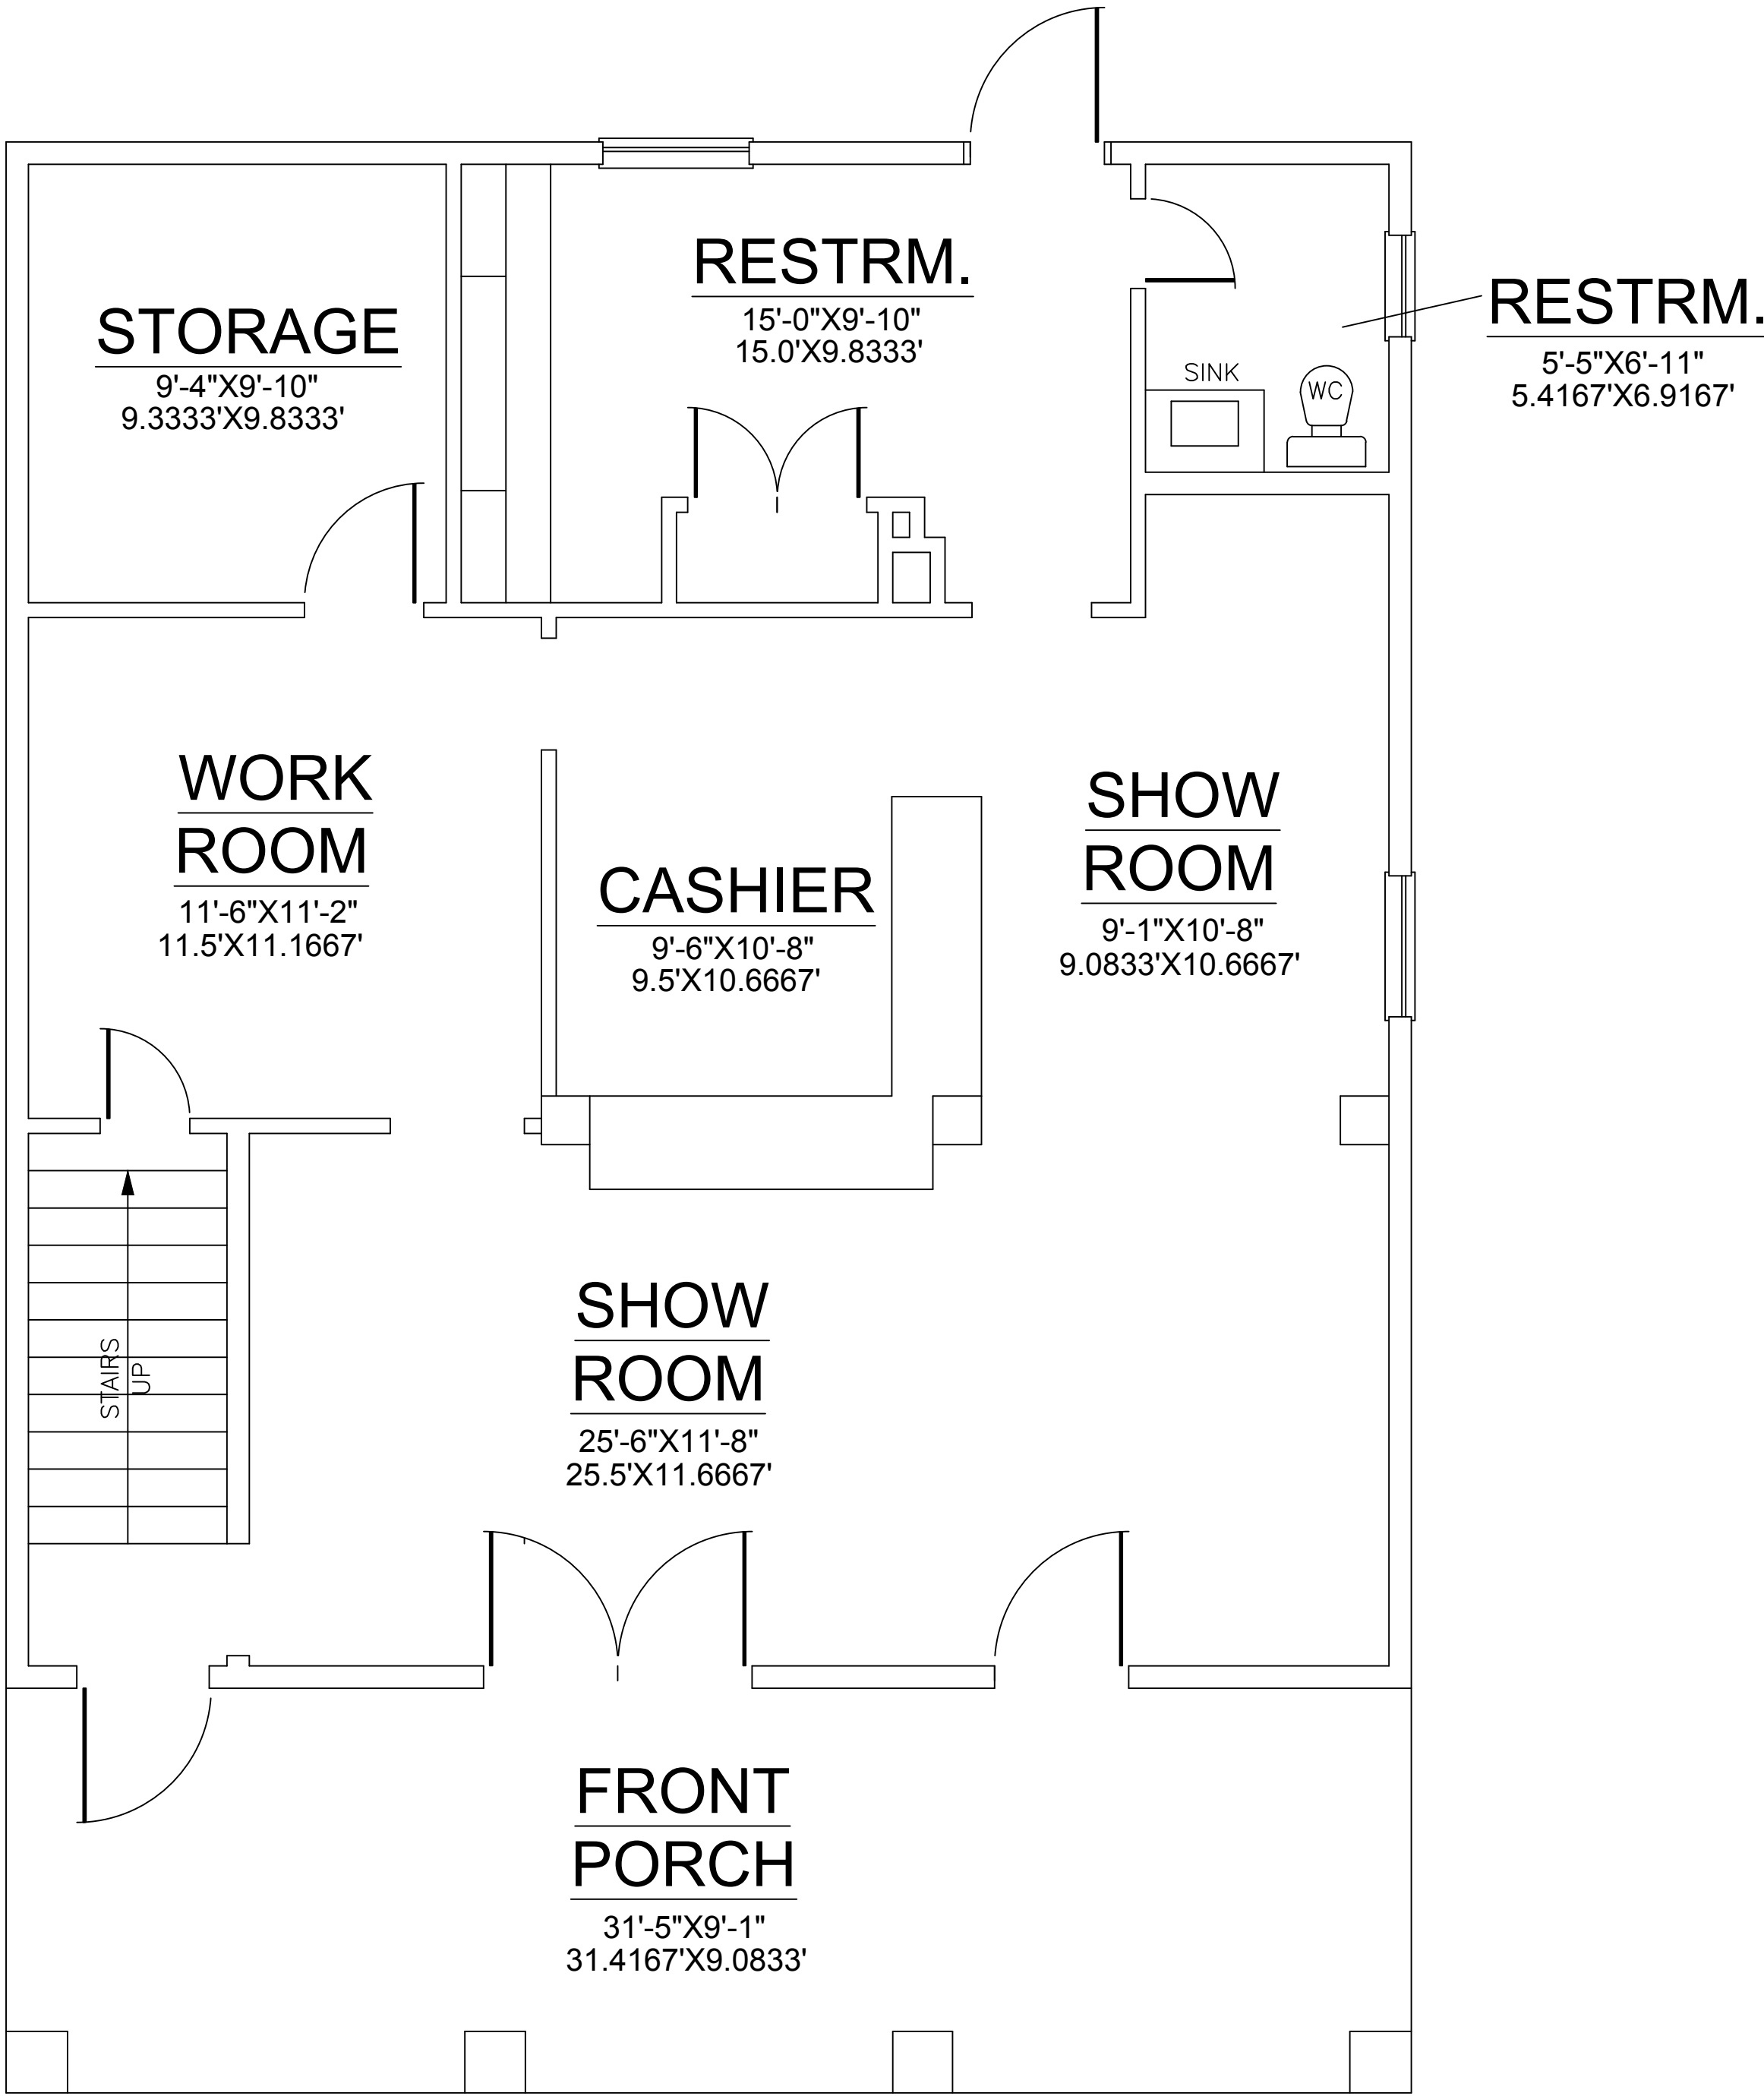

FLOOR PLAN

545 S. FOSTER
BATON ROUGE, LA.
AS-BUILT

SQUARE FOOTAGE	
LIVING AREA	1084 SQ.FT.
FRONT PORCH	284 SQ.FT.
BALCONY	284 SQ.FT.
2ND FLOOR	698 SQ.FT.
TOTAL	2350 SQ.FT.

