Monday, October 20, 2003 10:37:48

MAIN DISCONNECTS MARKED IN RED

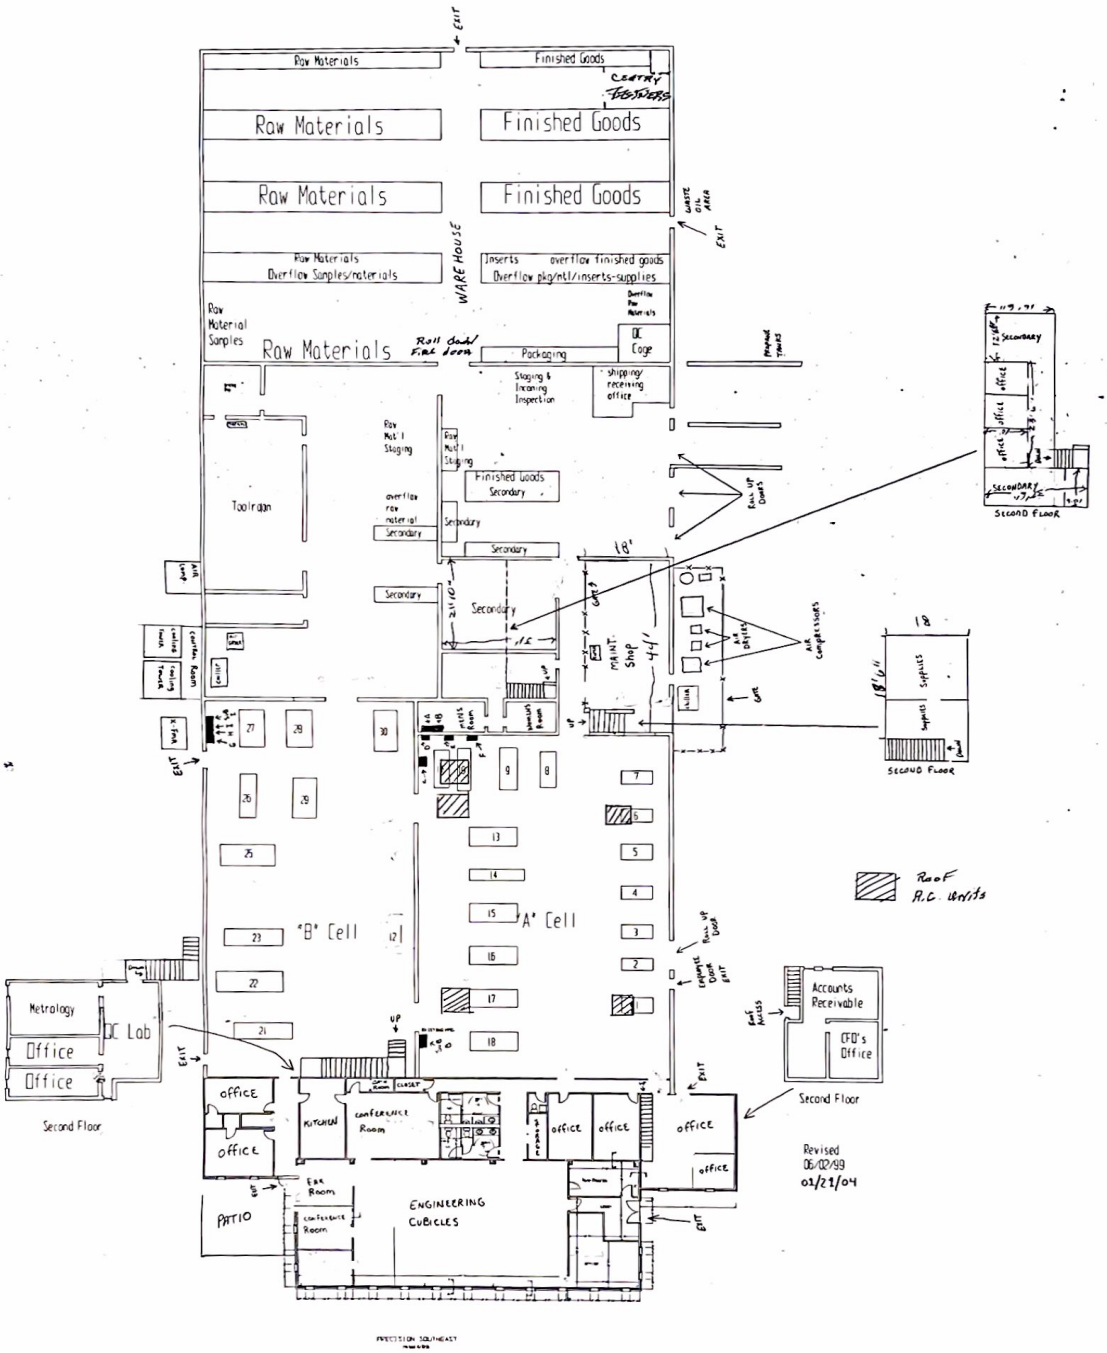

NTS

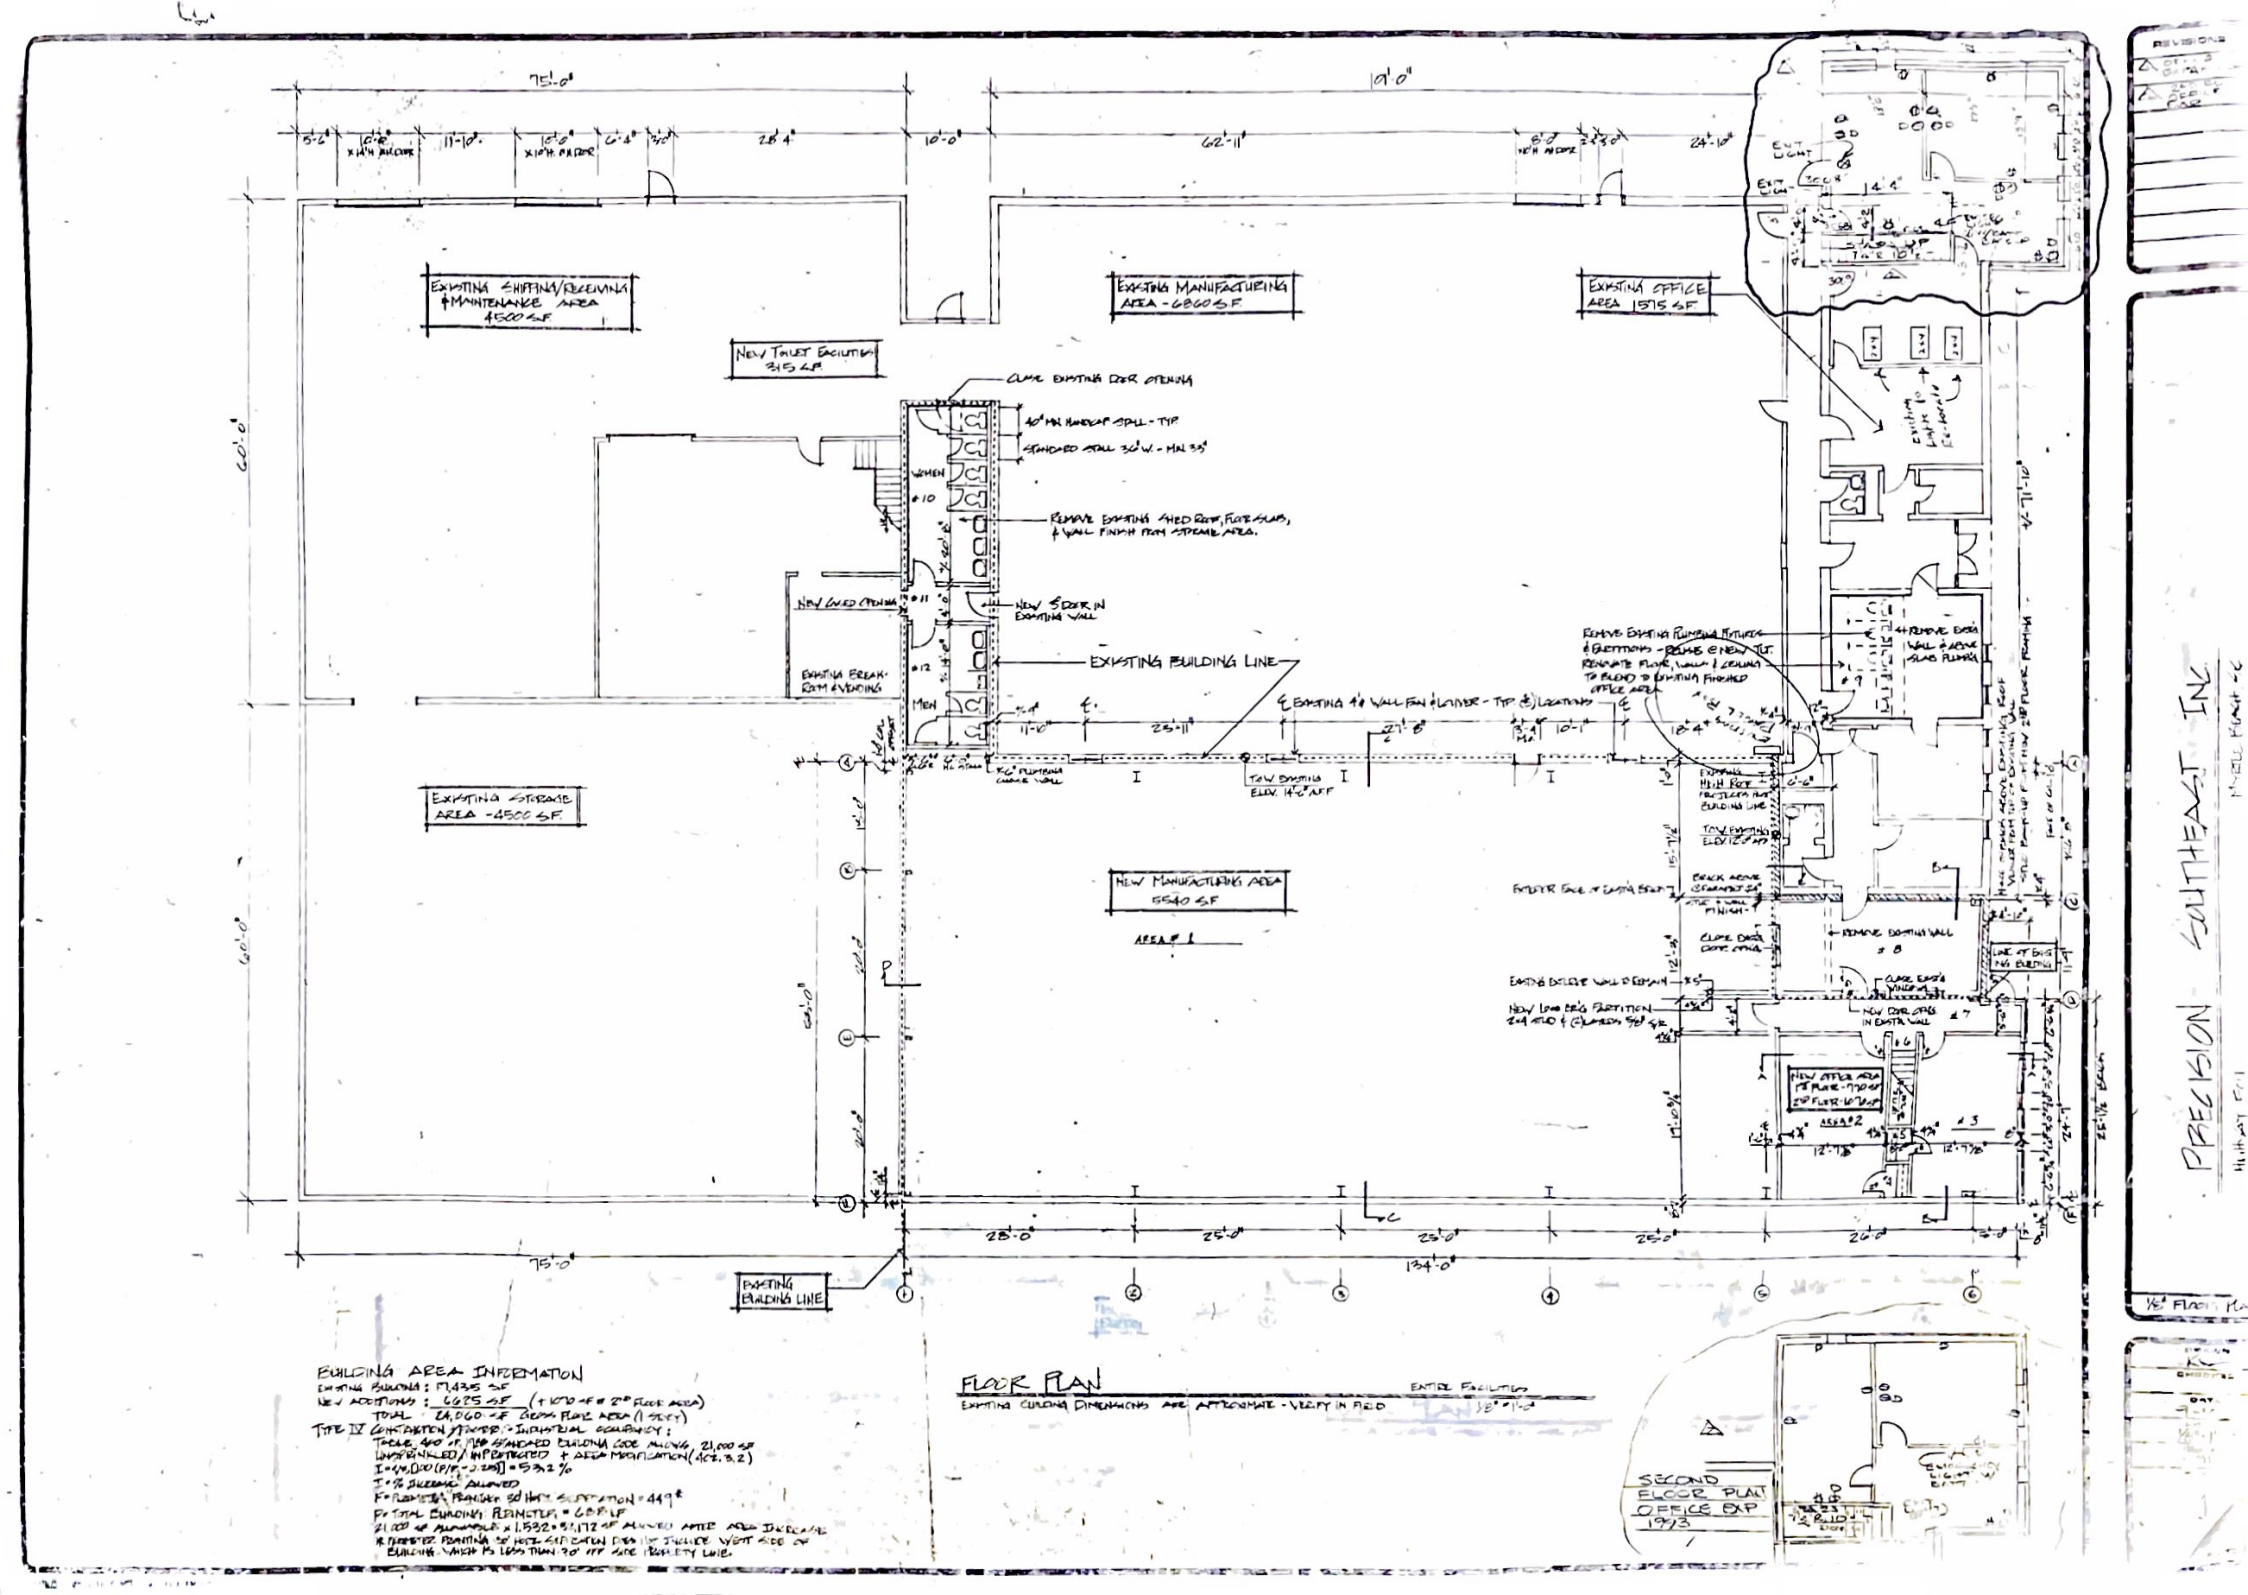

BUILDING AREA INFORMATION

EXISTING BUILDING : 17,435 SF
NEW ADDITIONS : 6675 SF (+ 1070 SF @ 2ND FLOOR AREA)
TOTAL 24,060 SF GROSS FLOOR AREA (1 STORY)

TYPE IV CONSTRUCTION / STORAGE & INDUSTRIAL OCCUPANCY:
TABLE 600 OF THE STANDARD BUILDING CODE ALLOWS 21,000 SF UNSPRINKLED / UNPROTECTED + AREA MODIFICATION (SEC. 3.2)
I = 24,000 (P/P - 20) = 53.2 %
I + 5% SLOPING ALLOWED
F = PERIMETER PLANUS 80 MIN + ELEVATION = 449'
P = TOTAL EXISTING PERIMETER = 688 LF
21,000 SF MAXIMUM x 1.532 = 53,172 SF ALLOWED AFTER AREA INCREASE
* PERIMETER FRONTING ON MORE THAN ONE STREET OR PUBLIC WAY OF BUILDING WHICH IS LESS THAN 90° FROM SAME PROPERTY LINE.

FLOOR PLAN

EXISTING BUILDING DIMENSIONS ARE APPROXIMATE - VERIFY IN FIELD

ENTIRE FACILITIES 1/8" = 1'-0"

SECOND FLOOR PLAN OFFICE EXP 1993

REVISIONS

PRELIMINARY

SOUTHEAST INC

1/8" FLOOR PLA