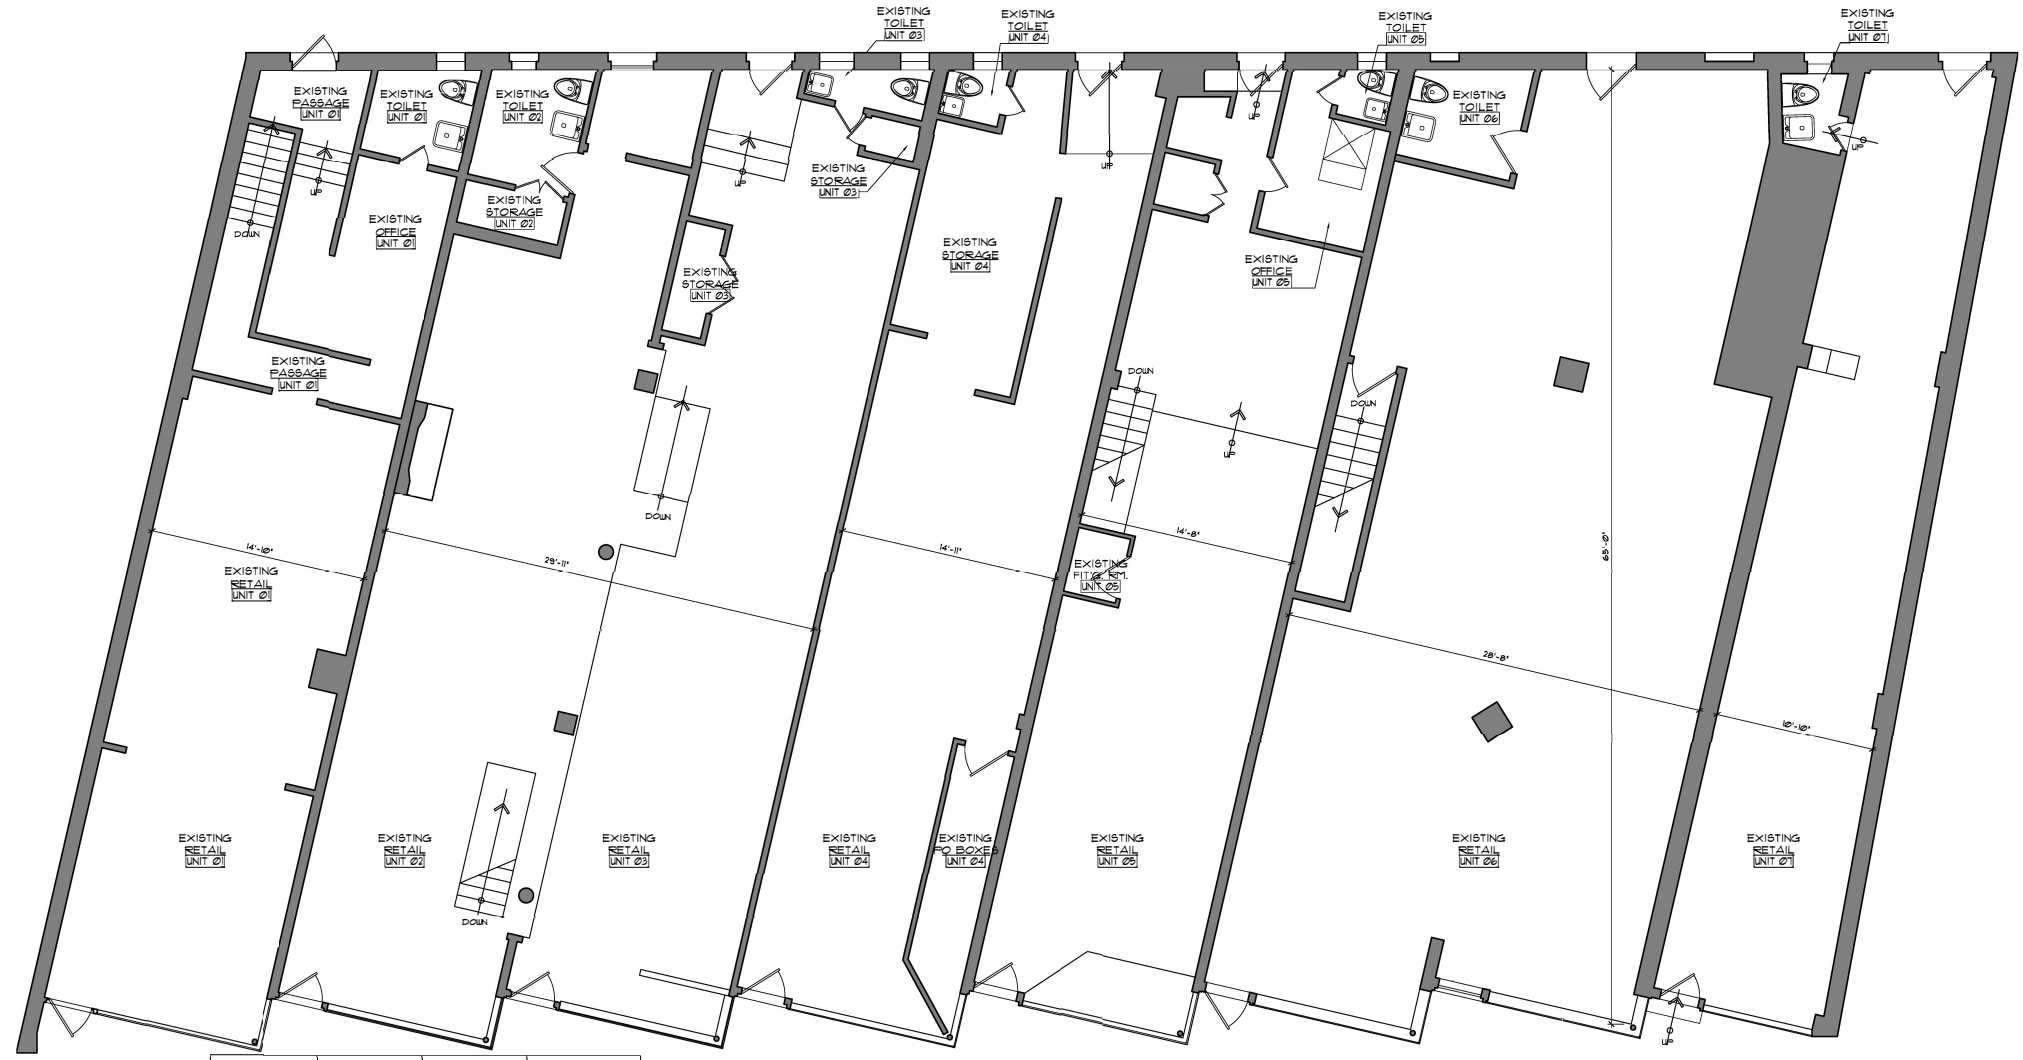


ARCHITECTURE
INTERIOR DESIGN
PROJECT MANAGEMENT
80 RED SCHOOLHOUSE ROAD, SUITE 105
CHESTNUT RIDGE, N.Y. 10977
(845) 426-5300 FAX (845) 426-5310
www.dyami.com
DYAMI

# AS-BUILT DRAWING FOR UPPER LEVEL
## 7-19 PUTNAM AVENUE GREENWICH, CT

1/4" = 1' - 0"

A1

05/12/2010




0' 2' 4' 6' 8'

| | | | |
|---|---|---|---|
| | | | |

DYAMI
ARCHITECTURE
INTERIOR DESIGN
PROJECT MANAGEMENT
80 RED SCHOOLHOUSE ROAD, SUITE 105
CHESTNUT RIDGE, N.Y. 10977
(845) 426-5300 FAX (845) 426-5310
www.dyami.com

# AS-BUILT DRAWING FOR LOWER LEVEL
## 7-19 PUTNAM AVENUE GREENWICH, CT

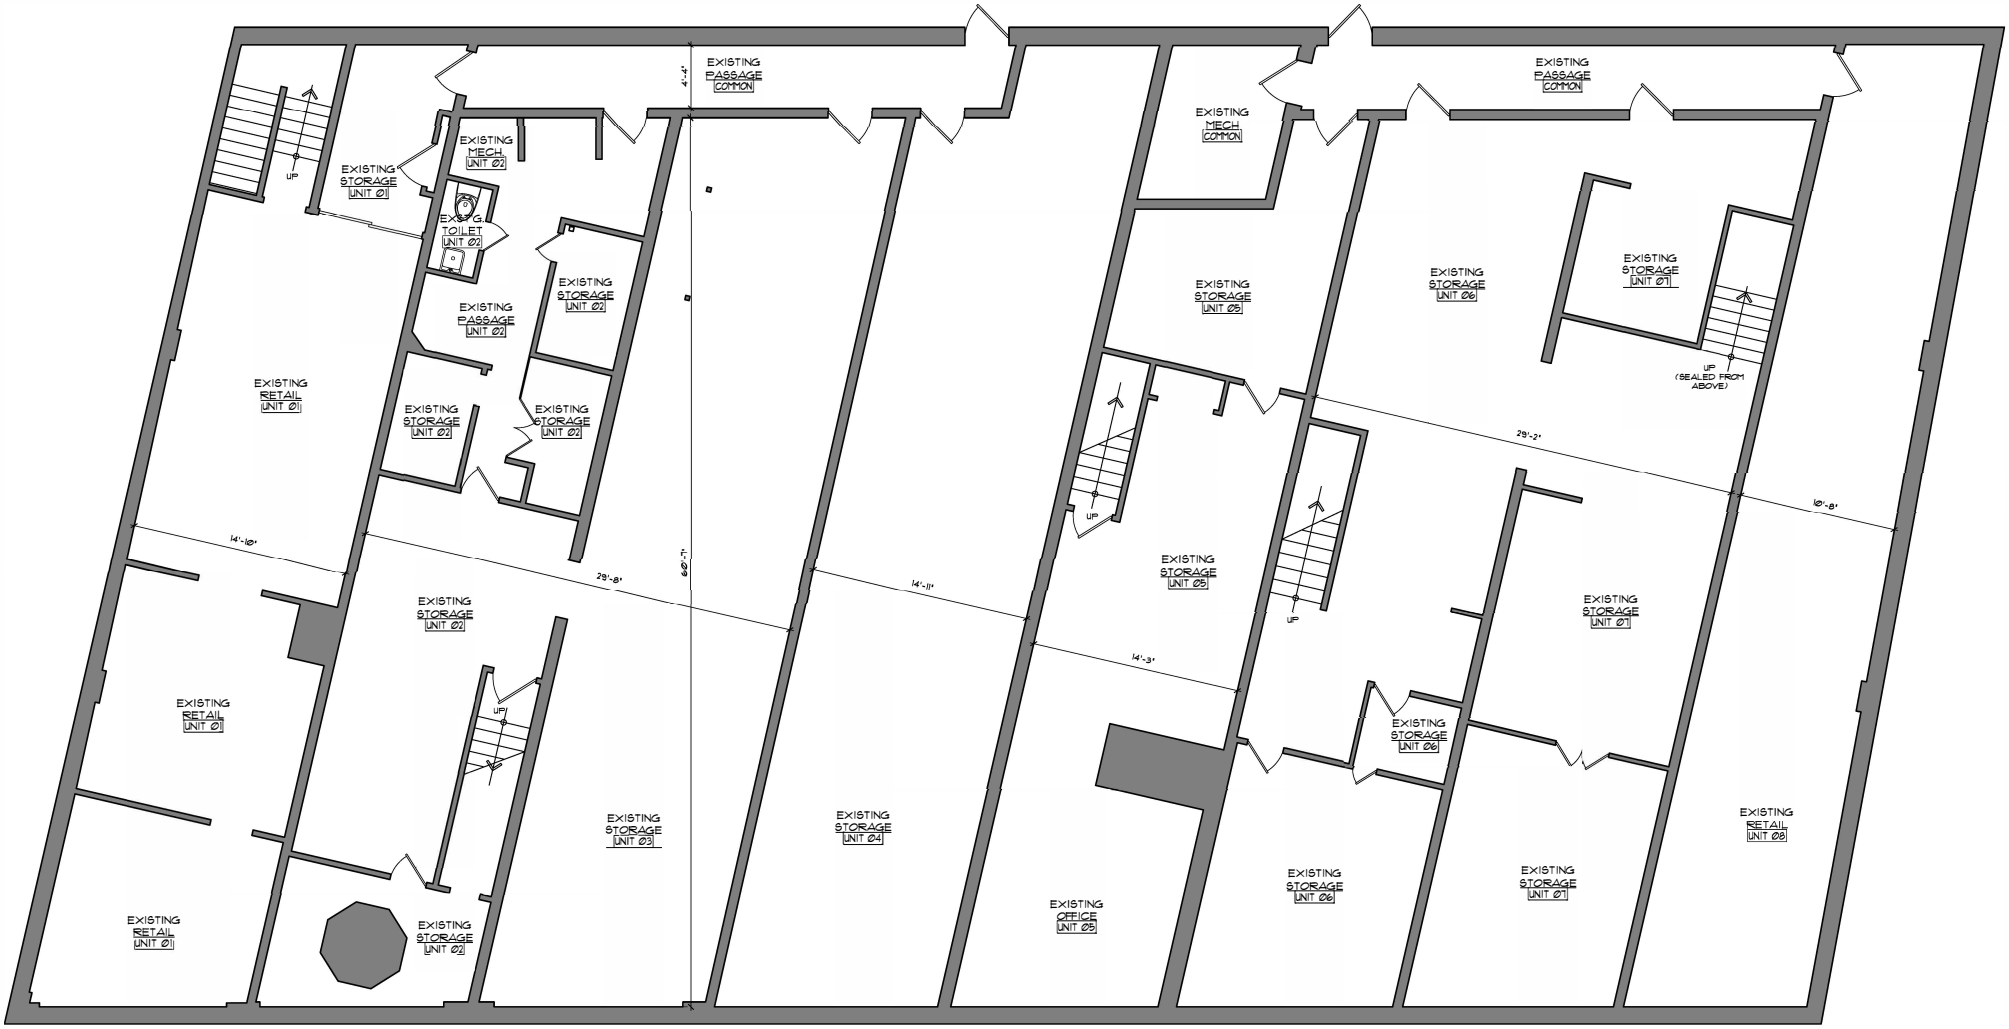1/4" = 1' - 0"

A2

05/12/2010