AS BUILT

TAYLOR CPB PROPERTY

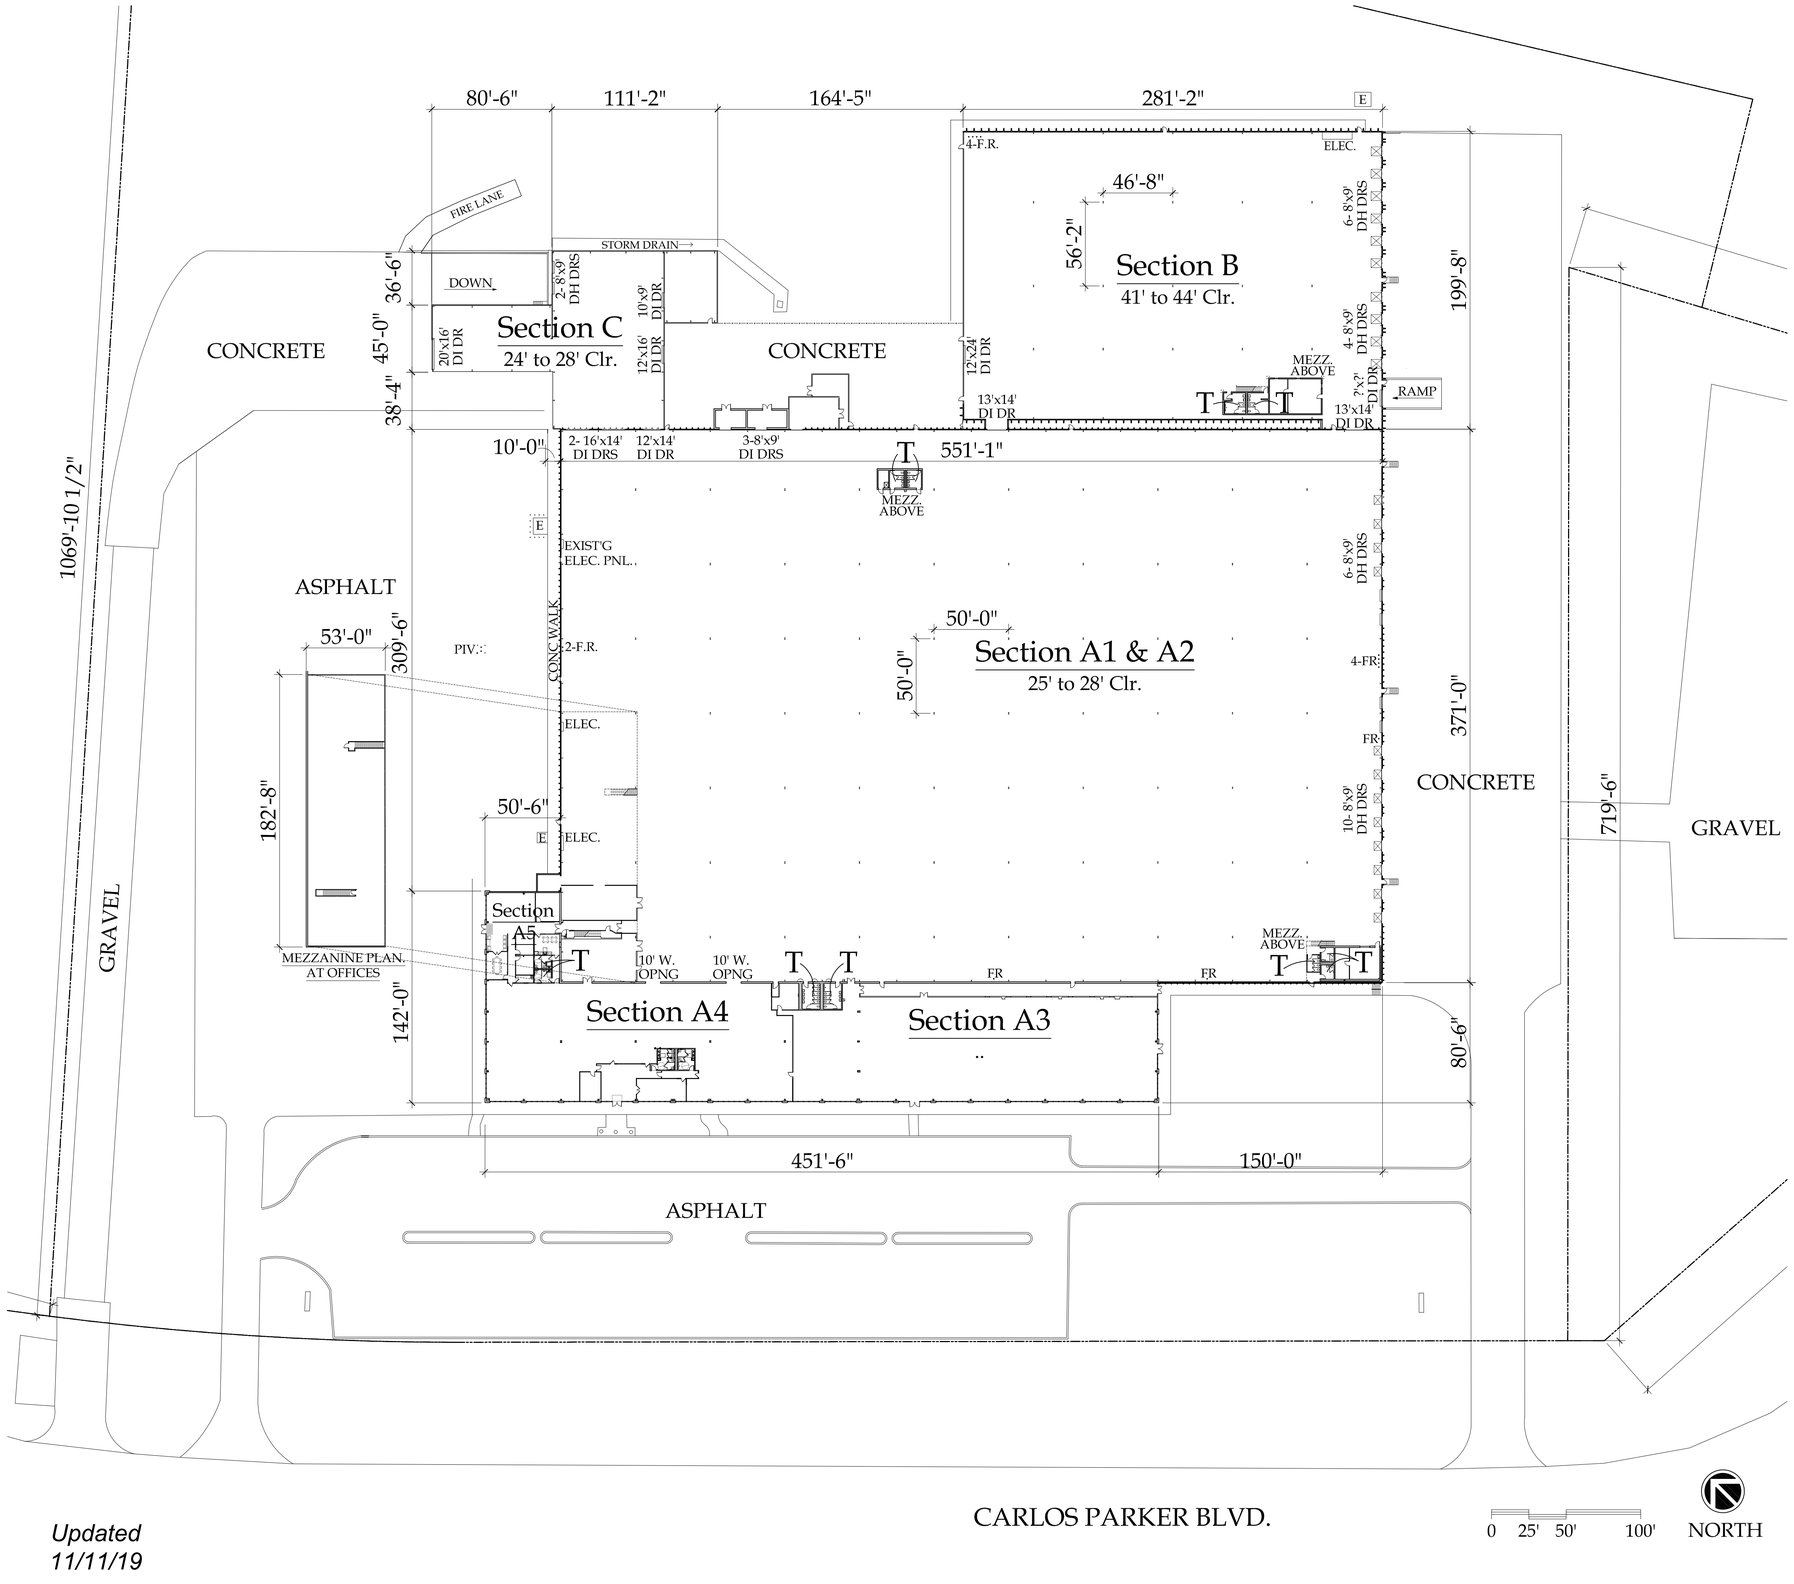

Sec A1 & A2	- 220,233 SF
Mezz	- 1,560 SF
Mezz	- 9,512 SF
DH Doors	- 16
Ceiling	- 25’-28’
Columns	- 50’ x 50’
Sec A3/Office	- 15,255 SF
Sec A4/Office	- 18,738 SF
Sec A5/Office	- 3,274 SF
Sec B	- 56,136 SF
Mezz	- 1,367 SF
DH Doors	- 10
DI Doors	- 2
Ceiling	- 41’-44’
Columns	- 56’ x 47’
Sec C	- 15,054 SF
DH Doors	- 2
DI Doors	- 2
Ceiling	- 24’-28’
Columns	- 46’ x Clear Span
Total Bldg	- 328,700 SF
Total Land	- 39.9 Acres
Available Land	- 18.9 Acres

Updated 11/11/19

BULK Bulk Industrial Group LLC

The Value Leader In Industrial Real Estate