


SUITE 100 - EXISTING AS-BUILT

SCALE: 1/8"=1'-0"

LOCATION: 2075 FOXFIELD RD.
ST. CHARLES, IL 60174

PLAN #: AS-BUILT
PROJECT#: 24007

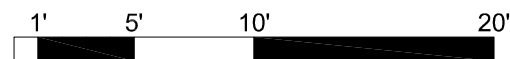

BÂTIR
DESIGN · BUILD · SUSTAINABLE SOLUTIONS

BATIR ARCHITECTURE, LTD.
1121 E. MAIN ST. SUITE 220, ST. CHARLES, IL 60174
PHONE: 630-513-5109 FAX: 630-513-5919
WWW.BATIRARCH.COM

NORTH