CAUTION: IF THIS SHEET IS NOT 30"x42" IT IS A REDUCED PRINT.

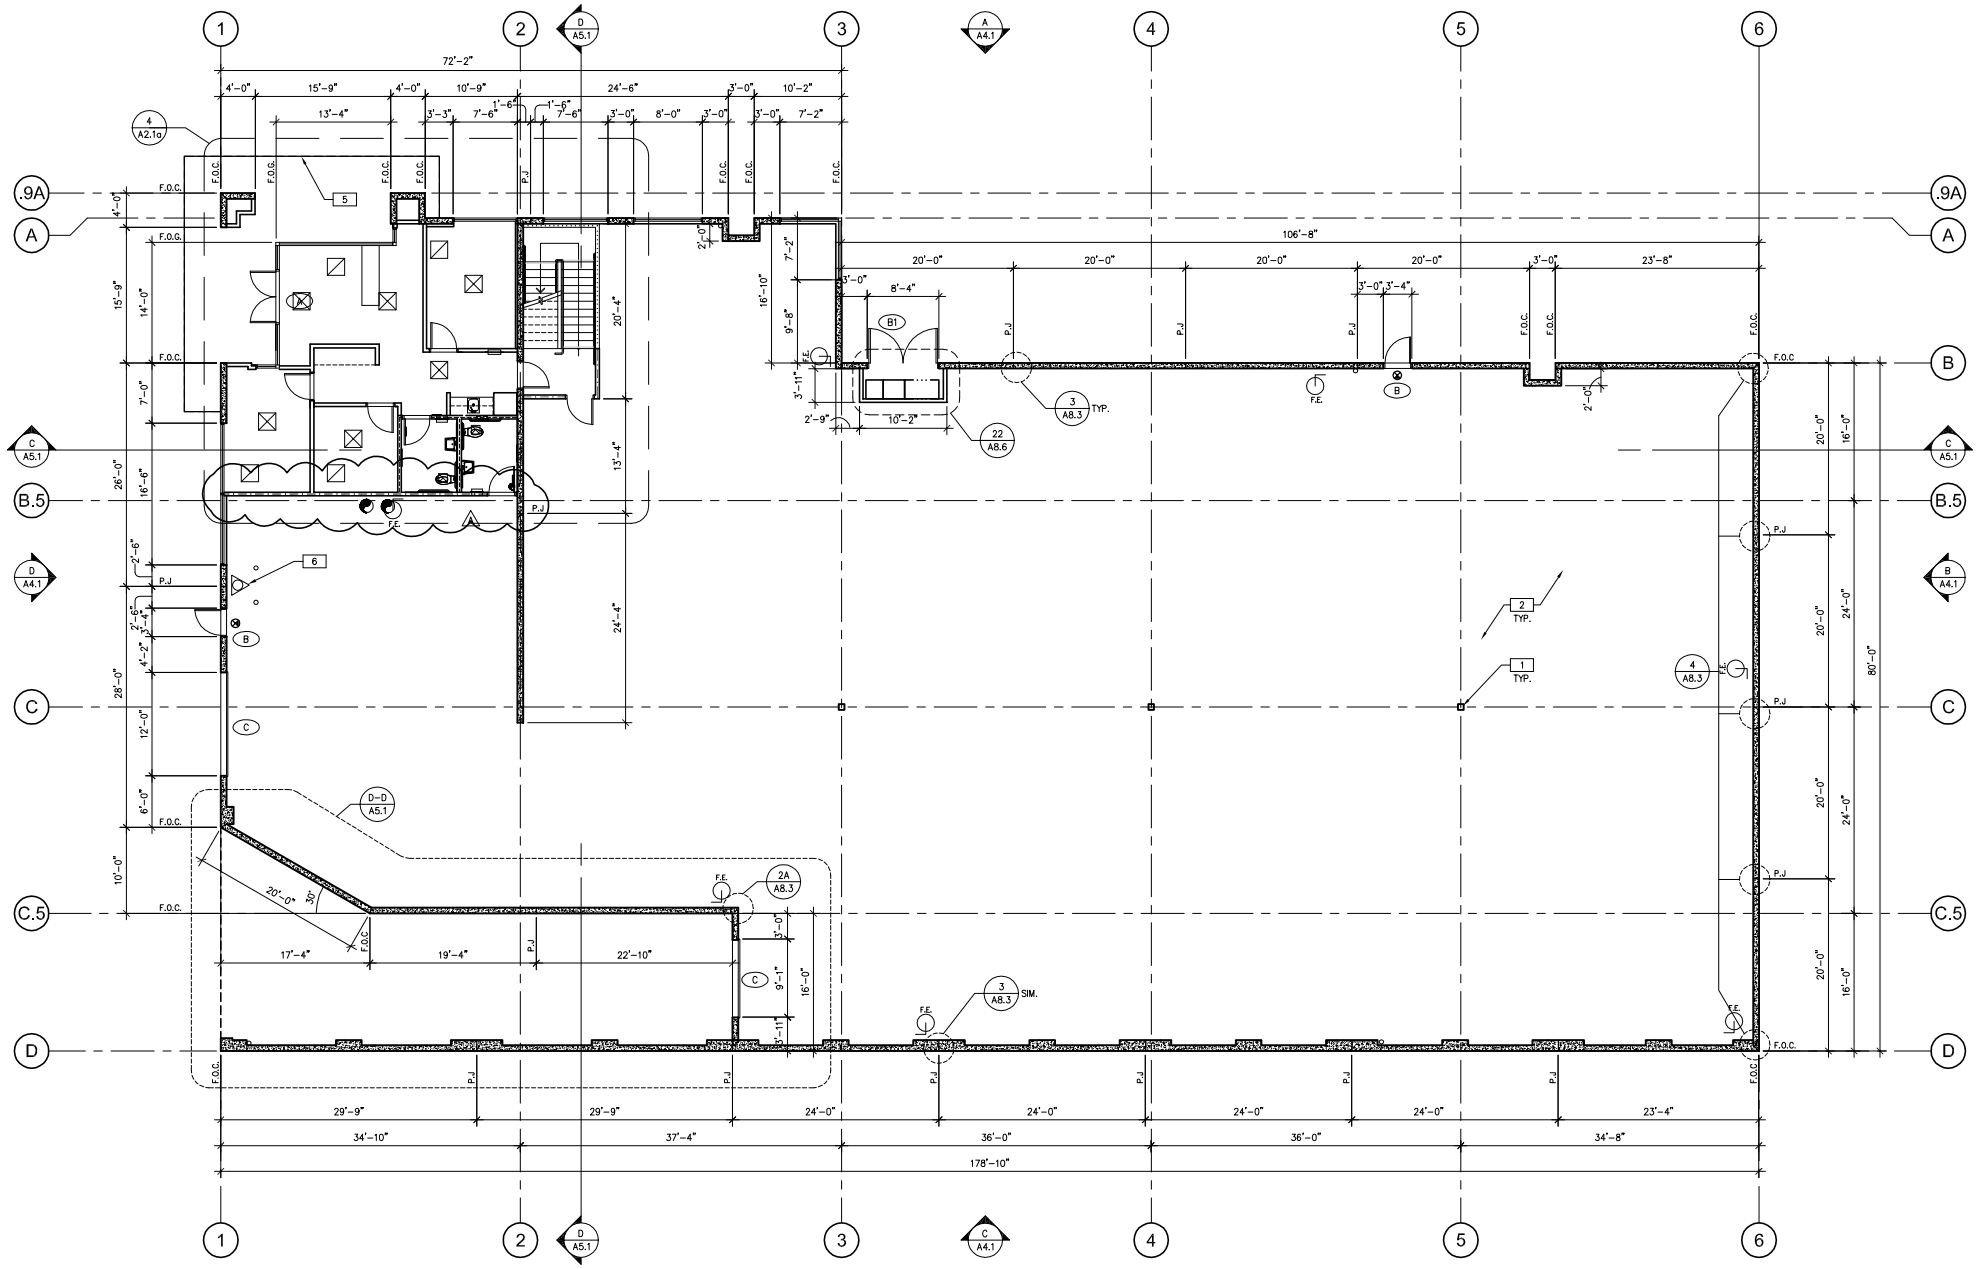

FLOOR PLAN NOTES

SEE SHEET A0.2 FOR GENERAL NOTES.

1. STRUCTURAL COLUMN, SEE STRUCTURAL DRAWINGS.
2. STRUCTURAL CONCRETE SLAB, SEE STRUCTURAL DRAWINGS. PROVIDE VISQUEEN OVER SAND BASE PER SOIL REPORT. SLAB IS CONSIDERED FINISHED – ALL TRADES TO PRETEST AS REQUIRED.
3. ROOF ACCESS LADDER.
4. ELECTRICAL SWITCHGEAR/EQUIPMENT, SEE ELECTRICAL DRAWINGS.
5. CANOPY LINE ABOVE
6. FIRE RISER W/ (2) REMOVABLE PIPE BOLLARDS, SEE CIVIL & PLUMB. DWGS.

INDICATES ILLUMINATED EMERGENCY EXIT SIGN ABOVE DOOR WITH BATTERY POWERED BACK-UP, SEE ELECTRICAL DRAWINGS.

WALL MOUNTED FIRE EXTINGUISHER PER LOCAL FIRE AUTHORITY

DOOR TYPES

ALUM. STOREFRONT

PR 3'-0" X 8'-0"
CLEAR ANOD. ALUM. STOREFRONT
DOOR W/TEMPERED GLAZING (MED. STILE)

FRAME: MANUF

HARDWARE:
2 SETS PIVOT SET
2 SETS INTER PIVOT
1 EA EXIT DEVICE
1 EA MORTISE CYLINDER
2 SETS OFFSET PULL
2 EA OH CLOSER
1 EA THRESHOLD
1 EA DECAL
NOTE: WEATHERSEAL BY DOOR MANUFACTURER

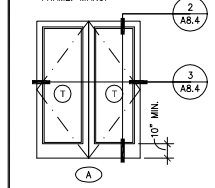

HOLLOW METAL

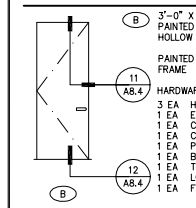

B) 3'-0" X 7'-0"
PAINTED NSULATED HOLLOW METAL DOOR

PAINTED HOLLOW METAL FRAME

HARDWARE:
3 EA HINGES
1 EA EXIT DEVICE
1 EA CYLINDER
1 EA CLOSER
1 EA PERIMETER SEAL
1 EA BOTTOM DRIP
1 EA THRESHOLD
1 EA LOCK GUARD
1 EA FLOOR STOP

B1) 4'-0" X 8'-0"
PAINTED LOUVERED HOLLOW METAL DOOR

FRAME: PAINTED HOLLOW METAL

HARDWARE:
4 EA HINGES
1 EA EXIT DEVICE
1 EA CYLINDER
1 EA PERIMETER SEAL
1 EA THRESHOLD
1 EA LOCK GUARD
1 EA LOUVER ASSBLY.

B1) AT ELEC. RM.

ROLL-UP DOOR

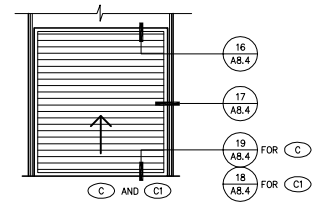

C) 9' W X 10' H STEEL ROLL-UP AT DOCK HIGH DOOR W/FACTORY PAINTED FINISH.

HARDWARE:
1 EA SLIDE BOLT
1 EA PAD LOCK

C1) 12' W X 14'-0" H STEEL ROLL UP AT GRADE LEVEL DOOR W/ FACTORY PAINTED FINISH.

BUTT HINGES:
SOSS – STANDARD WEIGHT, PLAIN BEARING, STEEL HINGES OR APPROVED EQUAL.
ALL EXTERIOR OUTSWING DOOR BUTTS SHALL BE MADE OF NON-FERROUS MATERIAL AND SHALL HAVE STAINLESS STEEL HINGE PINS.

VON DUPRIN 99 SERIES PANIC DEVICE OR APPROVED EQUAL

CLOSING DEVICES:
NORTON 8500 BF SERIES OR APPROVED EQUAL.

STOPS:
TRIMCO W3200 SERIES DOOR STOP

WALL LEGEND

- CONCRETE WALL
- INTERIOR PARTITION TO UNDERSIDE OF CEILING
- FULL HEIGHT NON-RATED PARTITION TO STRUCTURE
- FULL HEIGHT PARTITION TO 6" ABOVE CEILING
- LOW WALL PARTITION, SEE PLAN SPECIFIC NOTES FOR WALL HEIGHT

KEY PLAN

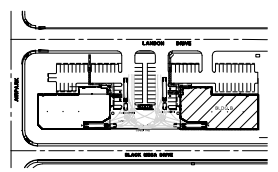

BUILDING B - FIRST FLOOR PLAN
SCALE: 1/8"=1'-0"

NO SCALE

THESE DRAWINGS AND SPECIFICATIONS ARE THE PROPERTY AND COPYRIGHT OF WARE MALCOMB AND SHALL NOT BE USED ON ANY OTHER WORK EXCEPT BY AGREEMENT WITH WARE MALCOMB. WRITTEN DIMENSIONS SHALL TAKE PREFERENCE OVER SCALED DIMENSIONS AND SHALL BE VERIFIED ON THE JOB SITE. ANY DISCREPANCY SHALL BE BROUGHT TO THE NOTICE OF WARE MALCOMB PRIOR TO THE COMMENCEMENT OF ANY WORK.

WARE MALCOMB
architecture
planning
interiors
graphics
irvine
los angeles
northern california
sacramento
san diego
denver
chicago
new jersey
10 celestan
irvine, california 92618
p 949.660.9128 f 949.660.1581

BULLHEAD AIRPARK
AIRPARK DR. & LANDON DR.
BULLHEAD CITY, ARIZONA

BUILDING B - FIRST FLOOR PLAN

DATE	REMARKS
08-03-06	2ND PLAN CHECK SUBMITTAL

PA / PM:	LUIS IBANEZ
DRAWN BY:	FTS/I.N.
JOB NO.:	061-009-00

SHEET
A2.1
BUILDING B

2ND PLAN CHECK SUBMITTAL 08-03-06

I:\Jobs06\Corbiz LLC\06100900 - Bullhead City-Landon Drive\Cad\CD\B_009A21.dwg, 10/18/2006 1:56:31 PM, PDF995.pc3
E:\Jobs06\Corbiz LLC\06100900 - Bullhead City-Landon Drive\Cad\CD\B_009A21.dwg