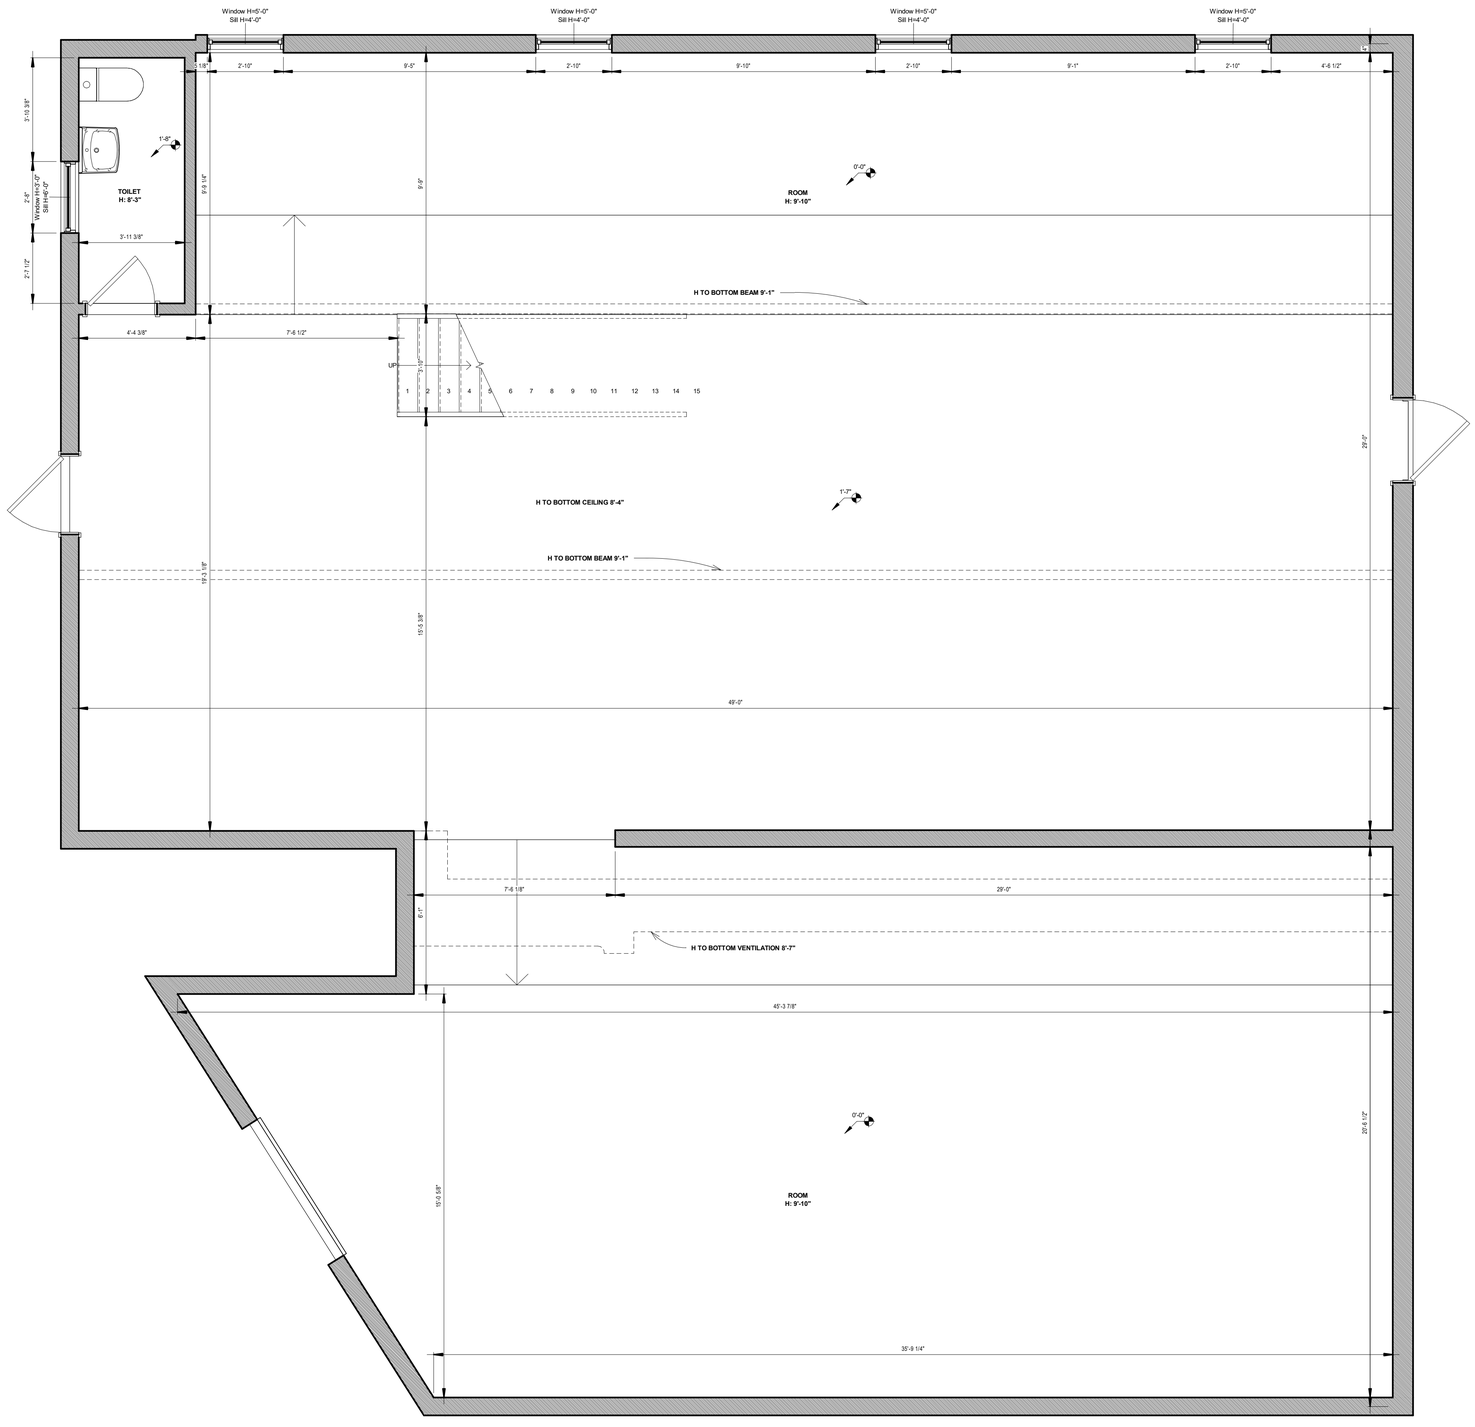

1 As-built First Floor
3/8" = 1'-0"

AREA - 2400 SF

Building #7

DOCUMENTATION & DETAILING

Plan A Services Inc.
70 Gilbert St
Monroe NY 10950

718.219.4749

info@planaservices.com
planaservices.com

Project

17 Bannard St,
Freehold, NJ 07728,
United States

Drawing

As-built Floor Plan

A - 001.00

Area	5700 SF
Scale	3/8" = 1'-0"
Date	04/16/2022
Drawn By	O. P.
Notes	