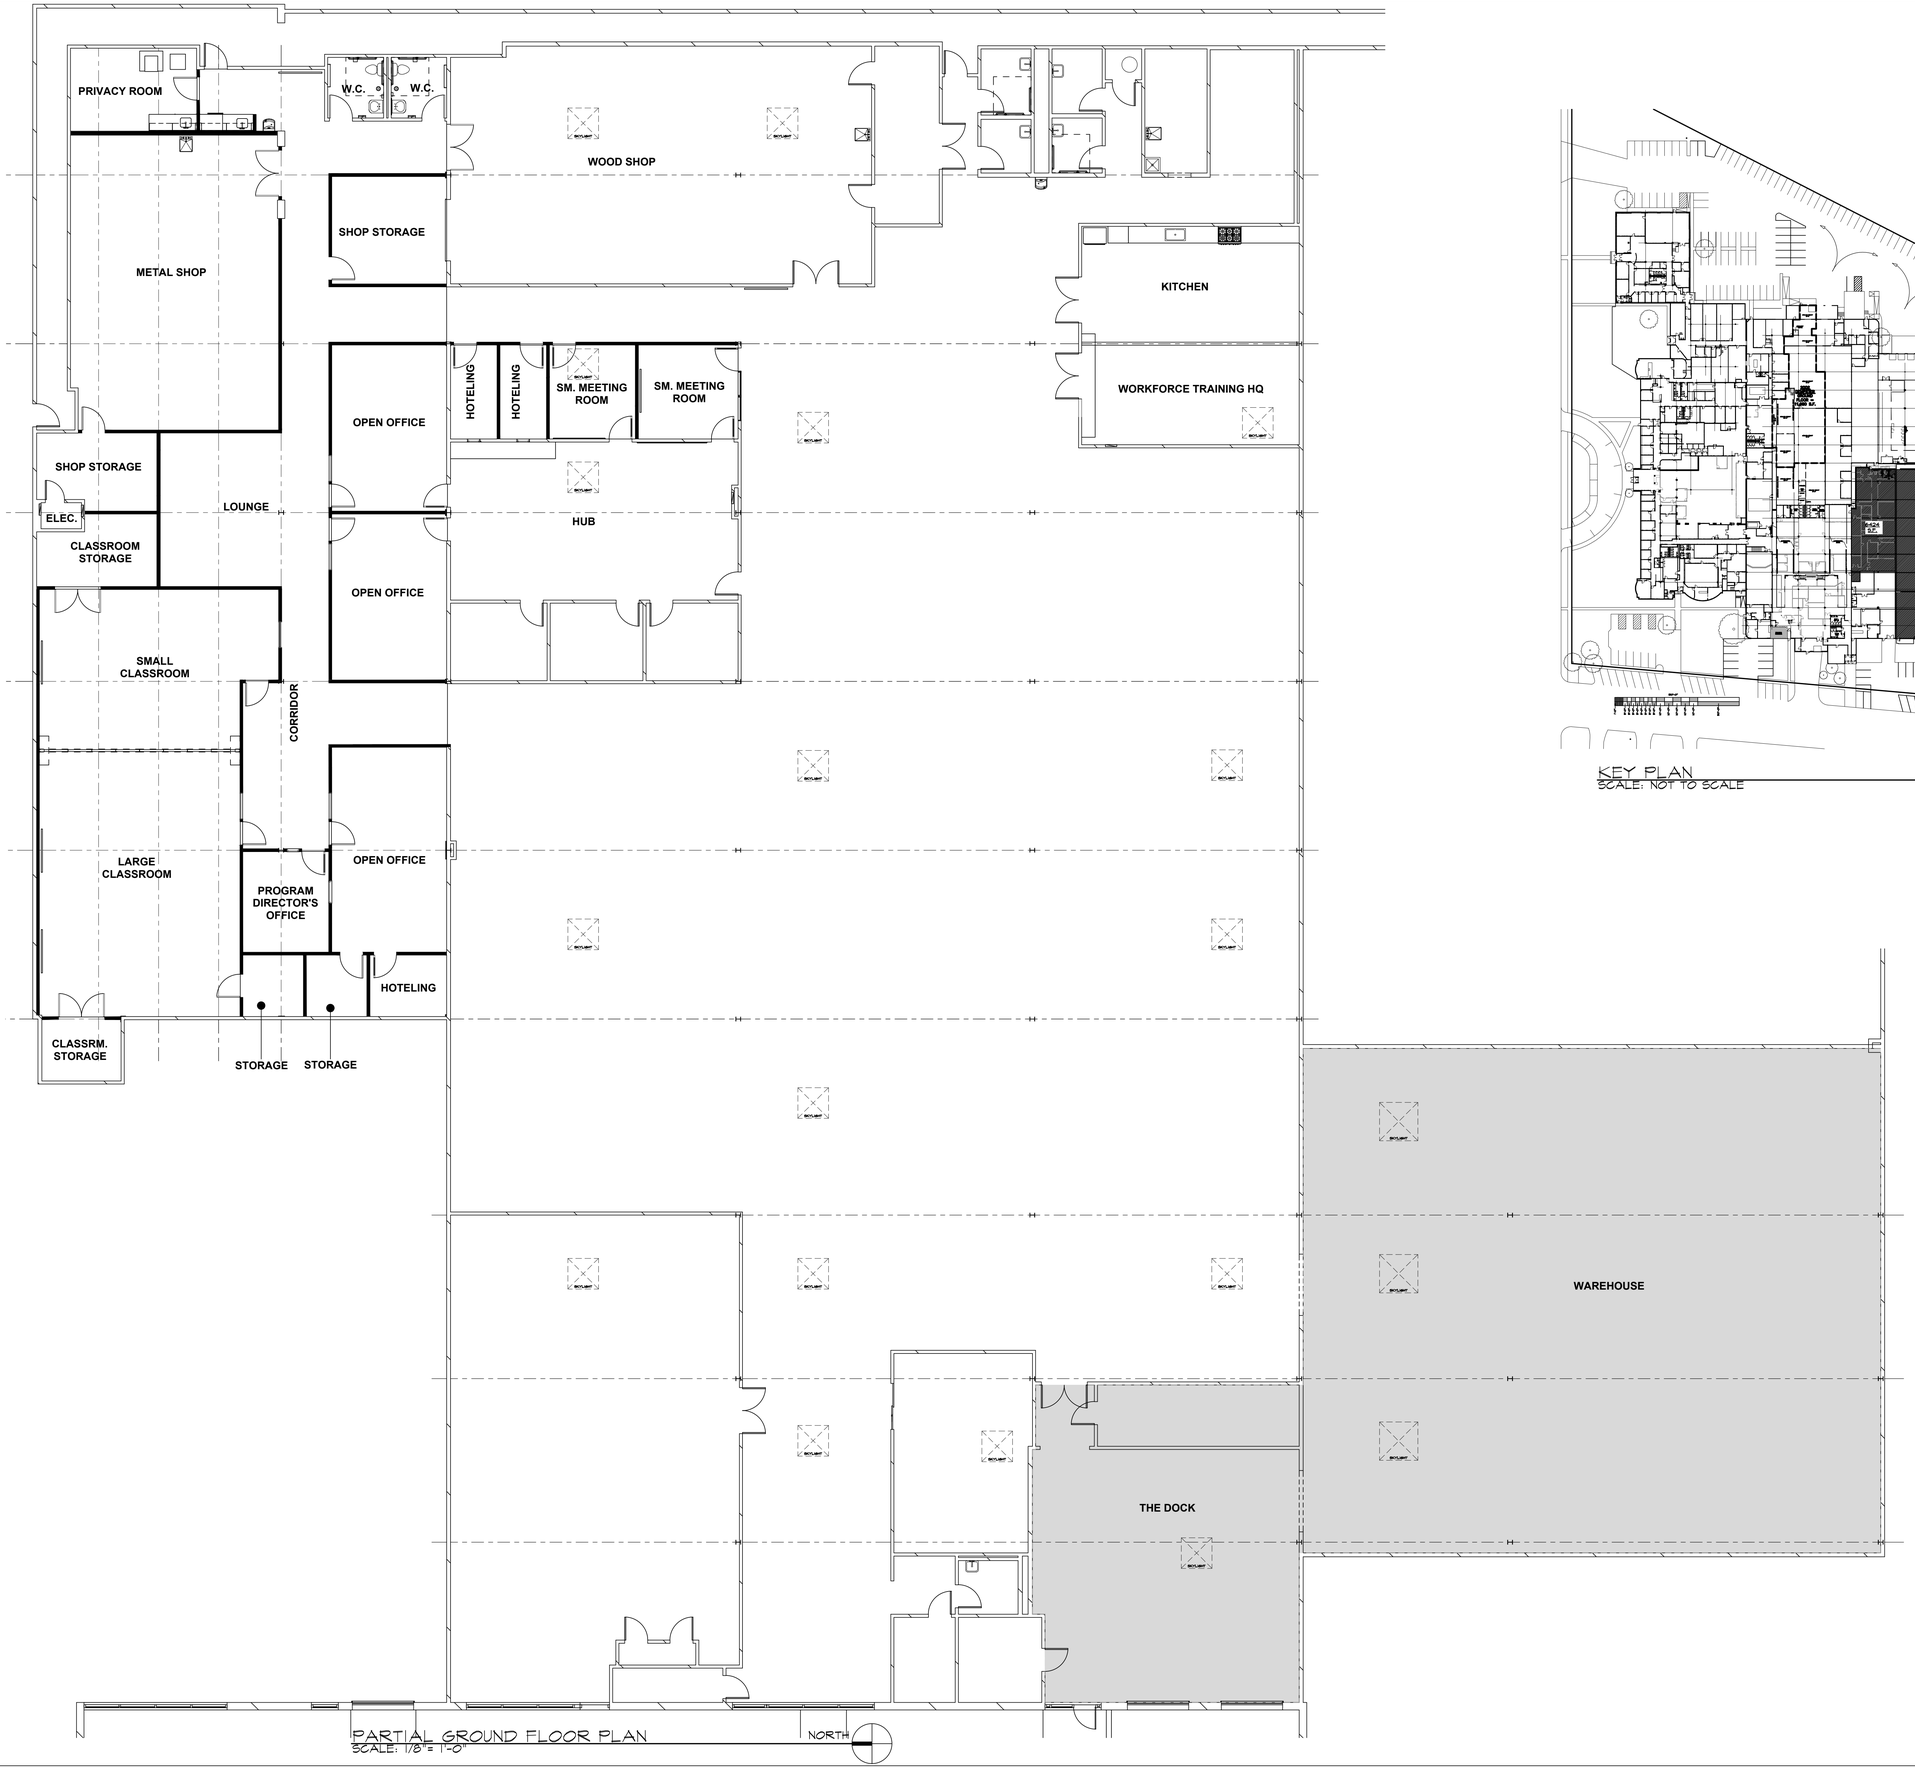

PARTIAL GROUND FLOOR PLAN
SCALE: 1/8" = 1'-0"

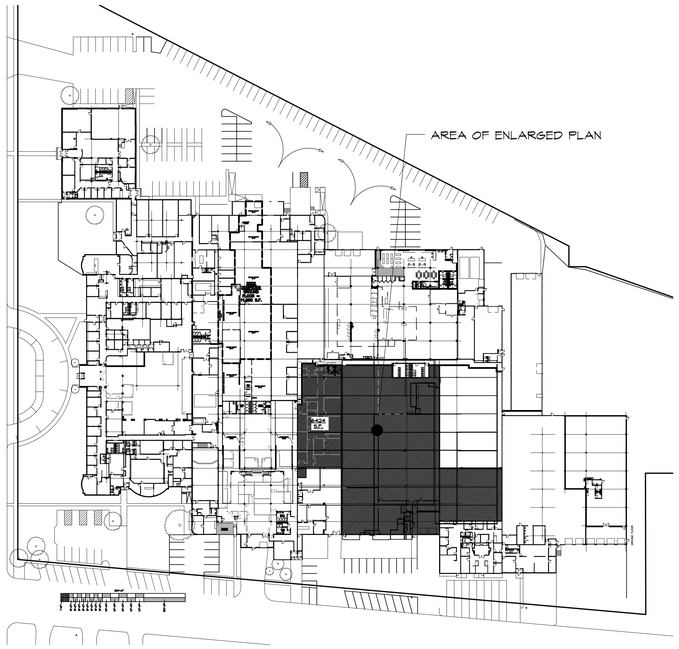

KEY PLAN
SCALE: NOT TO SCALE

BUILDING:
1245 HARTREY AVENUE
EVANSTON, LLINOIS

Project 12-141 AS-BUILT DRAWINGS	K. PETERSON ASSOCIATES ARCHITECTS 315 W. SPRING AVENUE NAPERVILLE, ILLINOIS 60540 PH 630.548.1315 KPETERSON@ARCHITECTS.COM
Date 1-22-26 **Revisions**	**Sheet** 1 of 1

COPYRIGHT 2026 Kevin Peterson & Associates INC.

D:\Drafting Table\K. Peterson Assoc. Dropbox\Kevin Peterson\K Peterson Associates\Job Files\12-141 – 2020 Dempster Base Building\12-141 – As-Built – Marketing – 2026-01-22.dwg SCP1 Jan 22, 2026 1:22:01 pm