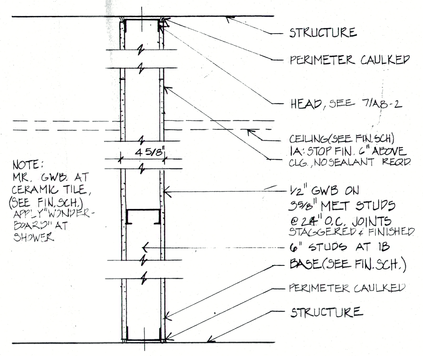

1 1A 1B TYP. PARTITION; 3 5/8" METAL STUD
SCALE: 1 1/2" = 1'-0"

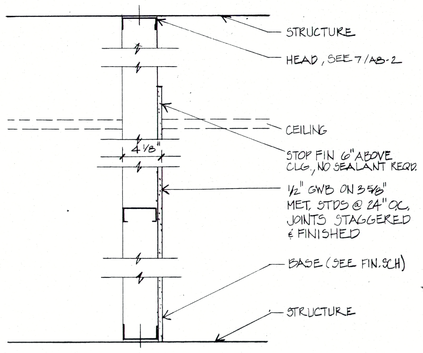

2 FURRING; 3 5/8 METAL STUD
SCALE: 1 1/2" = 1'-0"

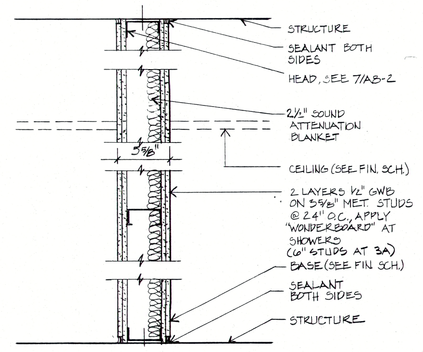

3 3A 2-HR PARTITION; 3 5/8" MET. STUD
SCALE: 1 1/2" = 1'-0" U.L. #412

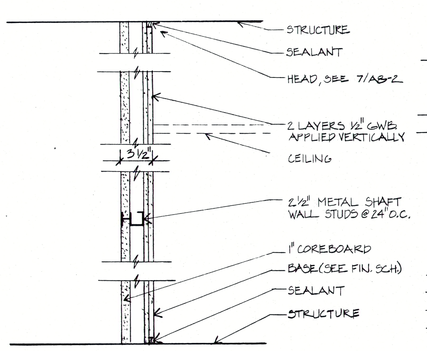

4 2-HR PARTITION; SHAFT WALL
SCALE: 1 1/2" = 1'-0" U.O.F.C., 4/2/75, 2 HR.

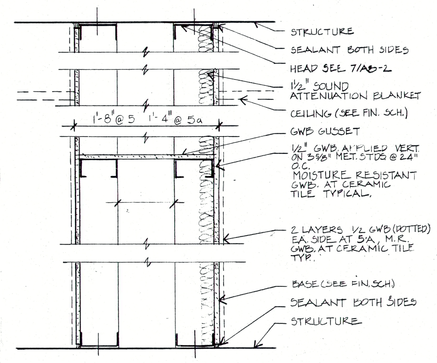

5 5A TYP. CHASE WALL
SCALE: 1 1/2" = 1'-0"

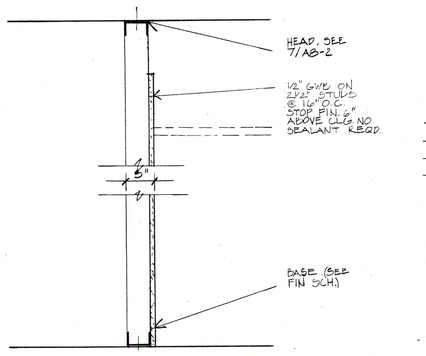

6 FURRING 2 1/2" METAL STUD
SCALE: 1 1/2" = 1'-0"

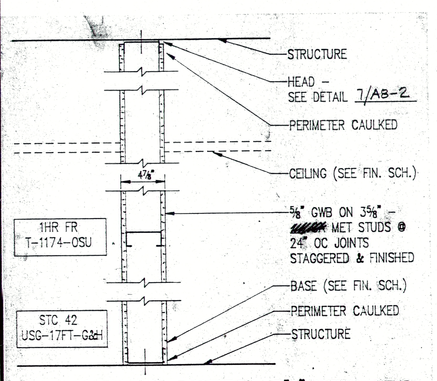

7 1-HR PARTITION; 3 5/8" METAL STUD
SCALE: 1 1/2" = 1'-0"
09251.15

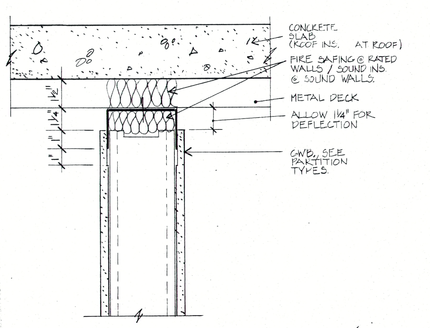

7 TYP PARTITION HEAD - ALL GWB PARTITIONS
SCALE: 3" = 1'-0"

FRAME & DOOR SCHEDULE

LINE ITEM	OPENG. NO.	LOCATION	OPENING LABEL	FRAME MATERIAL	FRAME TYPE	JAMB OPENING WIDTH	JAMB OPENING HEIGHT	JAMB OPENING DEPTH	DETAIL HEAD	DETAIL JAMB	DOOR TYPE	DOOR MATERIAL	THRESHOLD	UNDERCUT	HARDWARE SET	SECURITY	REMARKS
1	101 A	VESTIBULE		AL		6'-0"	8'-6"				PR	AL	AL				SEE SHEET A8-1, 1
2	102 A	LOBBY		AL		6'-0"	8'-0"				PR	AL	AL				SEE SHEET A8-1 6
3	102 B	LOBBY		AL		6'-0"	8'-6"				PR	AL					SEE SHEET A8-1 22
4	103 A	ATRIUM		AL		6'-0"	8'-6"				PR	AL	AL				SEE SHEET A8-1, 3
5	~~104 A~~	~~OFFICE~~		~~HM~~	~~2~~	~~3'-0"~~	~~7'-0"~~		1	~~1 5CM~~	~~F~~	~~WD~~					
6	~~105 A~~	~~OFFICE~~		~~HM~~	~~2~~	~~3'-0"~~	~~7'-0"~~		1	~~5CM~~	~~F~~	~~WD~~					
7	~~106 A~~	~~LOUNGE~~		~~HM~~	~~2~~	~~3'-0"~~	~~7'-0"~~		1	~~5CM~~	~~F~~	~~WD~~					
8	~~106 B~~	~~LOUNGE~~		~~AL~~								~~AL~~					~~SEE SHEET A8-1, 14~~
9	~~107 A~~	~~TRAINING~~		~~HM~~	~~1~~	~~3'-0"~~	~~7'-0"~~		1	1	~~F~~	~~WD~~					
10	~~107 B~~	~~TRAINING~~		~~HM~~	~~1~~	~~3'-0"~~	~~7'-0"~~		1	1	~~F~~	~~WD~~					
11	109 A	JANITOR		HM	1	2'-8"	7'-0"		1	1	F	WD					
12	110 A	TOILET		HM	1	2'-8"	7'-0"		1	1	F	WD					
13	111 A	TOILET		HM	1	2'-8"	7'-0"		1	1	F	WD					
14	112 A	OFFICE		AL		6'-0"	8'-6"					AL	AL				SEE SHEET A8-1, 6
15	112 B	OFFICE	B	HM	1	3'-0"	7'-0"		1	1	N	WD					
16	113 A	JANITOR		HM	1	2'-8"	7'-0"		1	1	F	WD					
17	114 A	TOILET		HM	1	2'-8"	7'-0"		1	1	F	WD	MAB				
18	115 A	HANDICAP TOILET		HM	1	2'-8"	7'-0"		1	1	F	WD	MAB				
19	116 A	ELEVATOR MACH. ROOM	B	HM	1	3'-0"	7'-0"		1	1	F	WD					
20	~~117 A~~	~~STORAGE~~		~~HM~~	~~1~~	~~3'-0"~~	~~7'-0"~~		~~1~~	~~1~~	~~F~~	~~WD~~					
21	118 A	WATER METER ROOM		HM	1	3'-0"	7'-0"		1	1	F	WD					
22	119 A	ELECTRICAL CLOSET		HM	3	6'-0"	7'-0"		1	1	PR-F	WD					
23	~~108 A~~	~~OFFICE~~		~~HM~~	~~1~~	~~3'-0"~~	~~7'-0"~~		~~1~~	~~1~~	~~F~~	~~WD~~					
24	~~108 B~~	~~OFFICE~~		~~AL~~		~~3'-0"~~	~~8'-6"~~	~~NOTE~~	~~4/AA-1~~			~~AL~~					~~SEE SHEET A8-1, 14~~
25	112 C	OFFICE		AL		3'-0"	8'-6"	NOTE	4/AA-1			AL					SEE SHEET A8-1, 14
26	103 B	ATRIUM		AL		3'-0"	8'-6"	NOTE	4/AA-1			AL					SEE SHEET A8-1, 14
27																	
28																	
29																	
30																	
31	202 A	CONFERENCE		HM	4	2'-0"	7'-0"		1	2	PR-F	WD					
32	~~203 A~~	~~OFFICE~~		~~HM~~	~~5~~	~~2'-8"~~	~~7'-0"~~		~~1~~	~~3~~	~~F~~	~~WD~~					
33	~~204 A~~	~~TOILET~~		~~HM~~	~~1~~	~~2'-8"~~	~~7'-0"~~		~~1~~	~~1~~	~~F~~	~~WD~~	~~MAB~~				
34	~~205 A~~	~~TOILET~~		~~HM~~	~~1~~	~~2'-8"~~	~~7'-0"~~		~~1~~	~~1~~	~~F~~	~~WD~~	~~MAB~~				
35	~~206 A~~	~~OFFICE~~		~~HM~~	~~5~~	~~2'-8"~~	~~7'-0"~~		~~3~~	~~3~~	~~F~~	~~WD~~					
36	207 A	OFFICE	B	HM	1	3'-0"	7'-0"		1	1	N	WD					
37	208 A	TEL / ELEC. CLOSET		HM	3	6'-0"	7'-0"		1	1	PR-F	WD					
38																	
39	209 A	OFFICE	B	HM	1	3'-0"	7'-0"		1	1	N	WD					
40	210 A	HANDICAP TOILET		HM	1	2'-8"	7'-0"		1	1	F	WD					
41	211 A	TOILET		HM	1	2'-8"	7'-0"		1	1	F	WD	MAB				
42	212 A	JANITOR		HM	1	2'-8"	7'-0"		1	1	F	WD					
43	213 A	HANDICAP TOILET		HM	1	2'-8"	7'-0"		1	1	F	WD	MAB				
44	214 A	TOILET		HM	1	2'-8"	7'-0"		1	1	F	WD	MAB				
45	215 A	JANITOR		HM	1	2'-8"	7'-0"		1	1	F	WD					
46	216 A	CLOSET		HM	1	3'-0"	7'-0"		1	1	F	WD					
47	~~217 A~~	~~OFFICE~~		~~HM~~	~~2~~	~~3'-0"~~	~~7'-0"~~		~~3~~	~~3~~	~~F~~	~~WD~~					
48	~~218 A~~	~~OFFICE~~		~~HM~~	~~2~~	~~3'-0"~~	~~7'-0"~~		~~3~~	~~3~~	~~F~~	~~WD~~					
49	~~219 A~~	~~OFFICE~~		~~HM~~	~~2~~	~~3'-0"~~	~~7'-0"~~		~~3~~	~~3~~	~~F~~	~~WD~~					
50	~~220 A~~	~~OFFICE~~		~~HM~~	~~2~~	~~3'-0"~~	~~7'-0"~~		~~3~~	~~3~~	~~F~~	~~WD~~					
51																	
52																	
53																	
54																	
55																	
56	ST-1 A	STAIR NO. 1 @ GND FL.	B	HM	1	3'-0"	8'-0"		1	1	N						
57	ST-2 A	STAIR NO. 2 @ GND FL.		HM	1	3'-0"	8'-0"			8	F	HM	AL				ATTACH MET. PANEL TO DOOR, USE SPECIAL HINGES
58																	
59																	
ROOM FINISH SCHEDULE

ROOM NUMBER	ROOM NAME	FLOOR	BASE	WAINSCOT MAT'L	WAINSCOT FIN	WAINSCOT HT	WALLS NORTH MAT'L	WALLS NORTH FIN	WALLS EAST MAT'L	WALLS EAST FIN	WALLS SOUTH MAT'L	WALLS SOUTH FIN	WALLS WEST MAT'L	WALLS WEST FIN	CEILING MAT'L	CEILING FIN	CEILING HT	REMARKS
101	VESTIBULE	"LOUNGE MAT"	VIN								GWB	PT			GWB	PT	8'-8"	
102	LOBBY	CPT	VIN				GWB	PT	GWB	PT	GWB	PT	GWB	PT	1x1 ACT / GWB	PT	8'-8" / 10'-2"	
103	ATRIUM	CPT	VIN				GWB	PT	GWB	PT	GWB	PT	GWB	PT	1x1 ACT / GWB	PT	21'-10"	SEE A8-1 FOR INTERIOR ELEVATIONS
~~104~~	~~OFFICE~~	~~CPT~~	~~VIN~~				~~GWB~~	~~PT~~	~~GWB~~	~~PT~~	~~GWB~~	~~PT~~			~~2x2 ACT~~		~~8'-8"~~	
~~105~~	~~OFFICE~~	~~CPT~~	~~VIN~~				~~GWB~~	~~PT~~	~~GWB~~	~~PT~~	~~GWB~~	~~PT~~			~~2x2 ACT~~		~~8'-8"~~	
~~106~~	~~LOUNGE~~	~~CPT~~	~~VIN~~				~~GWB~~	~~PT~~	~~GWB~~	~~PT~~	~~GWB~~	~~PT~~			~~2x2 ACT~~		~~8'-8"~~	
~~107~~	~~TRAINING~~	~~CPT~~	~~VIN~~				~~GWB~~	~~PT~~			~~GWB~~	~~PT~~	~~GWB~~	~~PT~~	~~2x2 ACT~~		~~8'-8"~~	
~~108~~	~~OFFICE~~	~~CPT~~	~~VIN~~				~~GWB~~	~~PT~~	~~GWB~~	~~PT~~	~~GWB~~	~~PT~~	~~GWB~~	~~PT~~			~~8'-8"~~	
109	JANITOR	VAT	VIN				GWB	PT	GWB	PT	GWB	PT	GWB	PT	GWB	PT	8'-8"	
110	TOILET	CT	CT				GWB	PT	GWB	PT	GWB	PT	CT		GWB	PT	8'-8"	
111	TOILET	CT	CT				GWB	PT	CT		GWB	PT	GWB	PT	GWB	PT	8'-8"	
112	OFFICE	CPT	VIN				GWB	PT	GWB	PT	GWB	PT	GWB	PT			8'-8"	
113	JANITOR	VAT	VIN				GWB	PT	GWB	PT	GWB	PT	GWB	PT	GWB	PT	8'-8"	
114	TOILET	CT	CT				GWB	PT	CT		GWB	PT	GWB	PT	GWB	PT	8'-0"	
115	HANDICAP TOILET	CT	CT				GWB	PT	GWB	PT	GWB	PT	CT		GWB	PT	8'-8"	
116	ELEVATOR MACH. RM.	CONC	VIN				GWB	PT	GWB	PT	GWB	PT	GWB	PT	GWB	PT	8'-8"	
~~117~~	~~STORAGE~~	~~VAT~~	~~VIN~~				~~GWB~~	~~PT~~	~~GWB~~	~~PT~~	~~GWB~~	~~PT~~	~~GWB~~	~~PT~~	~~GWB~~	~~PT~~	~~8'-8"~~	2 HR. RATED CEILING, SEE 2/A6-1
118	WATER METER ROOM	VAT	VIN				GWB	PT	GWB	PT	GWB	PT	GWB	PT	GWB	PT	7'-0"	" "
119	ELECTRICAL CLOSET	CPT	VIN				GWB	PT	GWB	PT	GWB	PT	GWB	PT	GWB	PT	8'-8"	
~~120~~	~~CORRIDOR~~	~~CPT~~	~~VIN~~						~~GWB~~	~~PT~~	~~.~~		~~GWB~~	~~PT~~	~~2x2 ACT~~		~~8'-8"~~	
201	LOBBY	CPT	VIN				GWB	PT	GWB	PT	GWB	PT	GWB	PT	GWB	PT	8'-6"	
202	CONFERENCE	CPT	VIN				GWB	PT	GWB	PT	GWB	PT	GWB	PT	GWB	PT	8'-6" / 10'-0"	
~~203~~	~~OFFICE~~	~~CPT~~	~~VIN~~				~~GWB~~	~~PT~~	~~GWB~~	~~PT~~	~~GWB~~	~~PT~~	~~GWB~~	~~PT~~	~~2x2 ACT/GWB~~	~~PT~~	~~8'-6"~~	
204	TOILET	CT	CT				CT		CT	PT / GWB	CT	PT / GWB			GWB	PT	8'-6"	
~~205~~	~~TOILET~~	~~CT~~	~~CT~~				CT		CT		CT				~~2x2 ACT/GWB~~	~~PT~~	~~8'-6"~~	
~~206~~	~~OFFICE~~	~~CPT~~	~~VIN~~				~~GWB~~	~~PT~~	~~GWB~~	~~PT~~	~~GWB~~	~~PT~~	~~GWB~~	~~PT~~	~~2x2 ACT/GWB~~	~~PT~~	~~8'-6"~~	
~~207~~	~~OFFICE~~	~~CPT~~	~~VIN~~				~~GWB~~	~~PT~~	~~GWB~~	~~PT~~	~~GWB~~	~~PT~~	~~GWB~~	~~PT~~	~~2x2 ACT~~		~~8'-6"~~	
208	ELEC./TEL. CLOSET	CPT	VIN				GWB	PT	GWB	PT	GWB	PT	GWB	PT	GWB	PT	8'-6"	
~~209~~	~~OFFICE~~	~~CPT~~	~~VIN~~				~~GWB~~	~~PT~~	~~GWB~~	~~PT~~	~~GWB~~	~~PT~~	~~GWB~~	~~PT~~	~~2x2 ACT~~		~~8'-6"~~	
210	HANDICAP TOILET	CT	CT				GWB	PT	CT		GWB	PT	GWB	PT	GWB	PT	8'-6"	
211	TOILET	CT	CT				GWB	PT	GWB	PT	GWB	PT	CT		GWB	PT	8'-6"	
212	JANITOR	CONC.	VIN				GWB	PT	GWB	PT	GWB	PT	GWB	PT	GWB	PT	8'-6"	
213	HANDICAP TOILET	CONC.					GWB		GWB		GWB		GWB		GWB		8'-6"	FIXTURES & FINISHES N.I.C. FOR ROOMS # 213, 214, & 215.
214	TOILET	CONC.					GWB		GWB		GWB		GWB		GWB		8'-6"	
215	JANITOR	VAT	VIN				GWB		GWB		GWB		GWB		GWB		8'-6"	
216	CLOSET	CPT	VIN				GWB	PT	GWB	PT	GWB	PT	GWB	PT	GWB	PT	8'-6"	
~~217~~	~~OFFICE~~	~~CPT~~	~~VIN~~				~~GWB~~	~~PT~~	~~GWB~~	~~PT~~	~~GWB~~	~~PT~~	~~GWB~~	~~PT~~	~~2x2 ACT/GWB~~	~~PT~~	~~8'-6"~~	
~~218~~	~~OFFICE~~	~~CPT~~	~~VIN~~				~~GWB~~	~~PT~~	~~GWB~~	~~PT~~	~~GWB~~	~~PT~~	~~GWB~~	~~PT~~	~~2x2 ACT/GWB~~	~~PT~~	~~8'-6"~~	
ST. - 1	STAIR # 1	CPT	VIN				GWB	PT	GWB	PT	GWB	PT	GWB	PT	GWB	PT		
ST. - 2	STAIR # 2	CPT	VIN				GWB	PT	GWB	PT	GWB	PT	GWB	PT	GWB	PT		
~~219~~	~~OFFICE~~	~~CPT~~	~~VIN~~				~~GWB~~	~~PT~~	~~GWB~~	~~PT~~	~~GWB~~	~~PT~~	~~GWB~~	~~PT~~	~~2x2 ACT/GWB~~	~~PT~~	~~8'-6"~~	
~~220~~	~~OFFICE~~	~~CPT~~	~~VIN~~				~~GWB~~	~~PT~~	~~GWB~~	~~PT~~	~~GWB~~	~~PT~~	~~GWB~~	~~PT~~	~~2x2 ACT/GWB~~	~~PT~~	~~8'-6"~~	

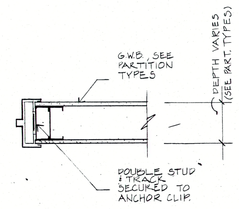

1 JAMB DETAIL, (HEAD SIMILAR)
1 1/2" = 1'-0"

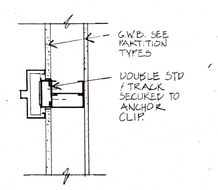

2 JAMB AT WALL
1 1/2" = 1'-0"

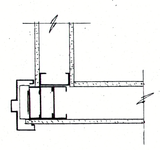

3 JAMB AT CORNER

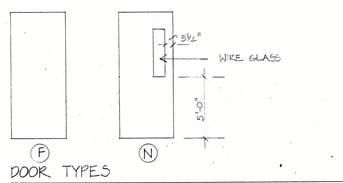

DOOR TYPES
1 1/2" = 1'-0"

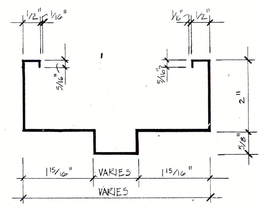

TYPICAL DRYWALL FRAME
NO SCALE

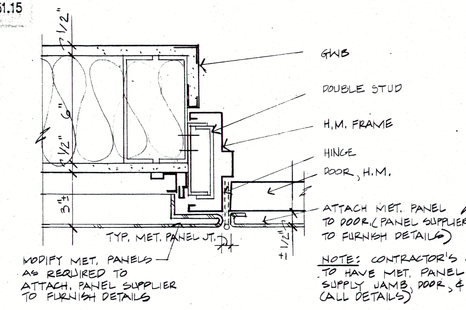

8 JAMB AT METAL PANEL DOOR
3" = 1'-0"

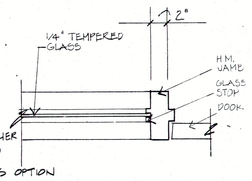

NOTE: CONTRACTOR'S OPTION TO HAVE MET. PANEL SUPPLIER SUPPLY JAMB, DOOR, & HARDWARE. (ALL DETAILS)

4 JAMB AT SIDELIGHT
1 1/2" = 1'-0"

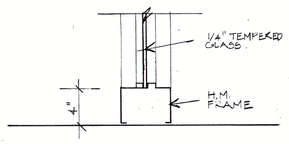

5 SILL AT SIDELIGHT
1 1/2" = 1'-0"

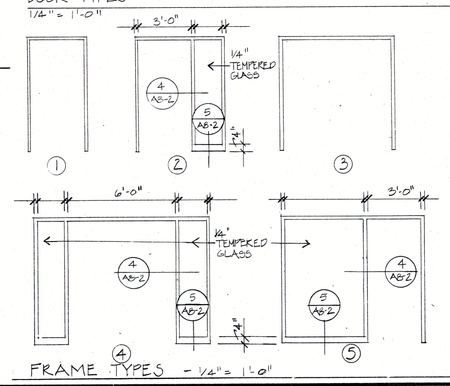

FRAME TYPES - 1/4" = 1'-0"

Sasaki Associates, Inc.
Planning / Architecture / Landscape Architecture
Urban Design / Civil Engineering / Environmental Services
64 Pleasant Street, Watertown, Massachusetts 02172
617/926 3300 Telex 92/2471

NOTES:

1. APPLY WONDERBOARD AT INTERIOR WALLS OF ALL SHOWERS. SEE SPECS.
2. HARDWARE SHALL BE CARRIED AS AN ALLOWANCE BY THE CONTRACTOR. SEE SPEC'S.
3. SEE FLOOR PLAN & PARTITION TYPES FOR JAMB DEPTHS.
4. STUDS AT SHOWERS TO BE 20 GA. MIN. (AT WONDERBOARD).
5. DOORS & FRAMES NOTED AS 'D' LABEL SHALL BE 1 1/2 HOUR RATED DOORS.

NO.	DATE	REVISION

STATE OF CONNECTICUT JOHN RUSSELL OGLEY III REGISTERED ARCHITECT

Salmon Brook Corporate Park

A-Copy Offices

Glastonbury, Connecticut

TITLE:
Partition Types, Door & Finish Schedules

Scale AS NOTED Date 2-12-87
Drawn By BJ
Checked By EM
Approved By
Project No. 5649.02

DWG. NO. A8-2