

OJIBWAY CORRECTIONAL FACILITY

N 5705 OJIBWAY ROAD MARENISCO, MI 49947

PLAN OF PROPOSED WASTEWATER LAGOON DEMOLITION

GOGEBIC COUNTY COUNTY, MICHIGAN


FILE No.: 472/19031.RAA

INDEX No.: 190CF04



www.upea.com

**OJIBWAY CORRECTIONAL FACILITY
WASTEWATER LAGOON DEMOLITION**
MICHIGAN DEPARTMENT OF CORRECTIONS
N5705 OJIBWAY ROAD MARENISCO, MICHIGAN

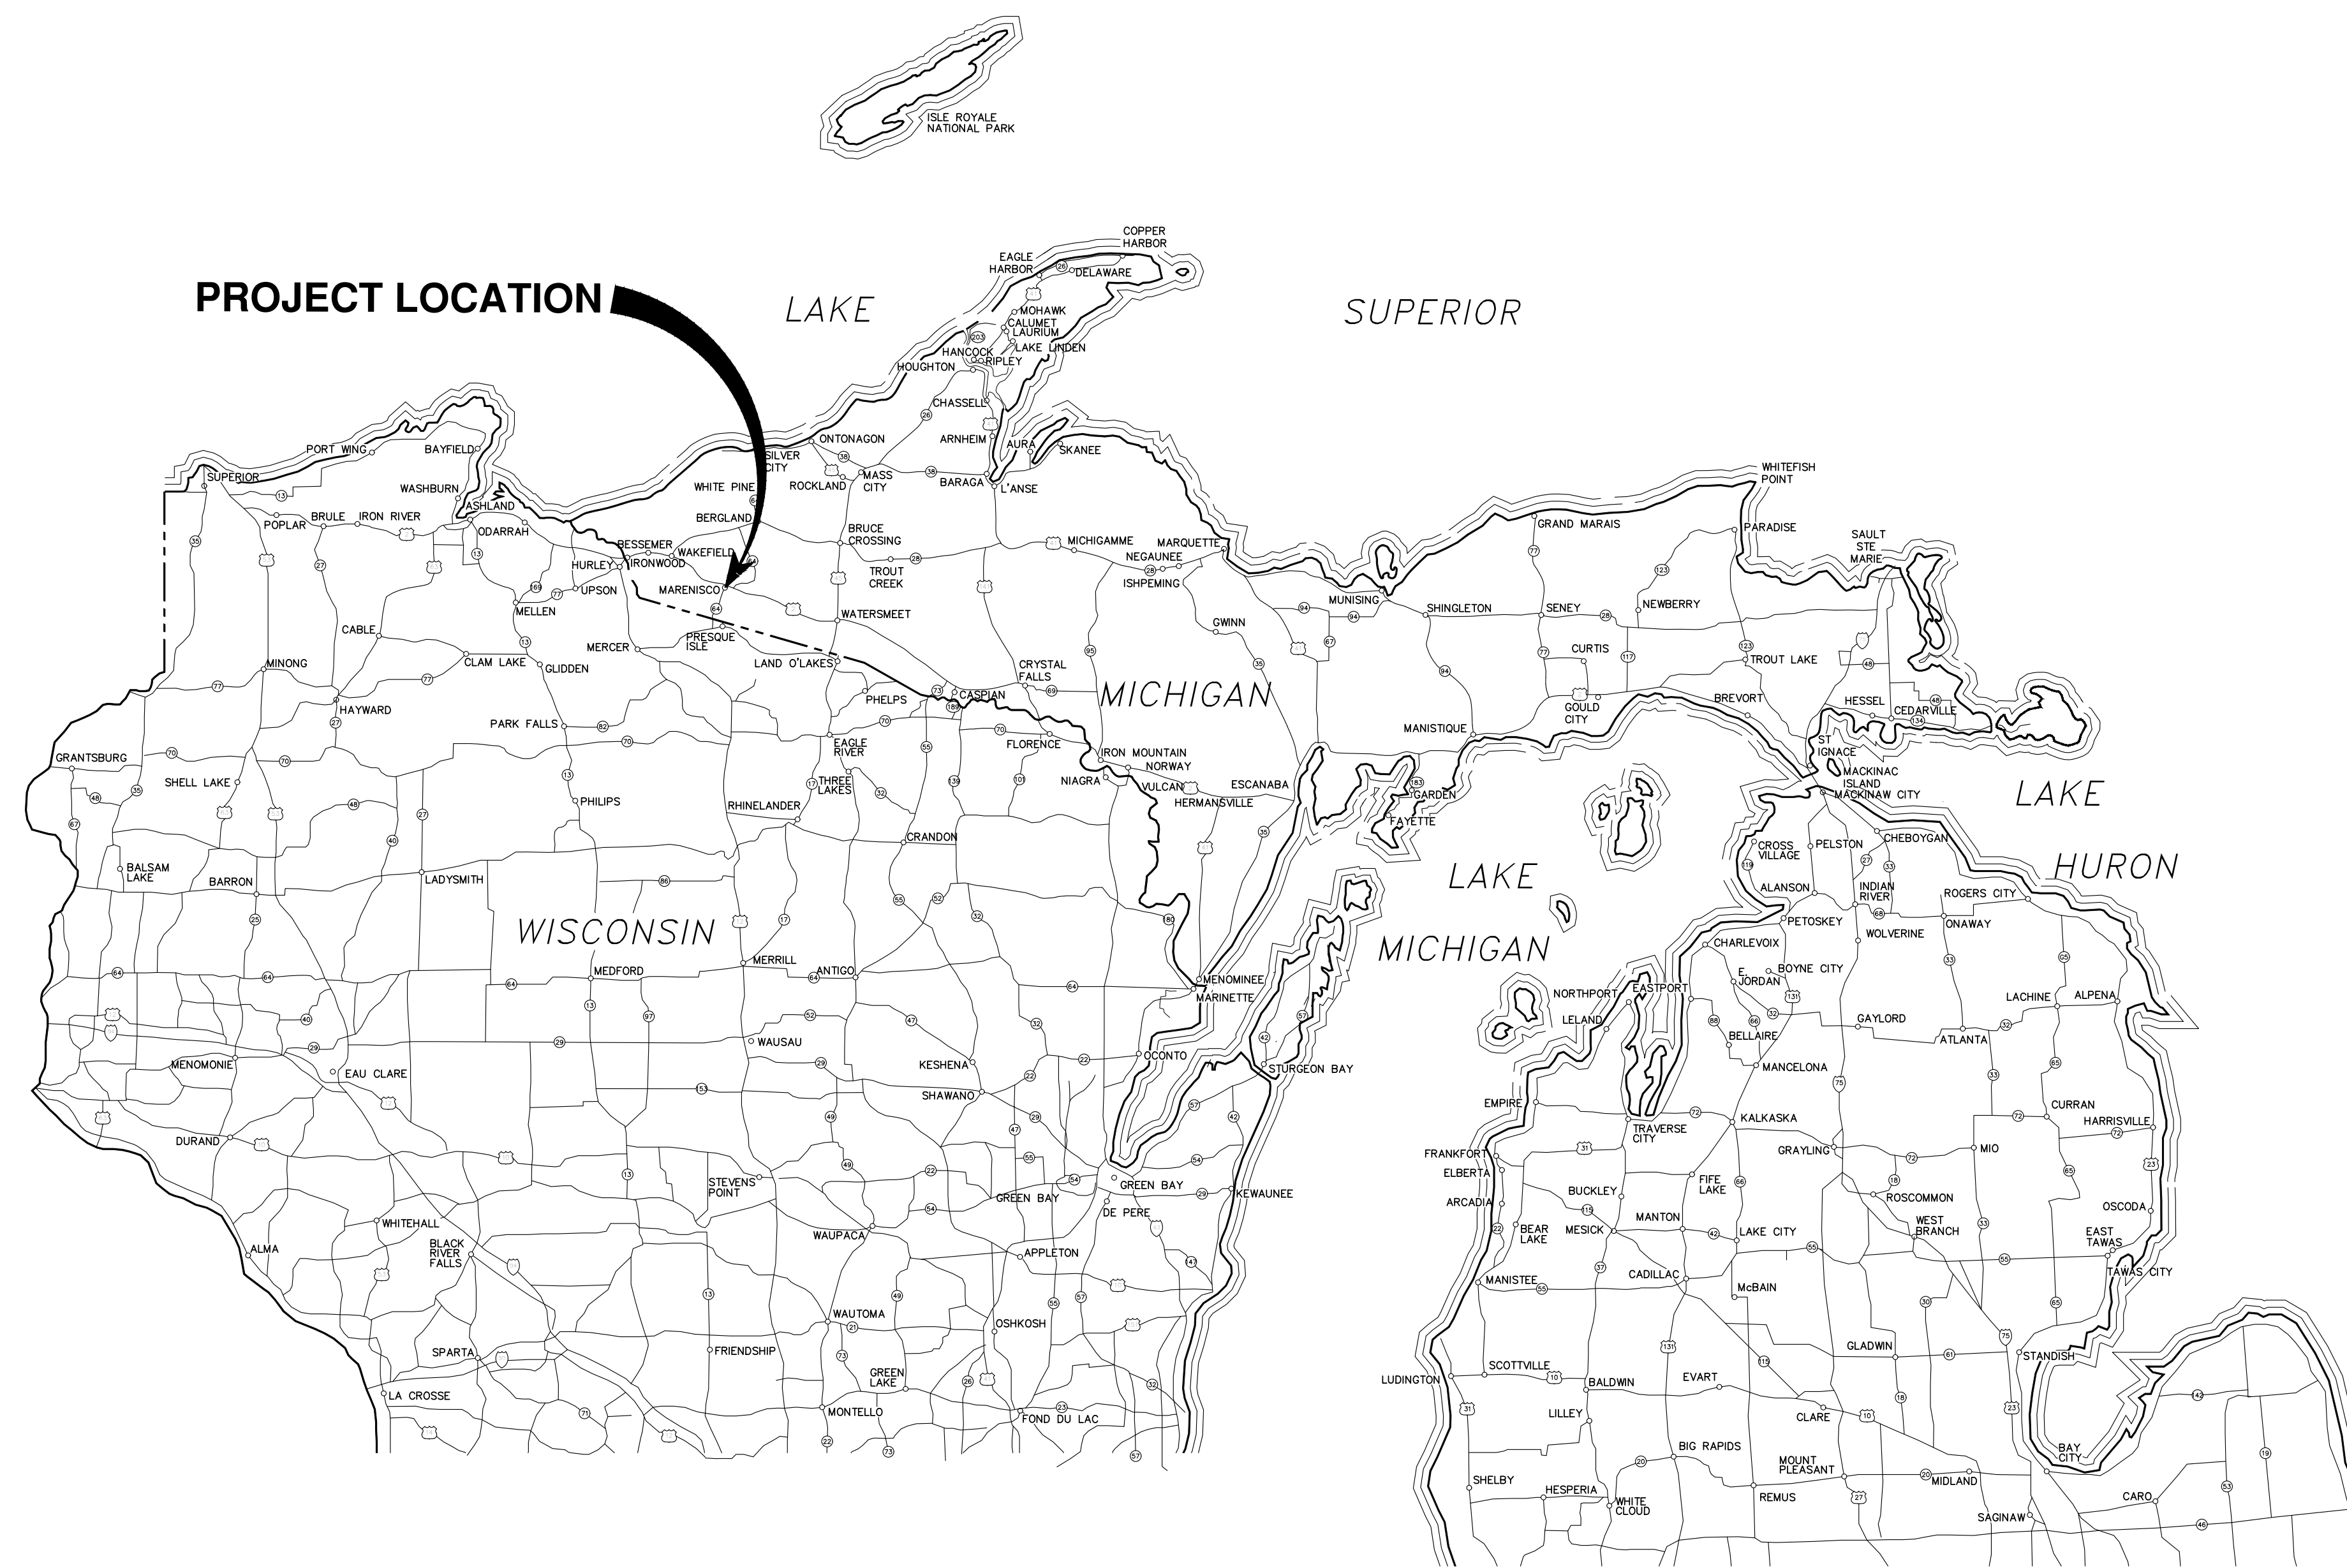

CONTACT LIST:

PROFESSIONAL SERVICE CONTRACTOR
CHRIS HOLMES, P.E.
U.P. ENGINEERS & ARCHITECTS, INC
100 PORTAGE STREET
HOUGHTON, MICHIGAN 49931
(906) 482-4810

INDEX OF SHEETS


NUMBER	SHEET NAME
G001	COVER
C100	EXISTING/DEMO SITE PLAN
C101	BIOSOLIDS QUANTITIES
C102	PROPOSED SITE PLAN
C301	LAGOONS 1 & 2 PROFILE & X-SECTIONS
C302	LAGOONS 3 & 4 PROFILE & X-SECTIONS
C303	LAGOONS 5-8 PROFILE & X-SECTIONS
C501	EXISTING AERATION BUILDING

ISSUED FOR:	DATE:
50% REVIEW	05/20/19
90% REVIEW	06/11/19
100% REVIEW	06/14/19
BIDDING	06/14/19
AS-BUILT	06/08/20

OJIBWAY CORRECTIONAL FACILITY WASTEWATER LAGOON DEMOLITION MICHIGAN DEPARTMENT OF CORRECTIONS	PROJECT NO.: M12-19220	DESIGNED BY: CLH	MEP
		DRAWN BY: CLH	CLH
		CHECKED: CLH	CLH
		APPROVED: CLH	

COVER


G001

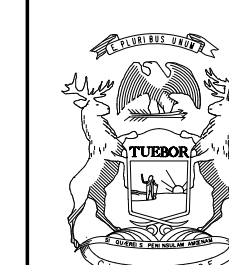

STATE OF MICHIGAN
DEPARTMENT OF TECHNOLOGY, MANAGEMENT AND BUDGET
FACILITIES AND BUSINESS SERVICES ADMINISTRATION
DESIGN AND CONSTRUCTION DIVISION
ROBERT C. HALL, RA, NCARB, DIRECTOR



U.P. ENGINEERS & ARCHITECTS, INC.
ENGINEERING ARCHITECTURE PLANNING SURVEYING ENVIRONMENTAL

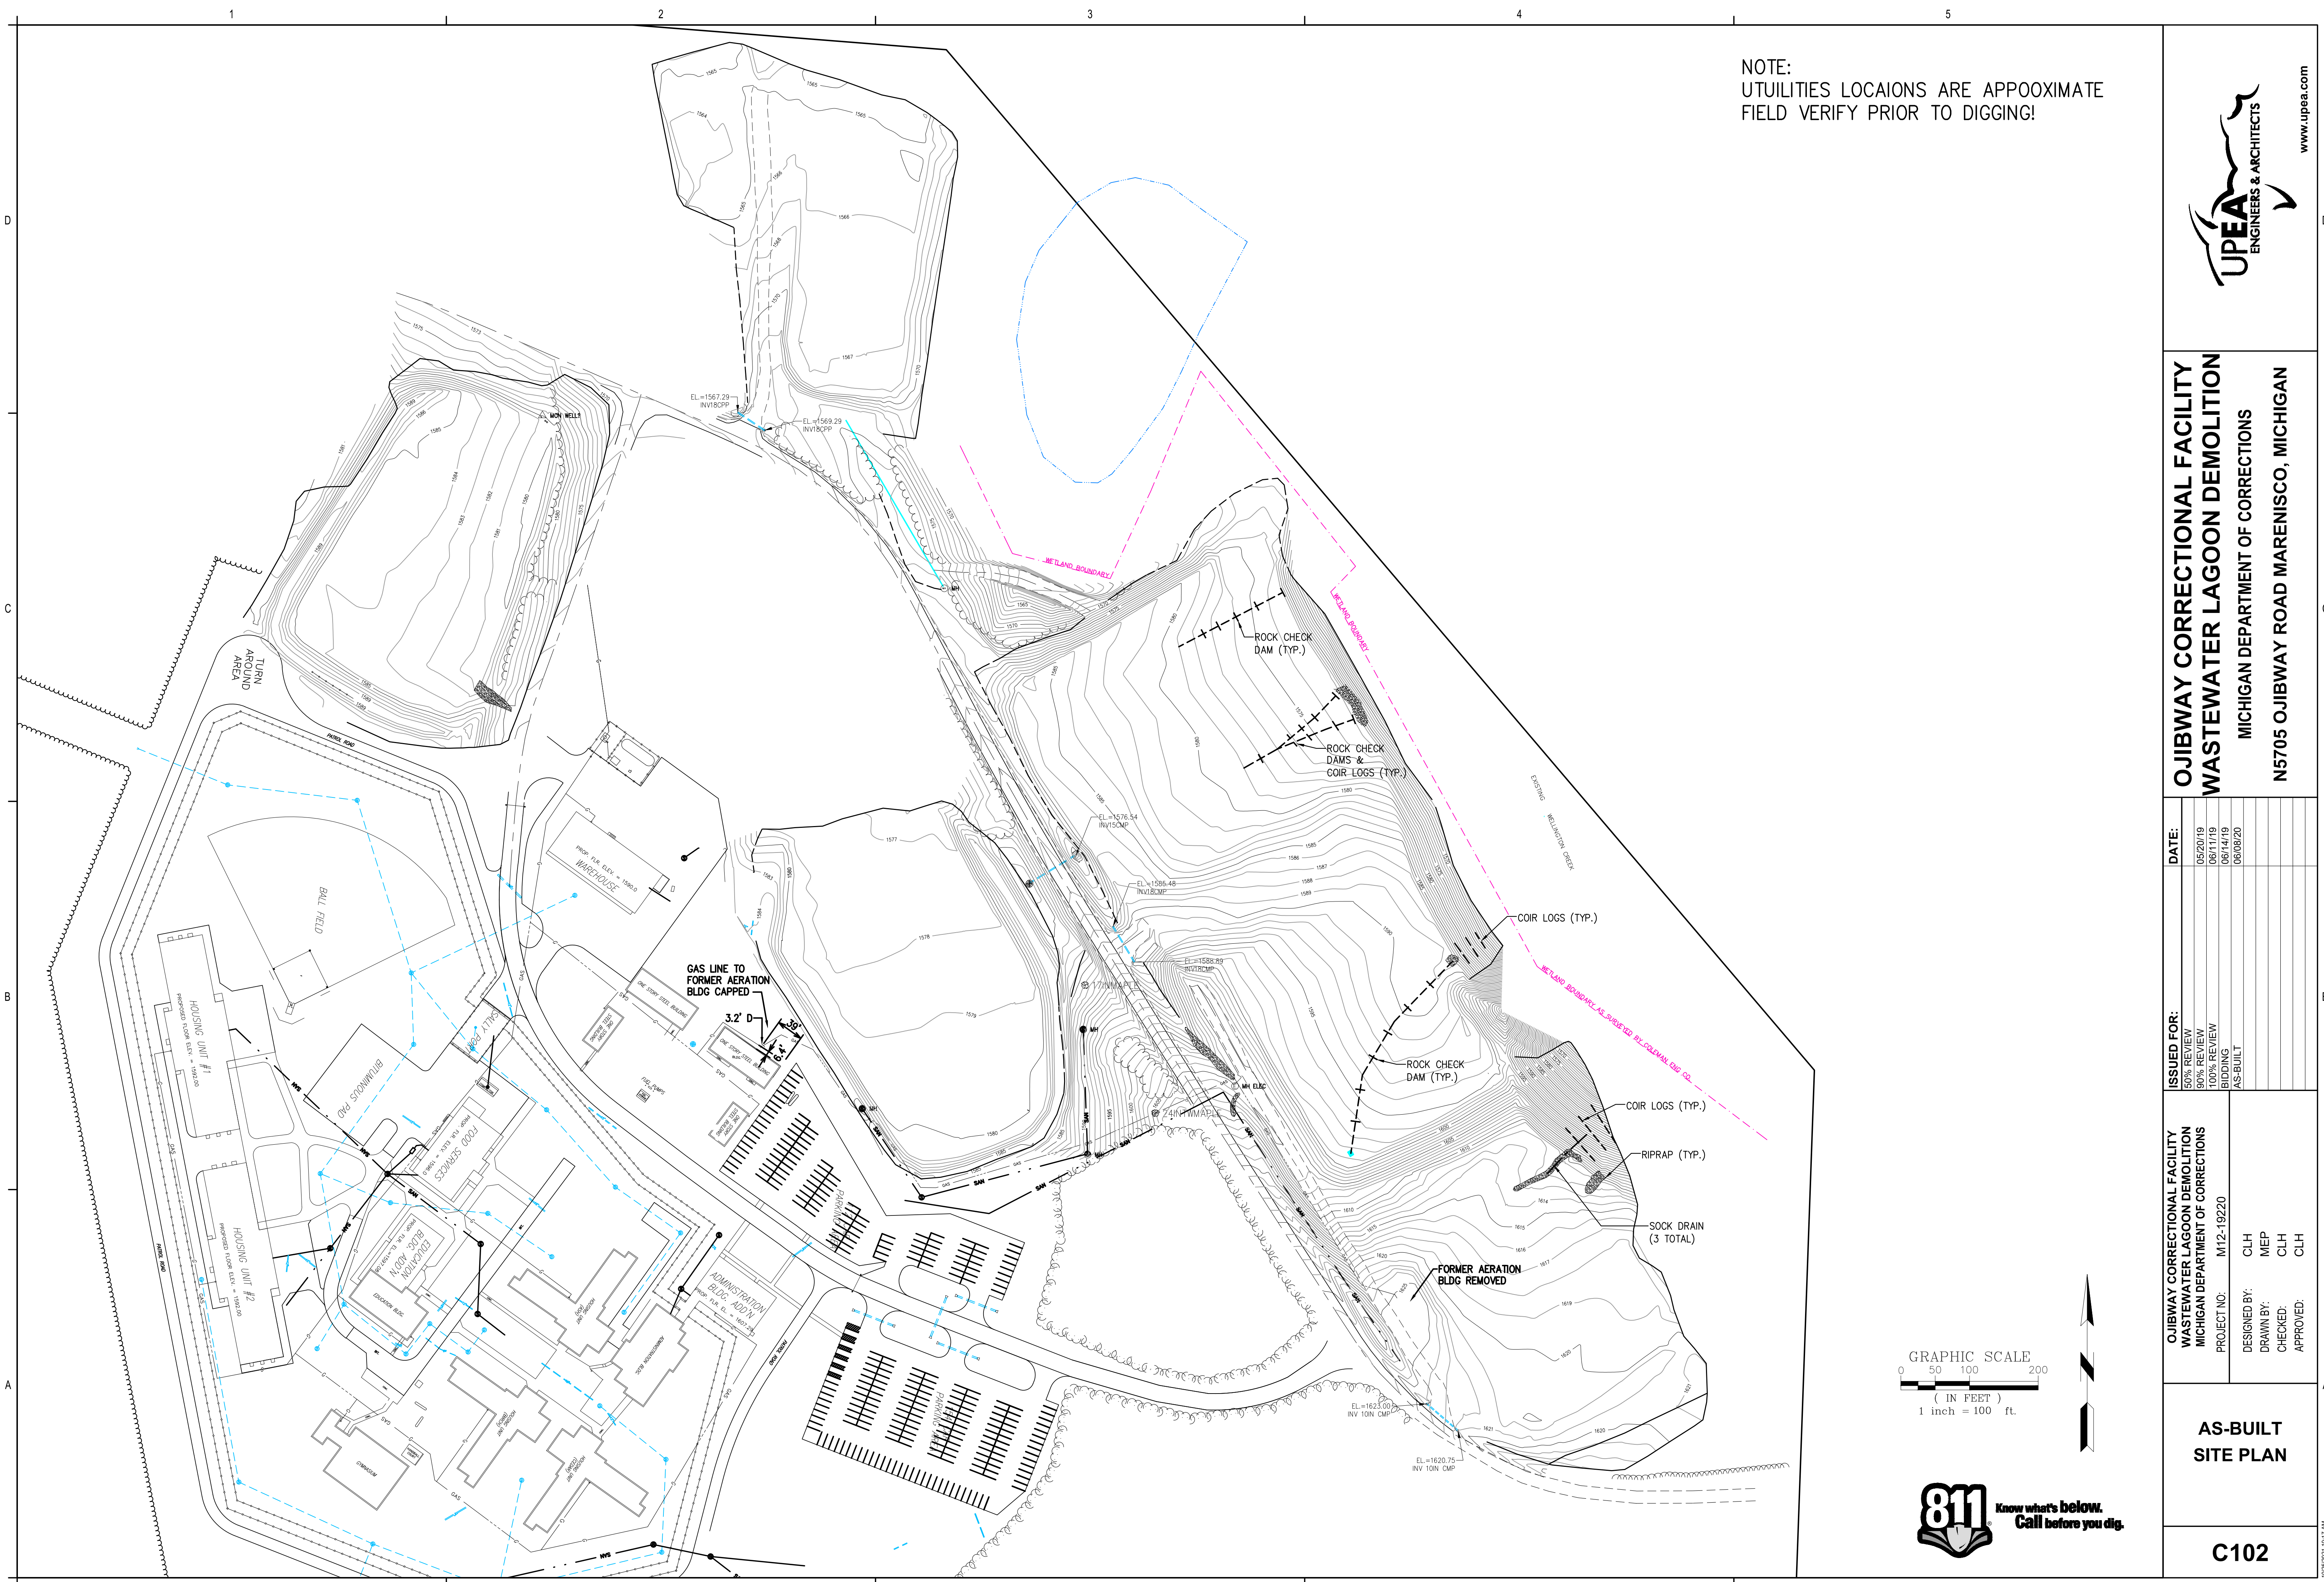

NOTE:
 UTILITIES LOCAIONS ARE APPROXIMATE
 FIELD VERIFY PRIOR TO DIGGING!



**OJIBWAY CORRECTIONAL FACILITY
 WASTEWATER LAGOON DEMOLITION**
 MICHIGAN DEPARTMENT OF CORRECTIONS
 N5705 OJIBWAY ROAD MARENISCO, MICHIGAN

ISSUED FOR:	DATE:
50% REVIEW	05/20/19
90% REVIEW	06/11/19
100% REVIEW	06/14/19
BIDDING	06/14/19
AS-BUILT	06/08/20

DESIGNED BY:	CLH
DRAWN BY:	MEP
CHECKED:	CLH
APPROVED:	CLH

**AS-BUILT
 SITE PLAN**

C102





NOTE:
UTILITIES LOCAIONS ARE APPROXIMATE
FIELD VERIFY PRIOR TO DIGGING!



①



②



③



④



⑤



⑥

GRAPHIC SCALE
0 50 100 200
(IN FEET)
1 inch = 100 ft.



**OJIBWAY CORRECTIONAL FACILITY
WASTEWATER LAGOON DEMOLITION**
MICHIGAN DEPARTMENT OF CORRECTIONS
N5705 OJIBWAY ROAD MARENISCO, MICHIGAN

ISSUED FOR:	DATE:
50% REVIEW	05/20/19
90% REVIEW	06/11/19
100% REVIEW	06/14/19
BIDDING	06/14/19
AS-BUILT	06/08/20

PROJECT NO:	DESIGNED BY:	CHECKED:	APPROVED:
M12-19220	CLH	CLH	CLH
	MEP	CLH	CLH

**AS-BUILT
SITE PLAN**

C102

