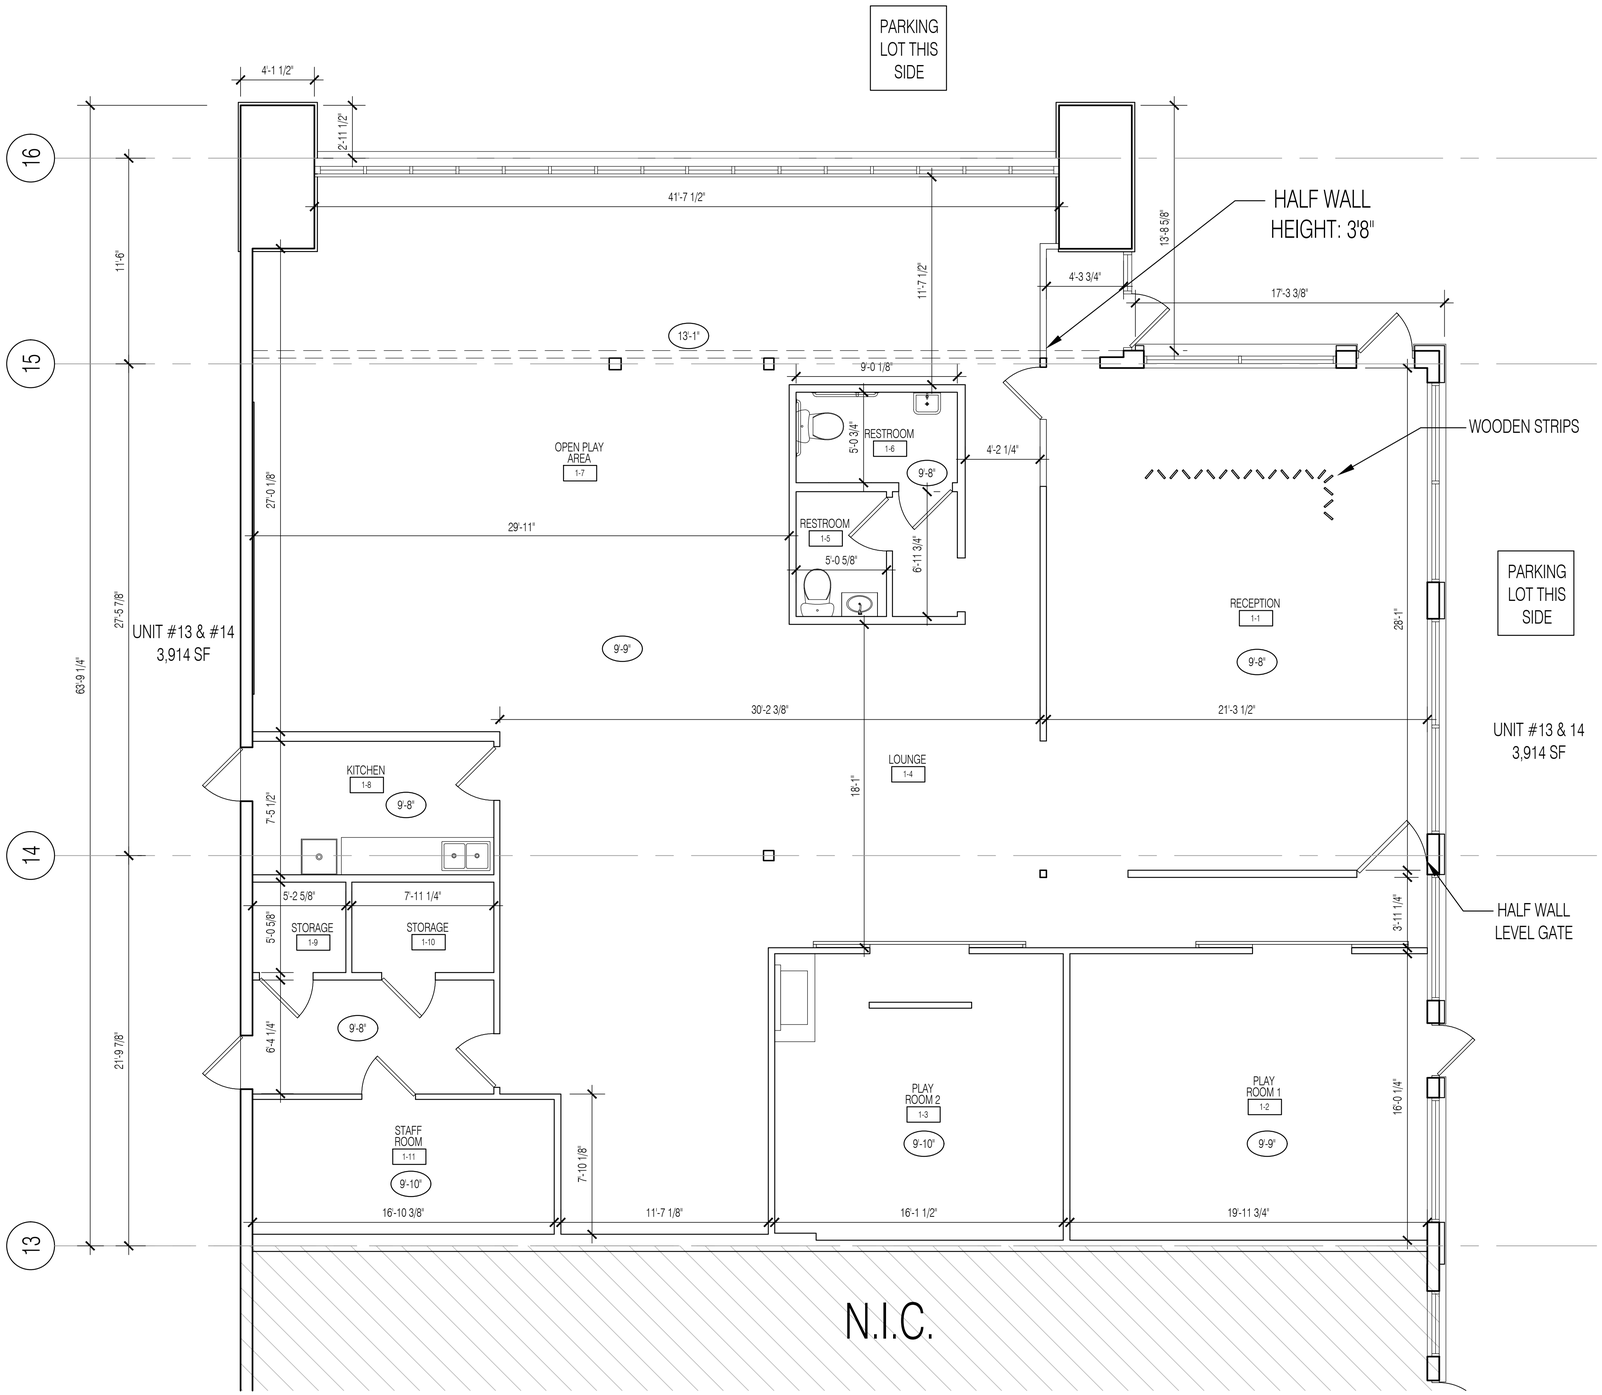

1 EXISTING FIRST FLOOR PLAN, LEASE OUTLINE DRAWING - UNITS 13 & 14

SCALE: 1/8" = 1'-0"

PROJECT

QuickChek Plaza
Lease Outline Drawing

PROJECT LOCATION

BLOCK: LOT:

881 Main St
Sayreville, NJ 08872
Middlesex County

ARCHITECT

BEN HORTEN architecture & design
312 State Route 10, Randolph, NJ 07869
Tel: 973.442.5880 Fax: 973.442.5886

ISSUES & REVISIONS

No.	Date	Issues and Revisions	By	Check
1.	07/30/24	SURVEY	VK	BH

REGISTRATION & SIGNATURE

Benjamin J. Horten NJ Licence No: 21AI 01579400

Drawing Description:

EXISTING FIRST FLOOR PLAN
LEASE OUTLINE DRAWING - UNITS 13 & 14

Computer File:

P:\24146 Sayreville Retail Asbuilt Survey Unit 13,14\drawings\0_survey\LOD UNIT 13 & 14.dwg

SHEET

LOD UNITS 13 & 14

All drawings and written material appearing herein constitute original and unpublished work of the architect and may not be duplicated, used or disclosed without written consent of the architect.
©2024 BEN HORTEN ARCHITECTURE & DESIGN All Rights Reserved