4/16/2024 6:23:46 PM

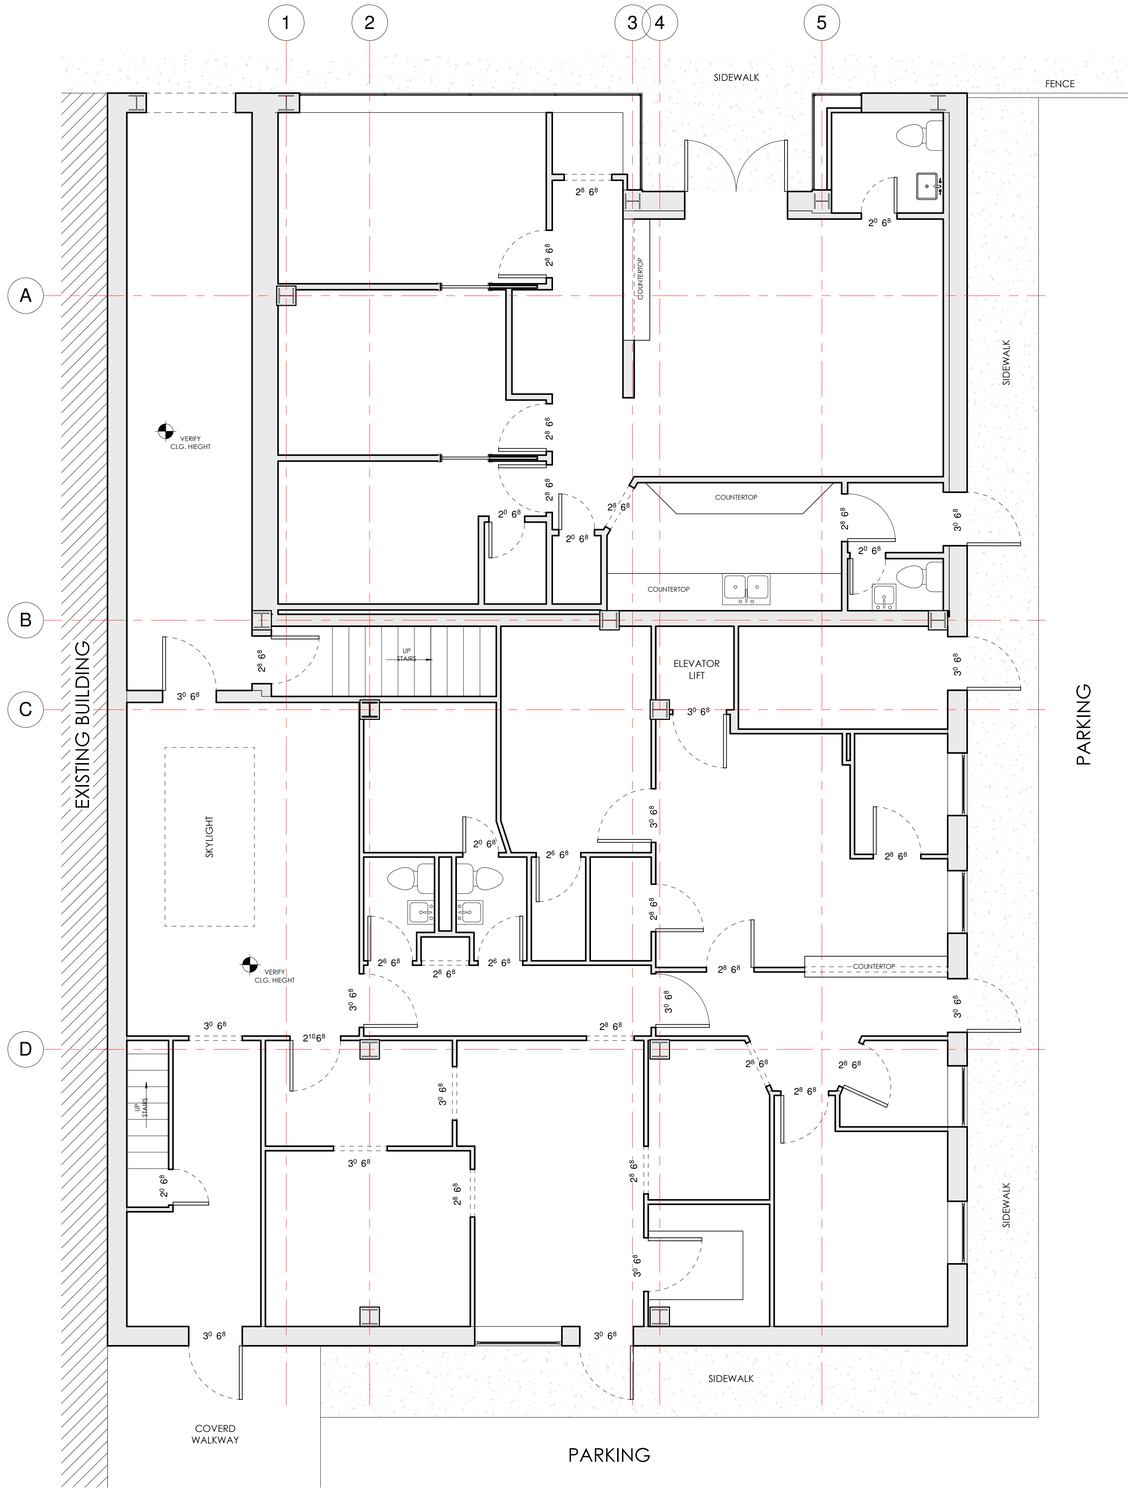


NOTE

CEILING HEIGHTS ARE 10' U.N.O.

## 01 FIRST FLOOR

**SCALE: 1/4" = 1'-0"**

N

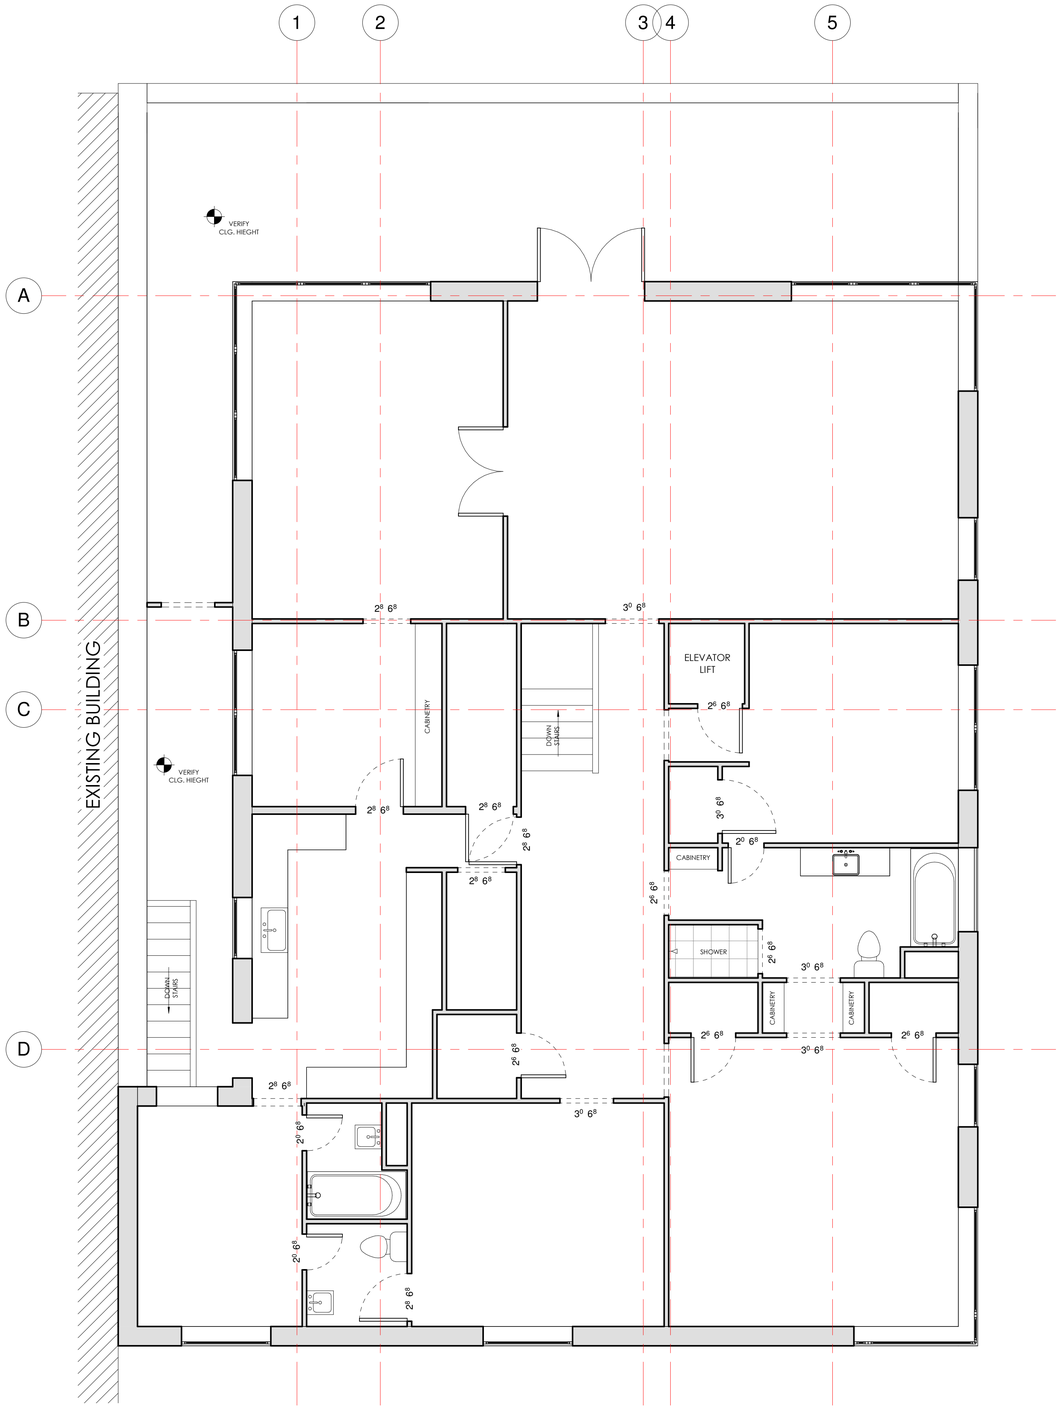


## 2 SECOND FLOOR

**SCALE: 1/4" = 1'-0"**


**Total Art Design & Architecture**
Brett Davidson, AIA
193-1/2 West San Antonio St.
New Braunfels, TX 78130
(210) 885-7954

Structural: **Calvetti & Associates, Inc.**
342 Wilkins Ave
San Antonio, TX 78210
(210) 828-6419

MEP: **KJ Engineering Inc.**
434 Breesport St.
San Antonio, TX 78216
(210) 490-1755

Landscape Architect:
**N/A**

Civil: **HMT Engineering & Surveying**
290 S. Castell Ave. Ste. 100
New Braunfels, TX 78130
(830)625-8555


**Project Name**

**Enter address here**

**REVISIONS**

| NO. | DATE |
|---|---|
| | |

PRELIMINARY
FOR INTERIM REVIEW ONLY
These documents are for Interim Review and not intended for Construction, Bidding, or Permit Purposes.

90% CHECK SET

OWNER:
Owner

**AS BUILT FLOOR PLANS**

**A101**

PROJECT NUMBER: Project Number
DATE 03/10/20

P:\2308 Wright Building\Design\Revit\Wright Building.rvt