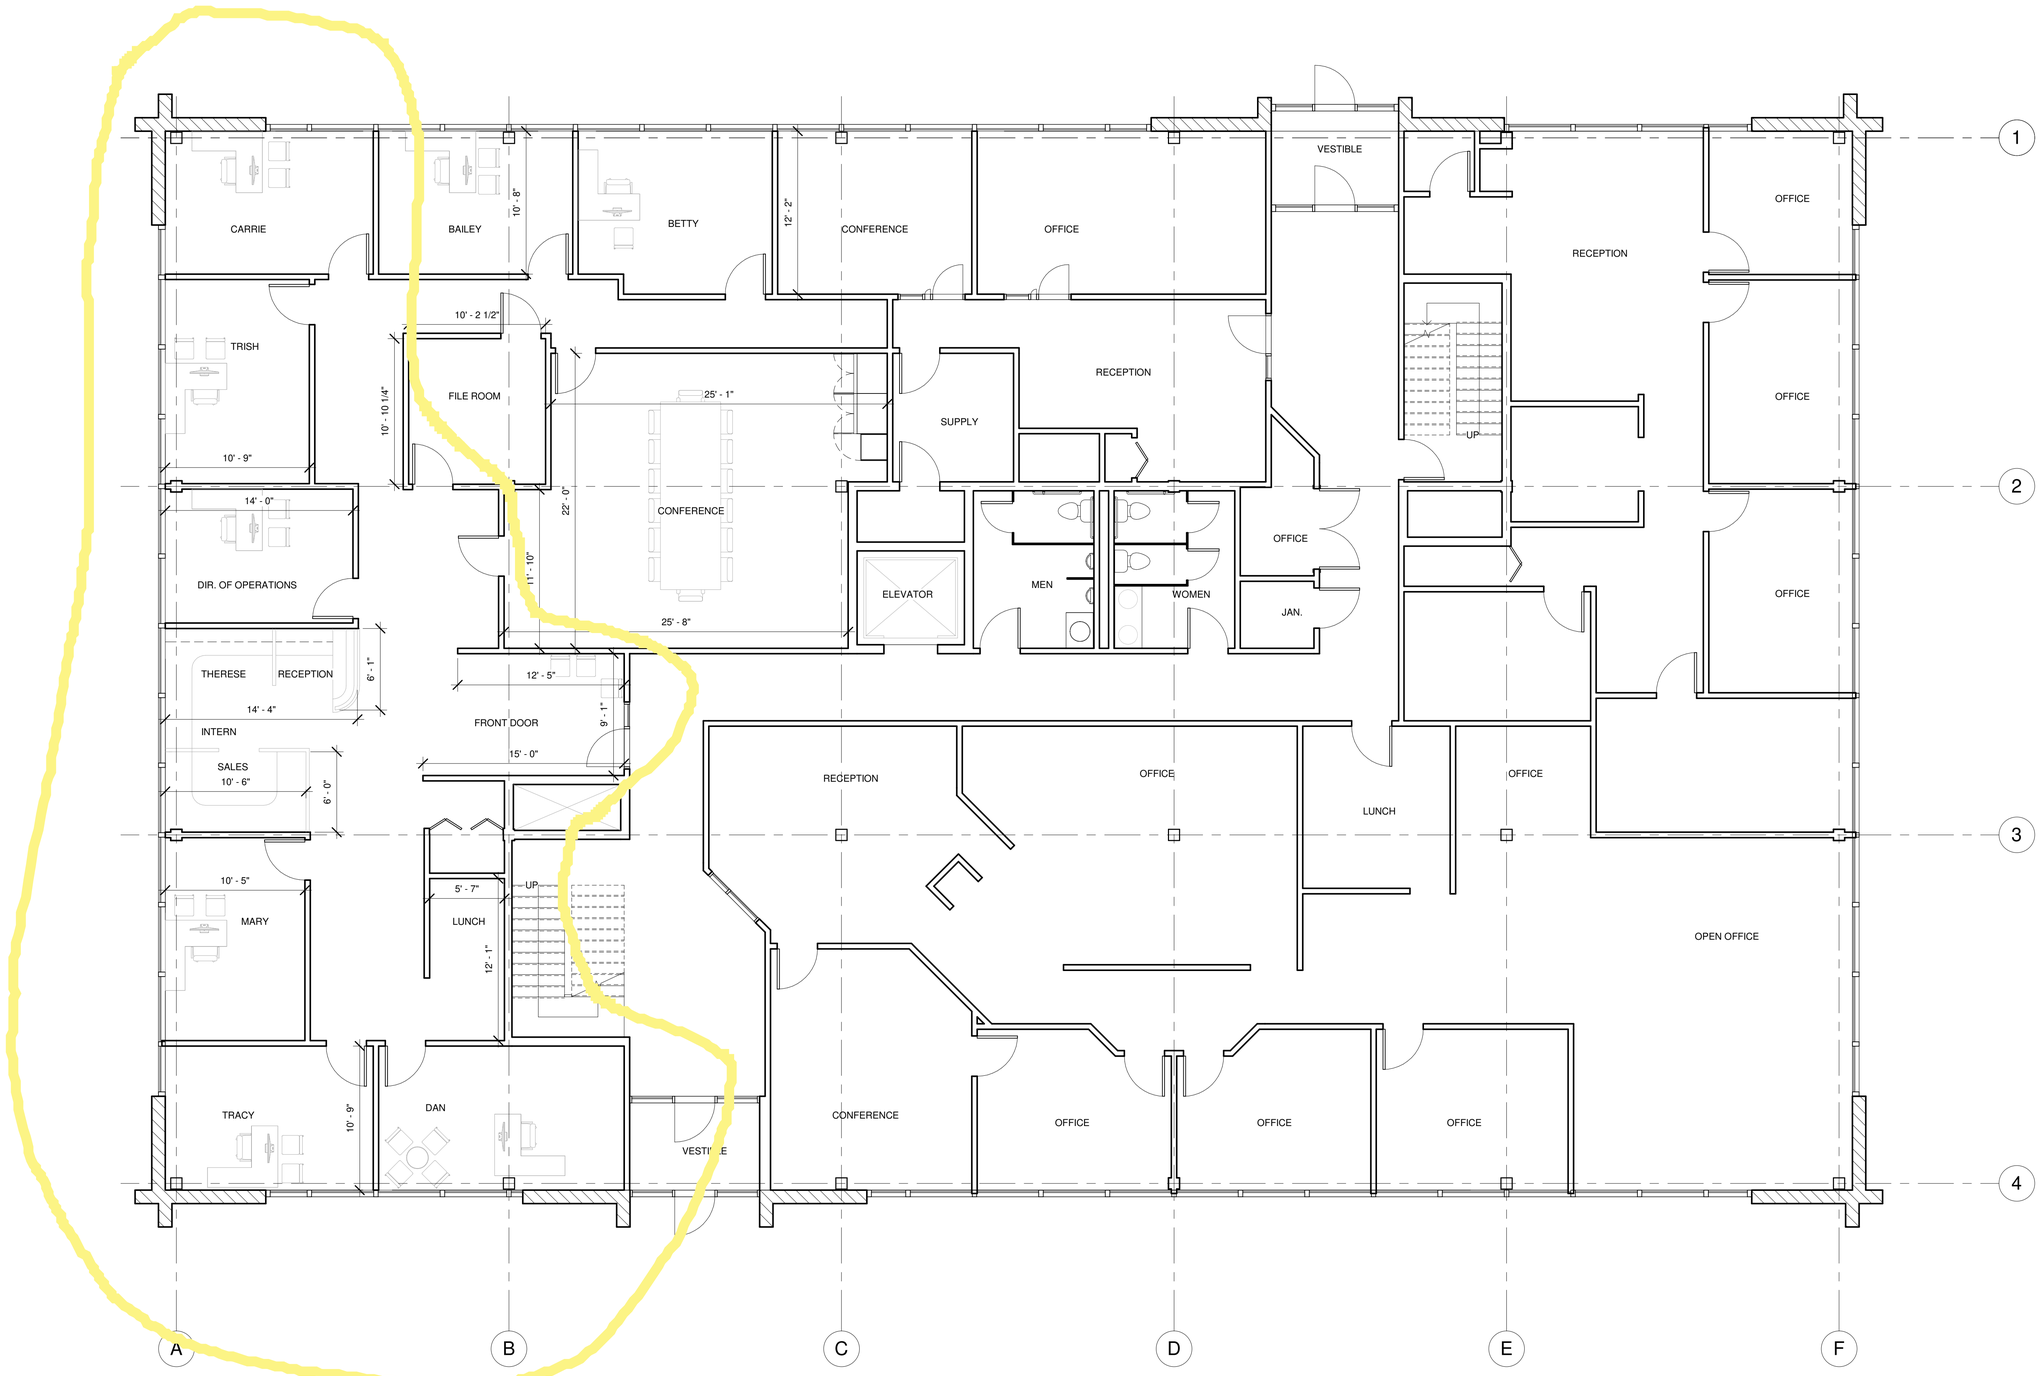

1 A - 001 EXISTING MAIN FLOOR
3/16" = 1'-0"

COPYRIGHT 2026

RAYS DESIGNS
MINNEAPOLIS, MN
tel: 612.470.2789
email: info@rays-designs.com
www.rays-designs.com

COPYRIGHT RAYS DESIGNS LLC
THESE PLANS ARE SUBJECT TO COPYRIGHT PROTECTION AS AN ARCHITECTURAL WORK UNDER SECTION 102 OF THE COPYRIGHT ACT, 17 U.S.C., AS AMENDED DECEMBER 1, 1990, AND KNOWN AS THE ARCHITECTURAL WORKS COPYRIGHT PROTECTION ACT OF 1990. THE PROTECTION INCLUDES, BUT IS NOT LIMITED TO, THE OVERALL FORM AS WELL AS THE ARRANGEMENT AND COMPOSITION OF SPACES AND ELEMENTS OF DESIGN. UNDER SUCH PROTECTION, UNAUTHORIZED USE OF THE PLANS AND THE FORMS REPRESENTED, CAN LEGALLY RESULT IN FINES OF SUCH CONSTRUCTION OR BUILDINGS BEING ERECTED OR RAZED.

TERMS

CONTRACTOR TO VERIFY ALL DIMENSIONS, AS BUILT CONDITIONS (IF APPLY) AND SITE CONDITIONS BEFORE ORDERING MATERIAL OR FINISHING EXISTING STRUCTURE. CONTRACTOR AND ALL SUBS MUST REPORT ANY DISCREPANCIES TO DESIGNER IMMEDIATELY, AS WELL AS UNIQUE CONDITIONS OF SITE. UNIQUE CONDITIONS THAT COULD NOT BE PREDICTED OR FORESEEN AT DESIGN COMPLETION. CONTRACTOR, SUBS AND DESIGNER WILL WORK TOGETHER TO REACH A SOLUTION FOR ANY SITUATION M/

STERLING

NOT FOR CONSTRUCTION

PROJECT NAME

1959 Sloan Pl, St Paul, MN 55117.

AS BUILT

Revision Schedule

No.	Description	Date

EXISTING MAIN FLOOR PLAN

Project number	38582
Date	04-08-2026
Drawn by	ST
Checked by	SS

A - 001

GENERAL DISCLAIMER: THESE DRAWINGS ARE PROVIDED FOR DESIGN INTENT AND REFERENCE ONLY. ALL DIMENSIONS AND FIELD CONDITIONS SHALL BE VERIFIED BY THE CONTRACTOR PRIOR TO CONSTRUCTION. THE DESIGNER/FIRM SHALL NOT BE RESPONSIBLE FOR CONSTRUCTION MEANS, METHODS, TECHNIQUES, SEQUENCES, PROCEDURES, OR SAFETY PRECAUTIONS. ANY DISCREPANCIES BETWEEN THE DRAWINGS AND EXISTING SITE CONDITIONS SHALL BE REPORTED TO THE DESIGNER/FIRM PRIOR TO COMMENCEMENT OF WORK. CONTRACTOR SHALL BE RESPONSIBLE FOR COORDINATING ALL TRADES, VERIFYING CODE COMPLIANCE, AND ENSURING PROPER INSTALLATION OF ALL MATERIALS AND SYSTEMS. COMPLIANCE WITH ALL APPLICABLE CODES, ORDINANCES, AND REGULATIONS IS THE RESPONSIBILITY OF THE CONTRACTOR.

4/8/2026 12:54:34 PM