This document, materials or presentation, whether offered online or presented in hard copy ("ADT Commercial Informational Tools") is for informational purposes only. ADT COMMERCIAL PROVIDES THESE ADT INFORMATIONAL TOOLS "AS IS" WITHOUT WARRANTY OF ANY KIND, EITHER EXPRESS OR IMPLIED, INCLUDING, BUT NOT LIMITED TO THE IMPLIED WARRANTIES OF MERCHANTABILITY OR FITNESS FOR A PARTICULAR PURPOSE. The ADT Commercial Informational Tools contain ADT Commercial proprietary and confidential materials. No part of the ADT Commercial Informational Tools may be modified, altered, reproduced, stored in or introduced into a retrieval system, or transmitted in any form or by any means (electronic, mechanical, photocopying, recording, or otherwise), without the prior written permission of ADT Commercial , except as otherwise permitted by law. Prior to publication, reasonable effort was made to validate this information. The ADT Commercial Information Tools may include technical inaccuracies or typographical errors. Actual savings or results achieved may be different from those outlined in the ADT Commercial Informational Tools. The recipient shall not alter or remove any part of this statement.

18/4 FIRE (SLC)
14/2 FIRE (H/S)
14/2 POWER (CO DET)

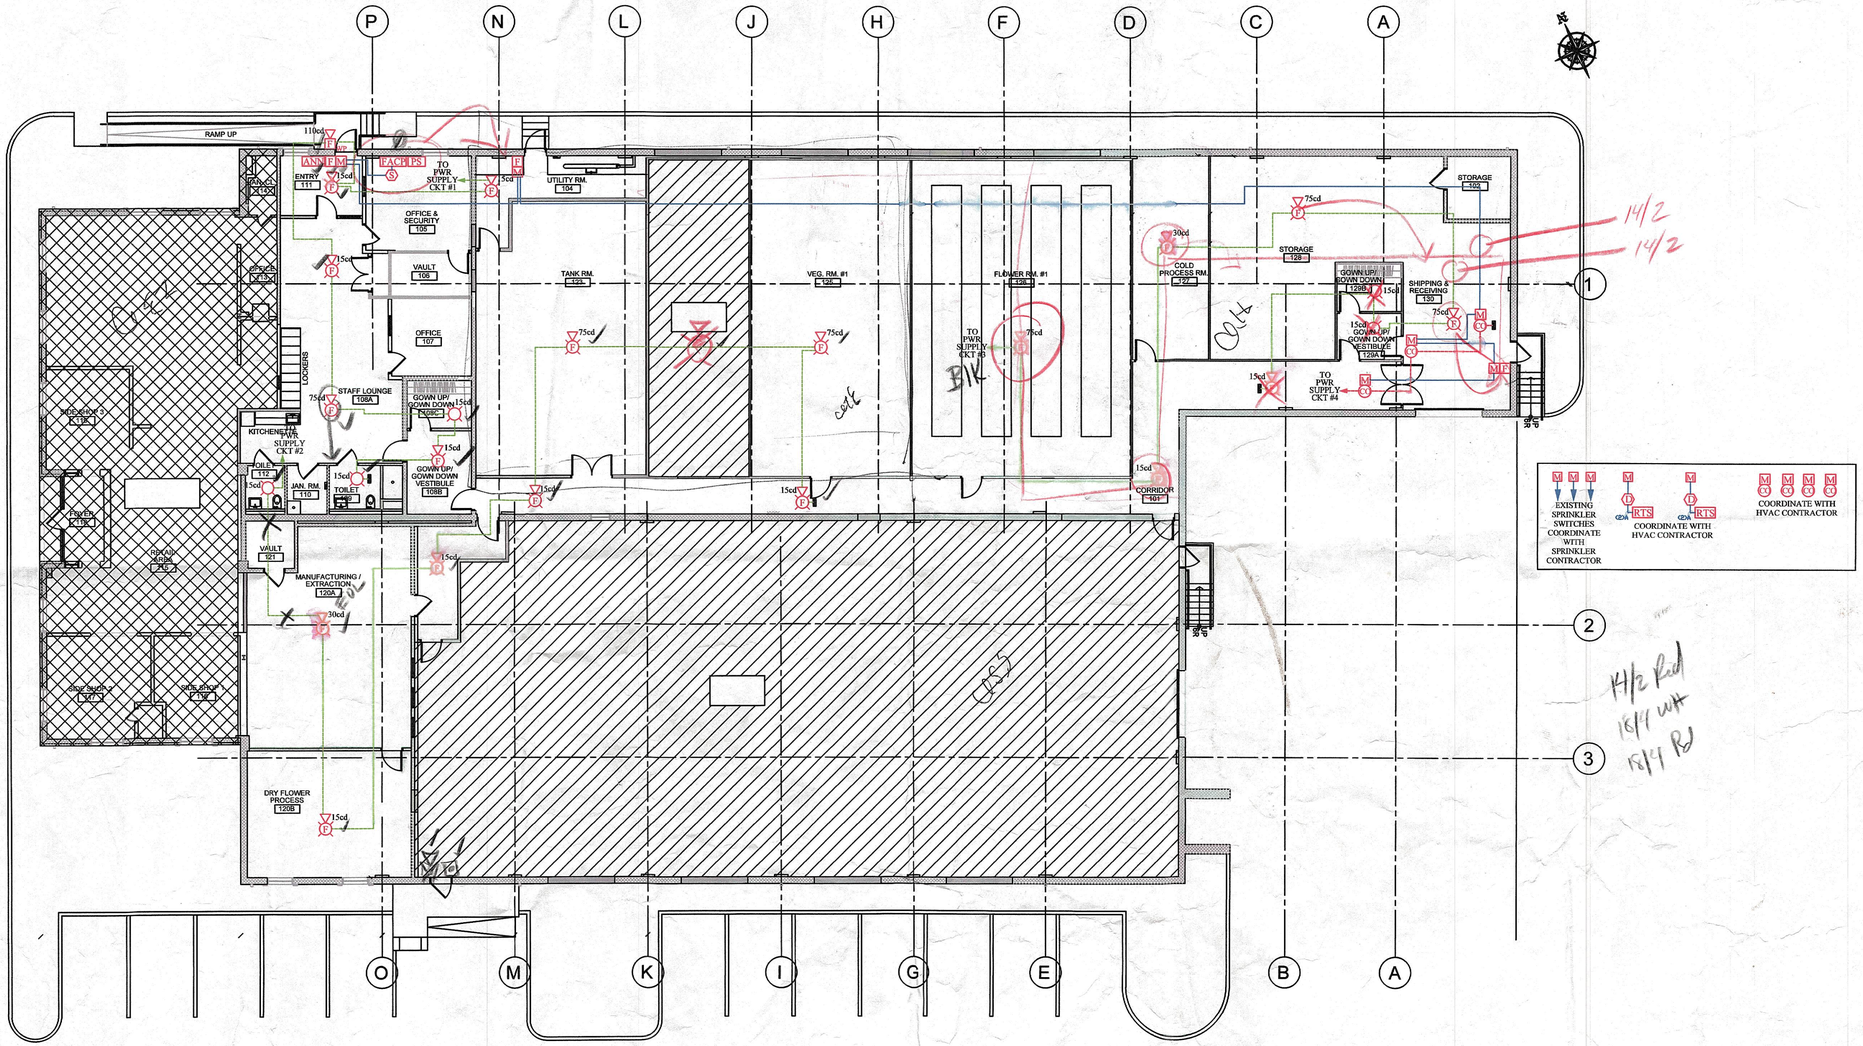

EXISTING SPRINKLER SWITCHES COORDINATE WITH SPRINKLER CONTRACTOR

COORDINATE WITH HVAC CONTRACTOR

COORDINATE WITH HVAC CONTRACTOR

FIRST FLOOR PLAN

SCALE: 3/32" = 1' - 0"

ADT Commercial

1345 CAMPUS PARKWAY
WALL TOWNSHIP, NEW JERSEY 07753
732-751-0600
adt.com/commercial

1776 BLOOMSBURY AVE
OCEAN. NJ 07712

BART FRALEY, ET
DESIGN MANAGER
NICET CERT. #134790 LEVEL III FIRE ALARM SYSTEMS

SCALE: AS NOTED

REV.	DATE	DESCRIPTION
△		
△		
△		

TITLE

FIRE ALARM SYSTEM FLOOR PLAN

PREPARED BY: LB	DATE: 5/1/2024
CHECKED BY: BF	PROJECT: 891745620
PROJECT MANAGER: AS	SHEET FA-6
SHEET: 6 OF 7	

© 2023 ADT Commercial. All rights reserved. The product/service names listed in this document are marks and/or registered marks of their respective owners and used under license. Unauthorized use strictly prohibited.