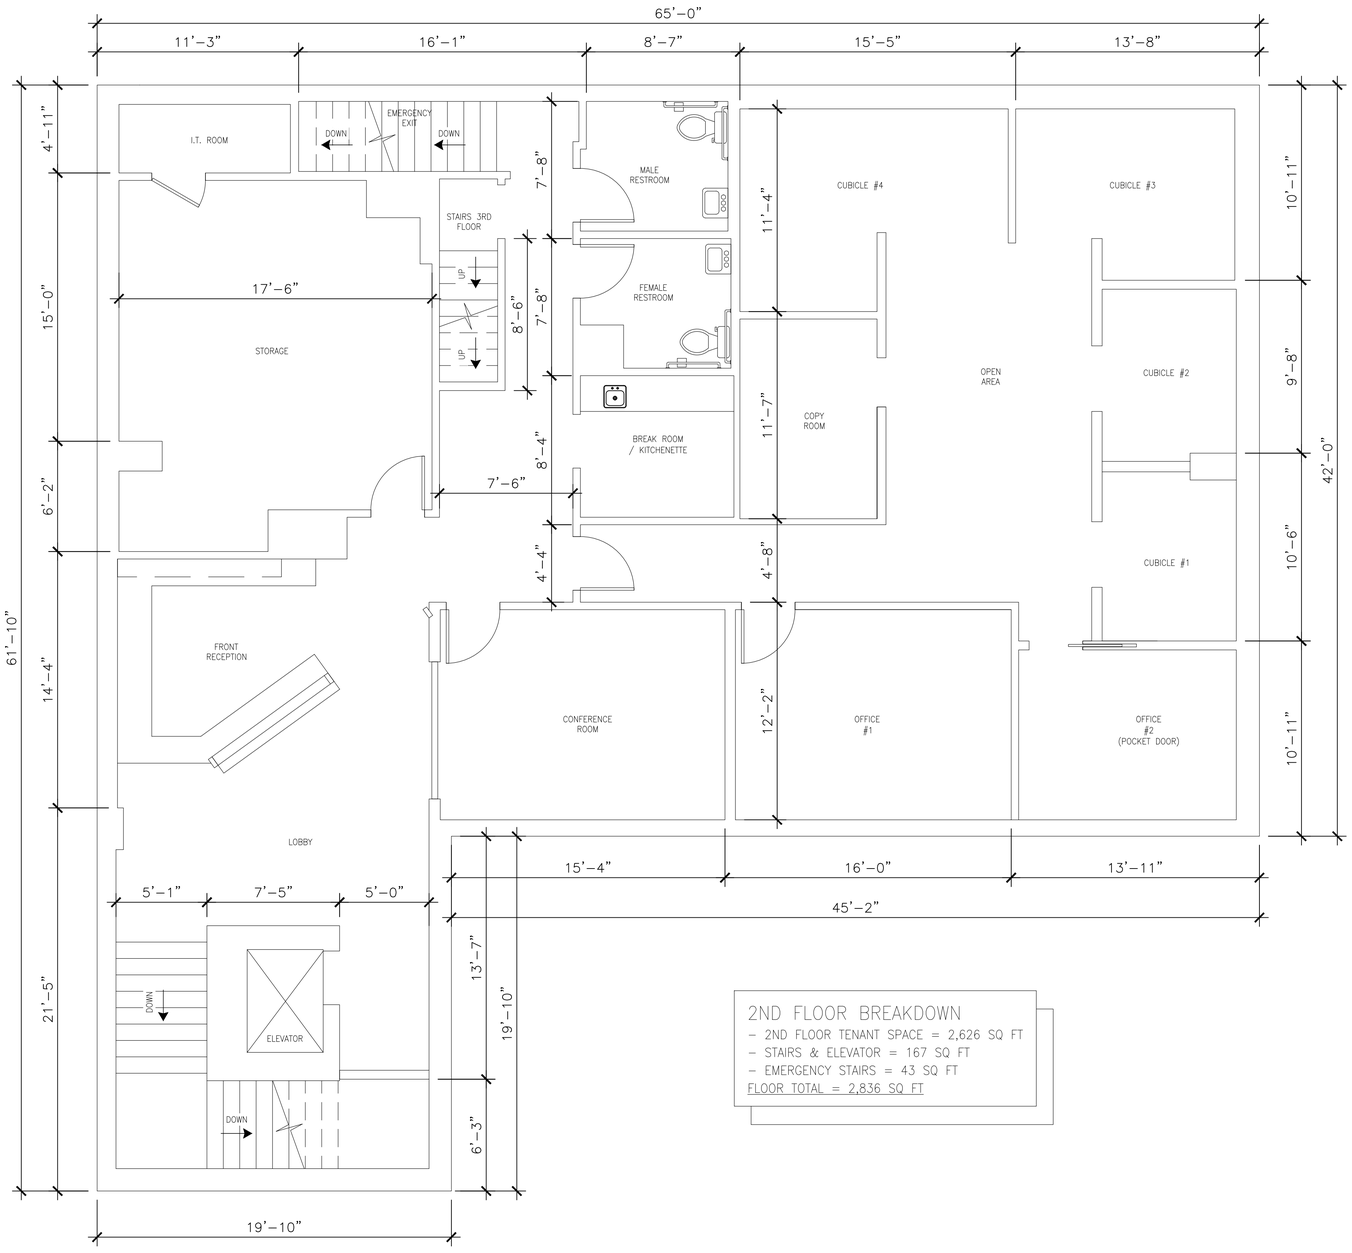

2ND FLOOR BREAKDOWN

- 2ND FLOOR TENANT SPACE = 2,626 SQ FT
- STAIRS & ELEVATOR = 167 SQ FT
- EMERGENCY STAIRS = 43 SQ FT

FLOOR TOTAL = 2,836 SQ FT

2ND FLOOR AS-BUILT | SCALE: 1/4" = 1'–0" | 1

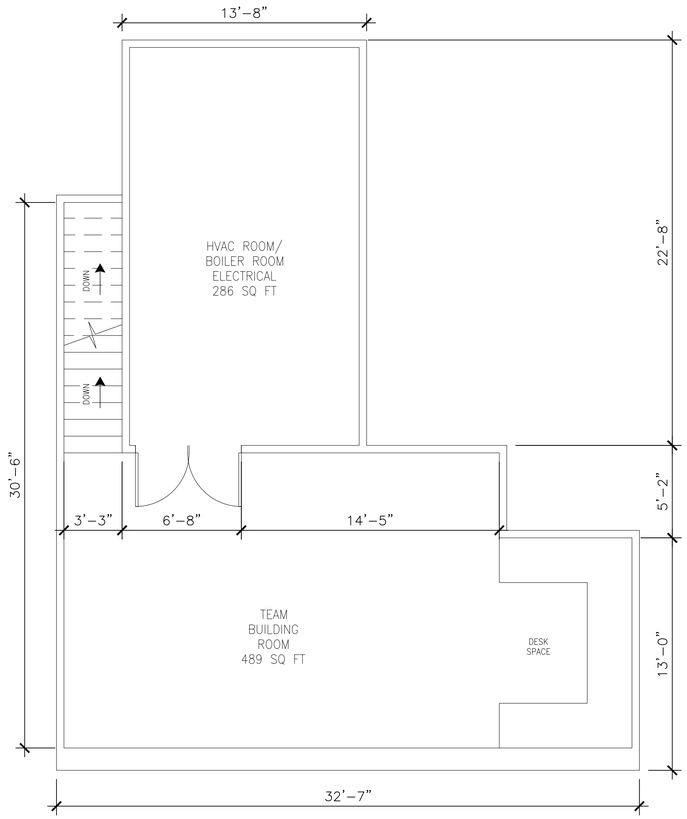

3RD FLOOR BREAKDOWN

- TEAM BUILDING ROOM = 489 SQ FT
- MECHANICAL ROOM = 286 SQ FT

FLOOR TOTAL = 775 SQ FT

3RD FLOOR AS-BUILT | SCALE: 1/4" =1'–0" | 2

AMC DESIGN

- PLANNING
- DESIGN
- CONSULTING

1549 Campbell Rd
Houston, TX 77055
PHONE: 832-274-4464
FAX: 281-598-5797
anthony_vu@comcast.net

ALL IDEAS, DESIGNS, ARRANGEMENTS AND PLANS INDICATED OR REPRESENTED BY THIS DRAWING ARE OWNED BY AMC AND ARE THE PROPERTY OF THE DESIGNER, AND WERE CREATED, EVOLVED AND DEVELOPED FOR USE IN CONNECTION WITH THE SPECIFIED PROJECT. NONE OF SUCH IDEAS, DESIGNS, ARRANGEMENTS OR PLANS SHALL BE USED BY OR DISCLOSED TO ANY PERSON, FIRM, OR CORPORATION FOR ANY PURPOSE WHATSOEVER WITHOUT THE PRIOR PERMISSION OF THE DESIGNER. WRITTEN DIMENSIONS ON THESE DRAWINGS SHALL HAVE PRECEDENCE OVER SCALED DIMENSIONS. CONTRACTORS SHALL VERIFY AND BE RESPONSIBLE FOR ALL DIMENSIONS AND CONDITIONS ON THE JOB AND THE DESIGNER MUST BE NOTIFIED OF ANY VARIATIONS FROM THE DIMENSIONS OR CONDITIONS SHOWN ON THESE DRAWINGS.

5712 VAL VERDE OFFICE AS-BUILT

5712 VAL VERDE STREET
HOUSTON, TEXAS 77057

DRAWING ISSUED FOR:

REVISONS		
	DATE:	DESCRIPTION:

DATE: 11/09/21
DRAWN BY: M.M.
CHECKED BY: A.V.
PROJECT: A.V.
FILE NO:

SHEET TITLE: FLOOR PLAN

SHEET NO: A-2.0