30X

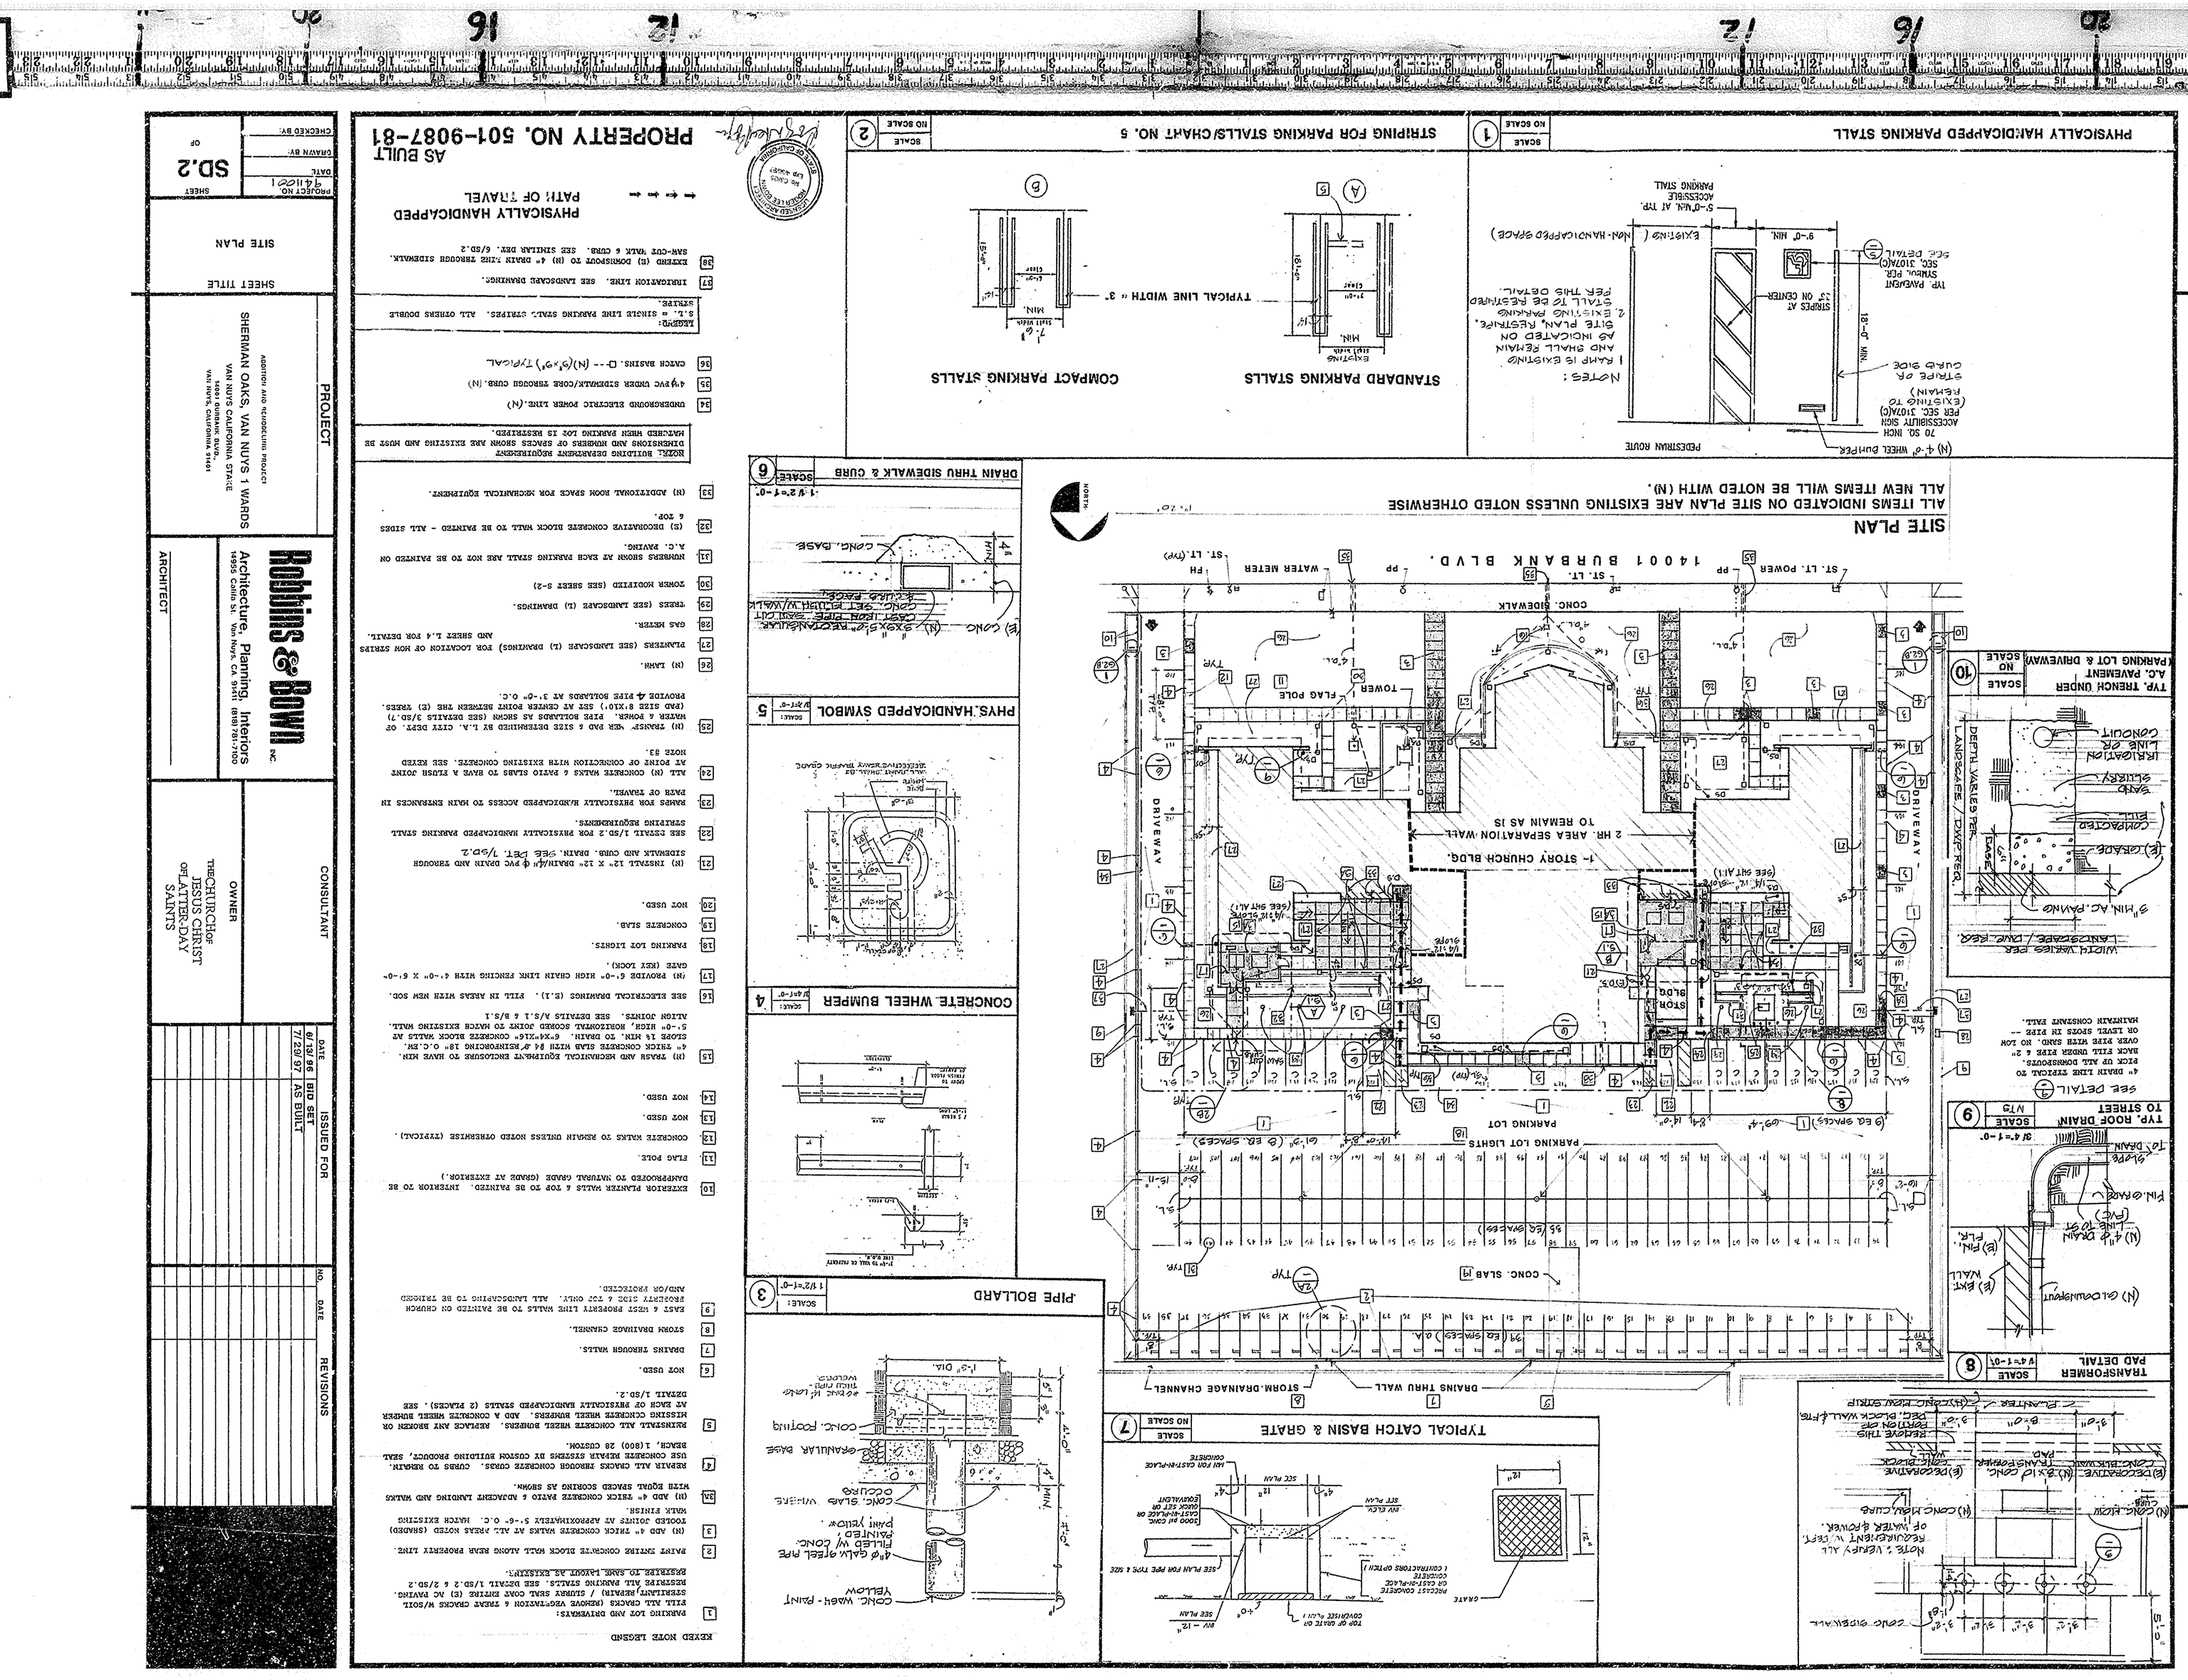
SITE PLAN
ALL ITEMS INDICATED ON SITE PLAN ARE EXISTING UNLESS NOTED OTHERWISE
ALL NEW ITEMS WILL BE NOTED WITH (N).
14001 BURBANK BLVD.
1-STORY CHURCH BLDG.
2 HR. AREA SEPARATION WALL TO REMAIN AS IS
STORAGE BLDG
PARKING LOT
DRIVEWAY
CONC. SIDEWALK
DRAINS THRU WALL
STORM DRAINAGE CHANNEL
PHYSICALLY HANDICAPPED PARKING STALL
STANDARD PARKING STALLS
COMPACT PARKING STALLS
STRIPING FOR PARKING STALLS/CHART NO. 5
PHYS. HANDICAPPED SYMBOL
DRAIN THRU SIDEWALK & CURB
CONCRETE WHEEL BUMPER
PIPE BOLLARD
TYPICAL CATCH BASIN & GRATE
TRANSFORMER PAD DETAIL
TYP. ROOF DRAIN TO STREET
TYP. TRENCH UNDER A.C. PAVEMENT (PARKING LOT & DRIVEWAY)
PROPERTY NO. 501-9087-81
AS BUILT
PHYSICALLY HANDICAPPED PATH OF TRAVEL
SHERMAN OAKS, VAN NUYS 1 WARDS
VAN NUYS CALIFORNIA STATE
THE CHURCH OF JESUS CHRIST OF LATTER-DAY SAINTS
Robbins & Bown Inc
Architecture, Planning, Interiors
SD.2