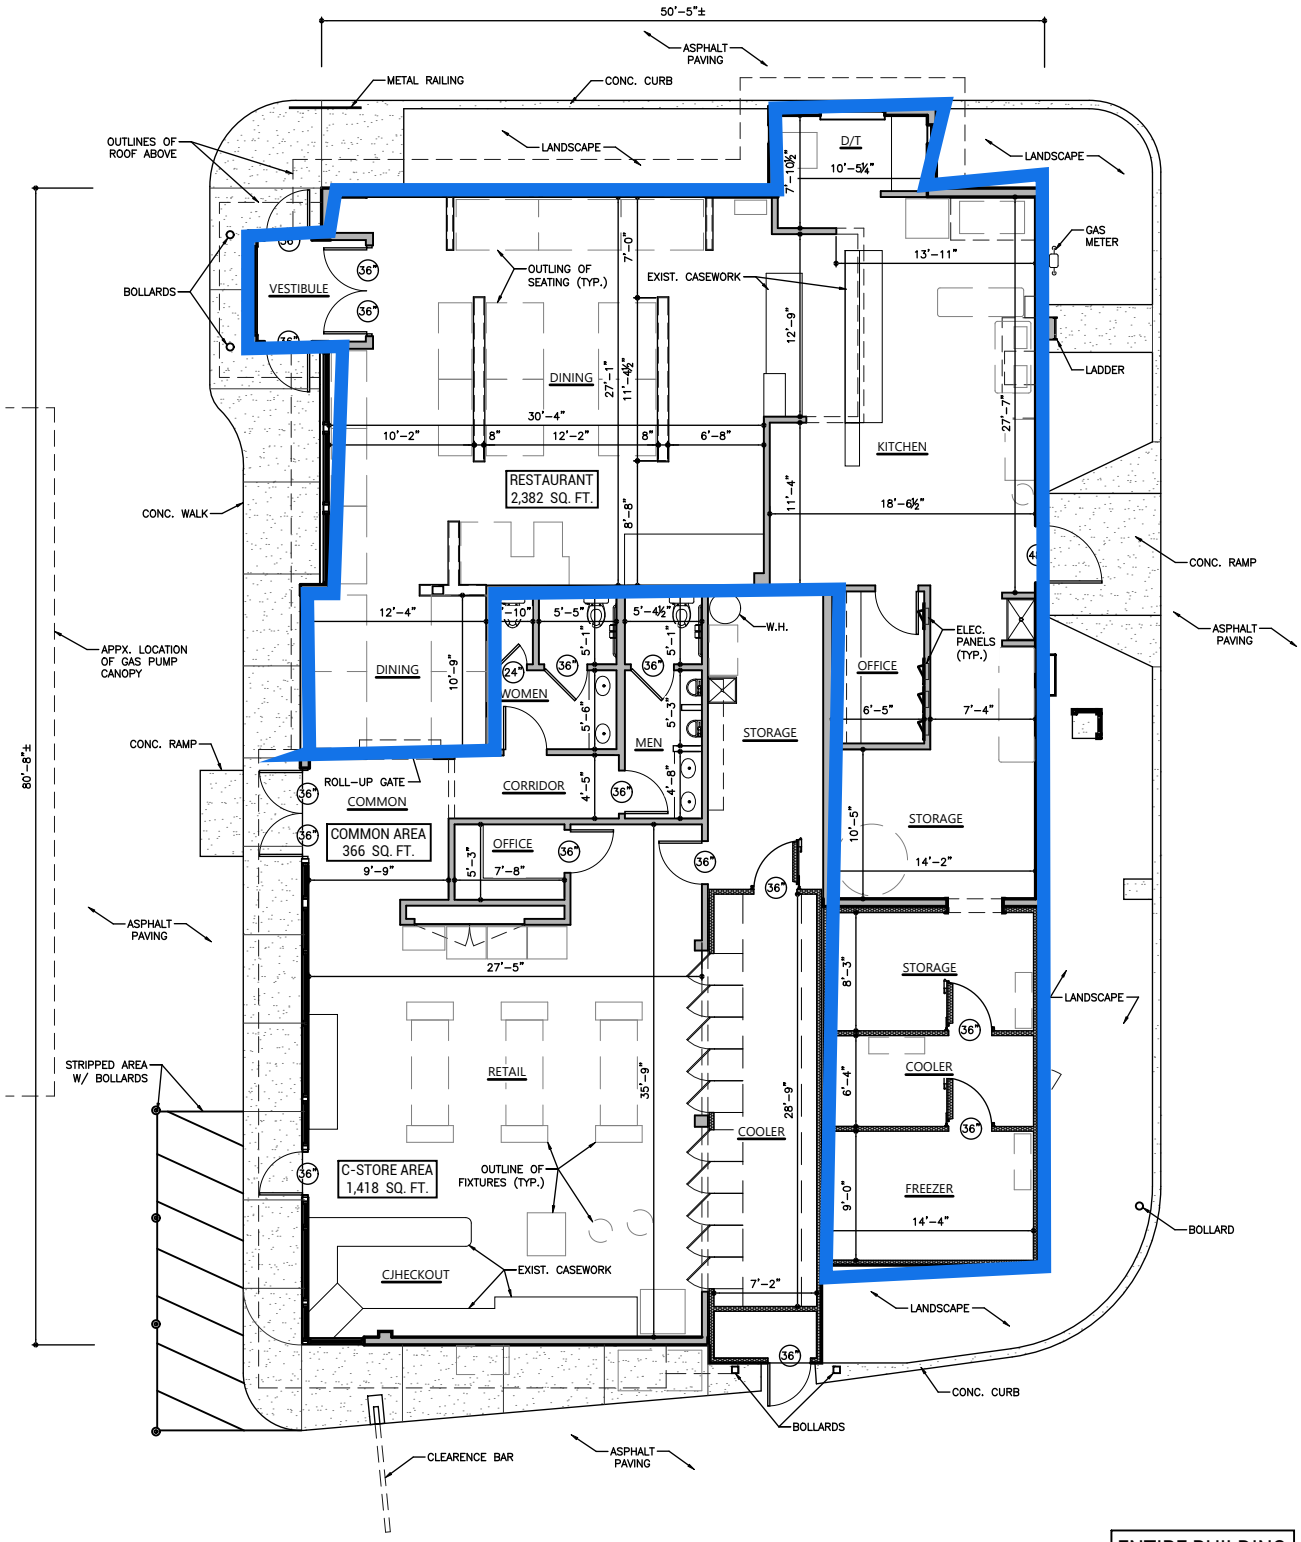

ENTIRE BUILDING
4,166 SQ. FT.

A

AS-BUILT FLOOR PLAN

SCALE: N.T.S.

DRAWN BY:
CAD Group
208 Percheron Drive
Richmond, KY 40475
phone: 859.582.2029
email: info@cadgroup.biz

OWNER:
Equity Management Group, Inc.
840 EAST HIGH STREET . LEXINGTON, KY 40502 . 859.266.1414

PROJECT:
AS-BUILT FLOOR PLAN
C-STORE & RESTAURANT
1690 FLEMINGSBURG ROAD
MOREHEAD, KY 40351

C-STORE & RESTAURANT

THESE ARE AS-BUILT DRAWINGS DRAWN AT THE REQUEST OF THE PROPERTY OWNER OR HIS REPRESENTATIVE. THESE DRAWINGS WERE PREPARED FROM SITE SKETCHES, MEASUREMENTS, PHOTOS, ETC. THE BEST OF MY KNOWLEDGE THESE PLANS ARE DRAWN TO COMPLY WITH OWNER'S REQUEST AND ARE DRAWN VERY ACCURATELY. THERE ARE CERTAIN ELEMENTS WHEN DRAWING AS-BUILTS THAT AREN'T FULLY VISIBLE. SUCH AS SOFFITS, CEILING SUSPENSION WIRES, ETC. THE PROPERTY OWNER OR THEIR REPRESENTATIVE SHOULD VERIFY ALL DIMENSIONS AND INFORMATION ON THE ENCLOSED DRAWING(S). CAD GROUP IS NOT LIABLE FOR ERRORS OR OMISSIONS. WHILE EVERY EFFORT HAS BEEN MADE IN THE PREPARATION OF THESE PLANS TO AVOID MISTAKES, DESIGNER CANNOT GUARANTEE AGAINST HUMAN ERROR. IF ADDITIONAL INFORMATION OR VERIFICATION OF ANY ITEM IS NEEDED ON THE DRAWINGS PLEASE NOTIFY CAD GROUP.

REVISIONS/RELEASES:

INFO:	
DRAWN BY:	CS
CHKD. BY:	EM
DATE:	24 MAR 2025
SCALE:	AS NOTED

SHEET AB1.1

CG PROJECT: 23605

SHEET SIZE: 8.5X11