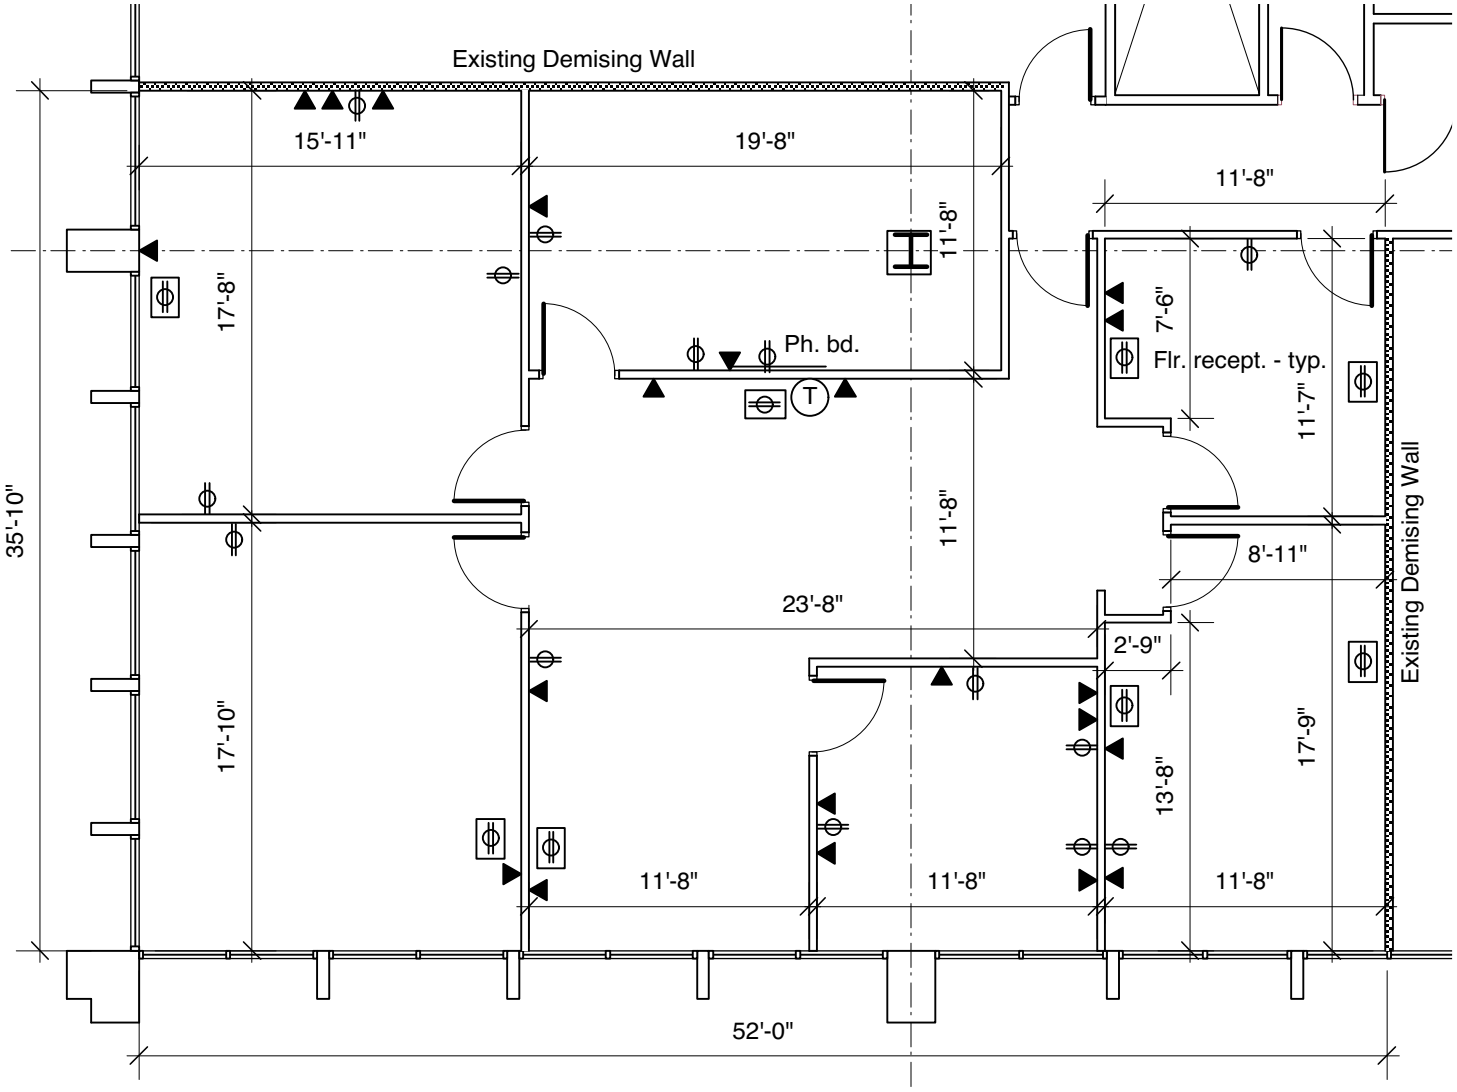

3/0x7/0 WC HC paint grade doors.

2,001 rentable sq. ft.

As Built Floor Plan
31 Oct 18 not to scale

Suite 310

LOD 310

409 Washington Avenue
Third Floor
Suite 310
Towson, Maryland

James Lloyd ARCHITECTS PA
12935 Byefield Drive, Highland, Maryland 20777 • 410 531 1177

0 5 10 20 40