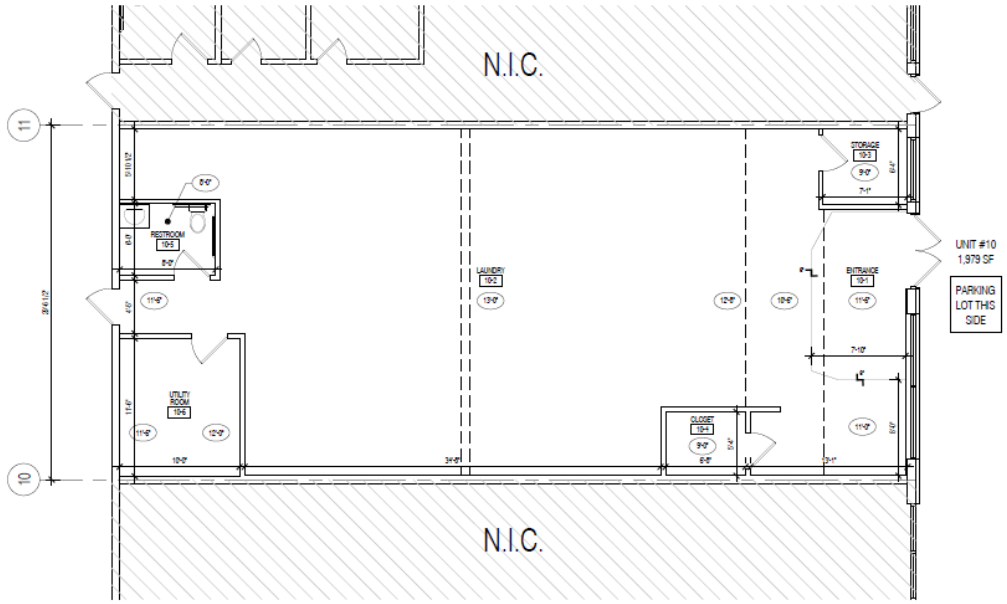

1 EXISTING FIRST FLOOR PLAN, LEASE OUTLINE DRAWING - UNIT 10

SCALE: 1/4" = 1'-0"

PROJECT

QuickChek Plaza
Lease Outline Drawing

LOCATION

881 Main Street
Sayreville, NJ 08872

CLIENT

881 Main St LLC
1610 Richmond Road
Staten Island, NY 10304

ARCHITECT

HORTEN
architecture & design
312 State Route 10, Randolph, NJ 07869
Tel: 973.442.5880 Fax: 973.442.5886

Issues and Revisions

No.	Date	Issues and Revisions	By	Check
1.	05/30/24	SURVEY	ZH	BH

Registration and Signature

Benjamin J. Horten NJ License No: AI 15794

Drawing Description:

EXISTING FIRST FLOOR PLAN
LEASE OUTLINE DRAWING - UNIT 10

Computer File:

C:\1 Jobs\P24135 Sayreville Retail Asbuilt Survey Unit 6, 10, 11\drawings\B_survey\LOD UNIT 6,10,11.dwg

LOD UNIT 10

All drawings and written material appearing herein constitute original and unpublished work of the architect and may not be duplicated, used or disclosed without written consent of the architect.
© 2024 HORTEN ARCHITECTURE All Rights Reserved