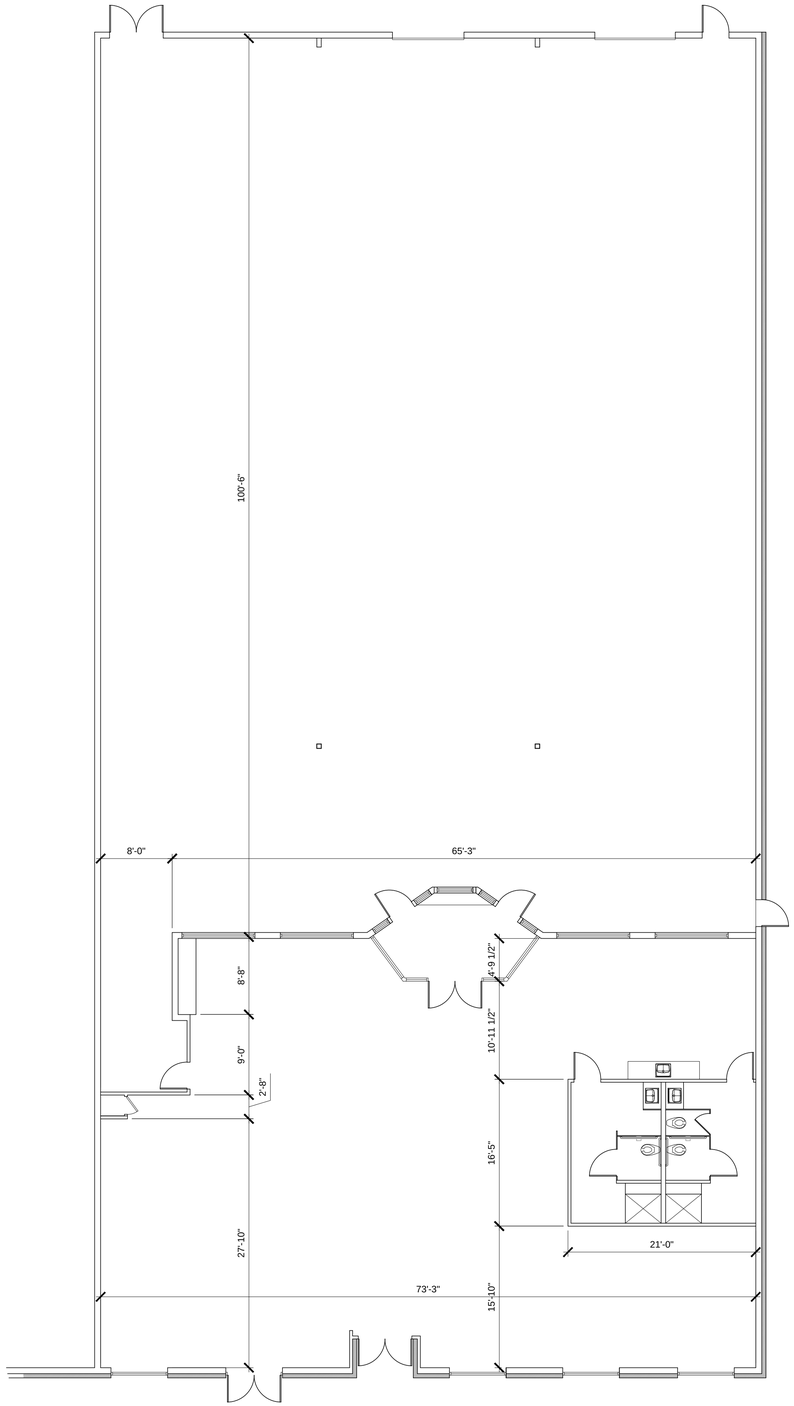

AS-BUILT FLOOR PLAN

1/8" = 1'-0"

NOTE: THIS DRAWING IS CREATED BY AND INTENDED ONLY FOR THE EXCLUSIVE USE OF INSPIRE DESIGN+BUILD, LLC. ANY UNAUTHORIZED USE OR DISTRIBUTION OF THIS OR OTHER DRAWINGS BY INSPIRE DESIGN_BUILD, LLC IS STRICKLY PROHIBITED

Todd Colvin
phone: 903.830.8510
tcolvin00@gmail.com

2931 Elkton Trail
Tyler, Tx. 75703

inspire
DESIGN + BUILD

RETAIL SPACE
COMMERCE PLAZA
TYLER, TEXAS

REVISIONS & SUBMISSIONS

NO.	DESCRIPTION	DATE

SHEET INFORMATION

DATE: 09-2018

SHEET NUMBER

A1.0