

FOR SALE

LEASE BACK MEDICAL OFFICE BUILDING

1623 RIVERY BLVD, GEORGETOWN TEXAS 78628

LOCATION

1623 Rivery Blvd, Georgetown, TX 78628
NWQ of Rivery Blvd & Williams Dr

ASKING PRICE \$1,485,000


NOI \$94,543


CAP RATE 6.4%


HIGHLIGHTS

- Free standing 3,071 sq ft building on Rivery Blvd
- Fantastic location with the Rivery Development and Williams Drive
- Sale Lease Back:
 - Tenant: Republic Spine and Pain
 - RSP started business in 2010
 - Lease originated: 1/1/22
 - Lease expiration: 1/31/36
 - Base rent starting 1/1/26: \$7878.56 plus NNN
 - 3% annual increases in base rent
- Landlord responsible for roof, structure and parking lot



	POPULATION 1 mile	8,299
	3 mile	48,914
	5 mile	91,977

	HOUSEHOLDS 1 mile	3,965
	3 mile	19,725
	5 mile	36,901

	AVG HH INCOME 1 mile	\$123,071
	3 mile	\$125,727
	5 mile	\$137,142



TRAFFIC COUNTS

Williams Dr: 28,155 VPD (TXDOT 2024)
Interstate 35: 136,143 VPD (TXDOT 2024)

CONTACT INFORMATION: PHONE: 512-750-5587 | EMAIL: novyco@austin.rr.com | ADDRESS: P.O. BOX 28054 AUSTIN, TX 78755



THE
NOVY COMPANY
PROFESSIONAL REAL ESTATE SERVICES

All information furnished regarding this property is from sources deemed reliable; however The Novy Company nor its affiliates has not made an independent investigation of these sources and no warranty or representation has been made to the accuracy; therefore this property marketing package is submitted subject to errors, omissions, change of price, rental, sale, lease, withdrawal from market, or other conditions without notice. The Novy Company nor its affiliates have made, and shall not make any warranty or representations as to the condition of the real estate property nor the presence of any hazardous substances or any environmental or other conditions that may affect the value or suitability of the real estate property. All other marks displayed on this document are the property of their respective owners. The Novy Company, All rights reserved <https://thenovycompany.com>.

PROPERTY PHOTOS

LEASE BACK MEDICAL OFFICE BUILDING

1623 RIVERY BLVD, GEORGETOWN TEXAS 78628



CONTACT INFORMATION: PHONE: 512-750-5587 | EMAIL: novyco@austin.rr.com | ADDRESS: P.O. BOX 28054 AUSTIN, TX 78755





THE NOVY COMPANY
PROFESSIONAL REAL ESTATE SERVICES

All information furnished regarding this property is from sources deemed reliable; however The Novy Company nor its affiliates has not made an independent investigation of these sources and no warranty or representation has been made to the accuracy; therefore this property marketing package is submitted subject to errors, omissions, change of price, rental, sale, lease, withdrawal from market, or other conditions without notice. The Novy Company nor its affiliates have made, and shall not make any warranty or representations as to the condition of the real estate property nor the presence of any hazardous substances or any environmental or other conditions that may affect the value or suitability of the real estate property. All other marks displayed on this document are the property of their respective owners. The Novy Company, All rights reserved <https://thenovycompany.com>.

PROPERTY PHOTOS

LEASE BACK MEDICAL OFFICE BUILDING

1623 RIVERY BLVD, GEORGETOWN TEXAS 78628

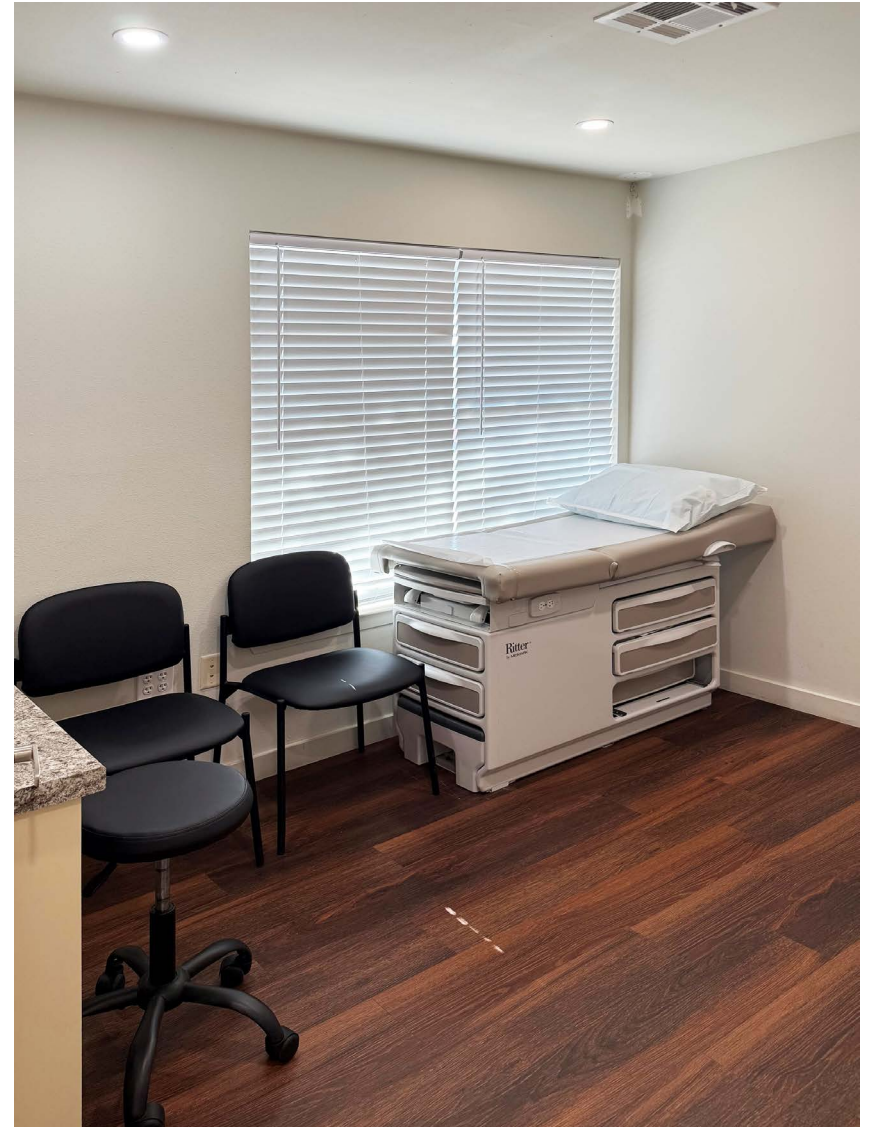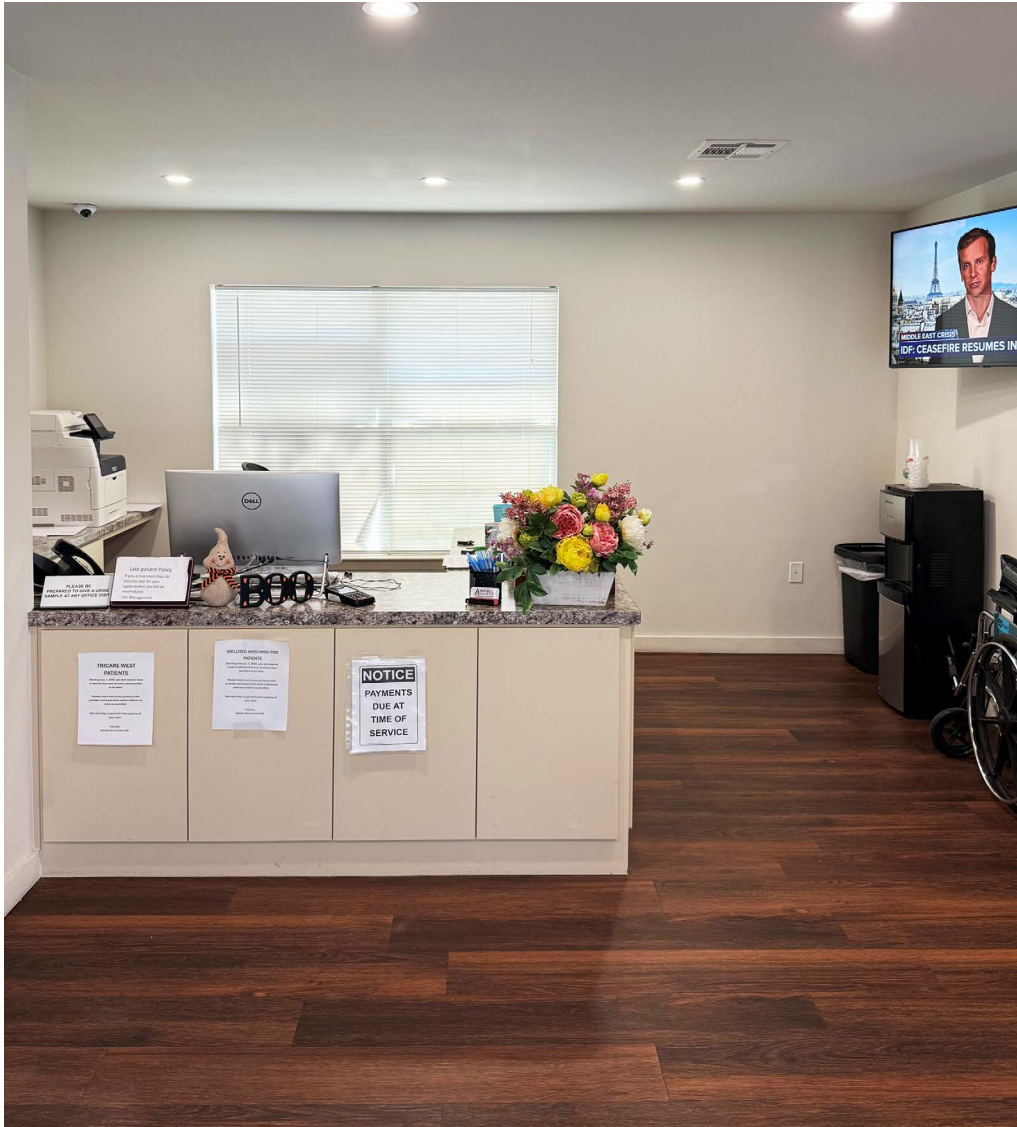

CONTACT INFORMATION: PHONE: 512-750-5587 | EMAIL: novyco@austin.rr.com | ADDRESS: P.O. BOX 28054 AUSTIN, TX 78755




**THE
NOVY COMPANY**
PROFESSIONAL REAL ESTATE SERVICES

All information furnished regarding this property is from sources deemed reliable; however The Novy Company nor its affiliates has not made an independent investigation of these sources and no warranty or representation has been made to the accuracy; therefore this property marketing package is submitted subject to errors, omissions, change of price, rental, sale, lease, withdrawal from market, or other conditions without notice. The Novy Company nor its affiliates have made, and shall not make any warranty or representations as to the condition of the real estate property nor the presence of any hazardous substances or any environmental or other conditions that may affect the value or suitability of the real estate property. All other marks displayed on this document are the property of their respective owners. The Novy Company, All rights reserved <https://thenovycompany.com>.

FLOOR PLAN

LEASE BACK MEDICAL OFFICE BUILDING

1623 RIVERY BLVD, GEORGETOWN TEXAS 78628

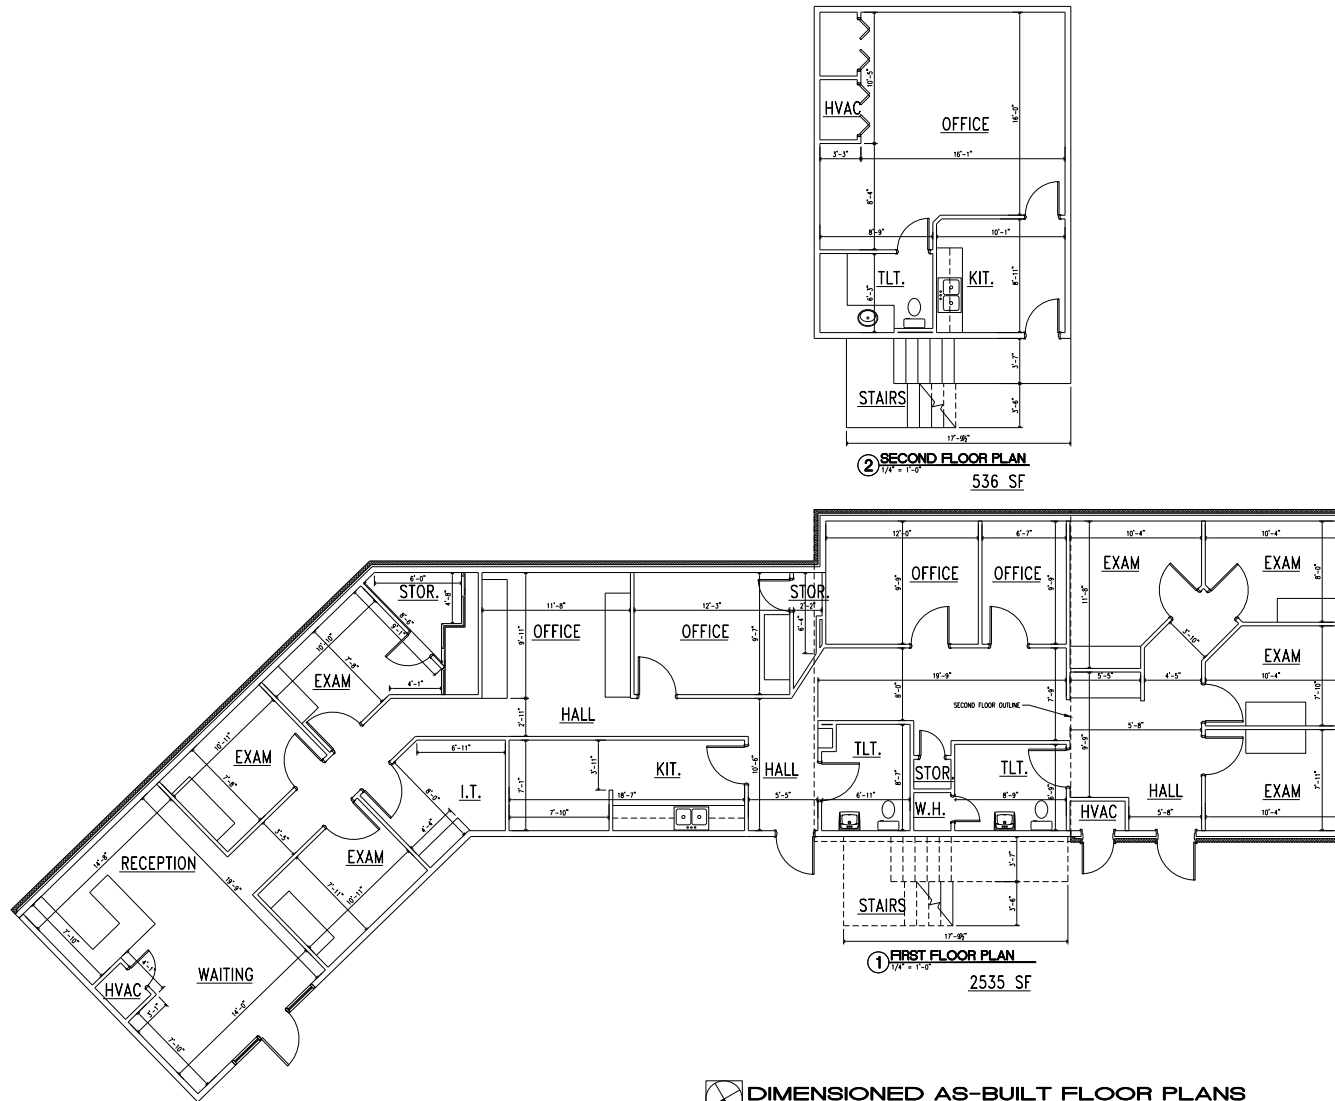

DIMENSIONED AS-BUILT FLOOR PLANS
SCALE: 1/4" = 1'-0"

CONTACT INFORMATION: PHONE: 512-750-5587 | EMAIL: novyco@austin.rr.com | ADDRESS: P.O. BOX 28054 AUSTIN, TX 78755




**THE
NOVY COMPANY**
PROFESSIONAL REAL ESTATE SERVICES

All information furnished regarding this property is from sources deemed reliable; however The Novy Company nor its affiliates has not made an independent investigation of these sources and no warranty or representation has been made to the accuracy; therefore this property marketing package is submitted subject to errors, omissions, change of price, rental, sale, lease, withdrawal from market, or other conditions without notice. The Novy Company nor its affiliates have made, and shall not make any warranty or representations as to the condition of the real estate property nor the presence of any hazardous substances or any environmental or other conditions that may affect the value or suitability of the real estate property. All other marks displayed on this document are the property of their respective owners. The Novy Company, All rights reserved <https://thenovycompany.com>.


FLOOR PLAN

LEASE BACK MEDICAL OFFICE BUILDING

1623 RIVERY BLVD, GEORGETOWN TEXAS 78628

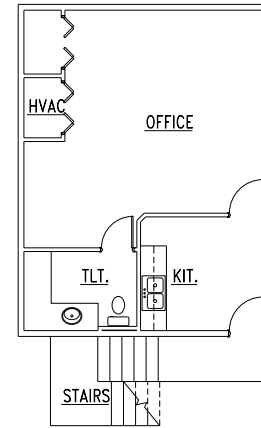

② SECOND FLOOR PLAN
1/4" = 1'-0"
536 SF

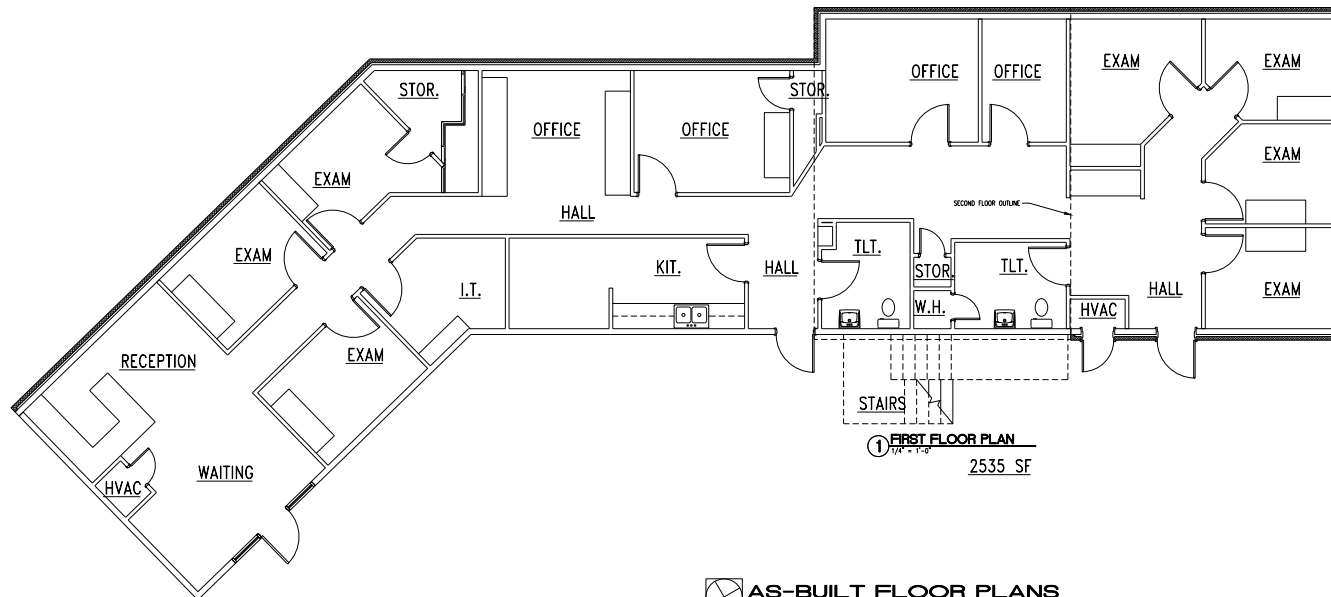

① FIRST FLOOR PLAN
1/4" = 1'-0"
2535 SF

AS-BUILT FLOOR PLANS
SCALE: 1/4" = 1'-0"

CONTACT INFORMATION: PHONE: 512-750-5587 | EMAIL: novyco@austin.rr.com | ADDRESS: P.O. BOX 28054 AUSTIN, TX 78755




THE
NOVY COMPANY
PROFESSIONAL REAL ESTATE SERVICES

All information furnished regarding this property is from sources deemed reliable; however The Novy Company nor its affiliates has not made an independent investigation of these sources and no warranty or representation has been made to the accuracy; therefore this property marketing package is submitted subject to errors, omissions, change of price, rental, sale, lease, withdrawal from market, or other conditions without notice. The Novy Company nor its affiliates have made, and shall not make any warranty or representations as to the condition of the real estate property nor the presence of any hazardous substances or any environmental or other conditions that may affect the value or suitability of the real estate property. All other marks displayed on this document are the property of their respective owners. The Novy Company. All rights reserved <https://thenovycompany.com>.

SITE AERIAL

LEASE BACK MEDICAL OFFICE BUILDING

1623 RIVERY BLVD, GEORGETOWN TEXAS 78628

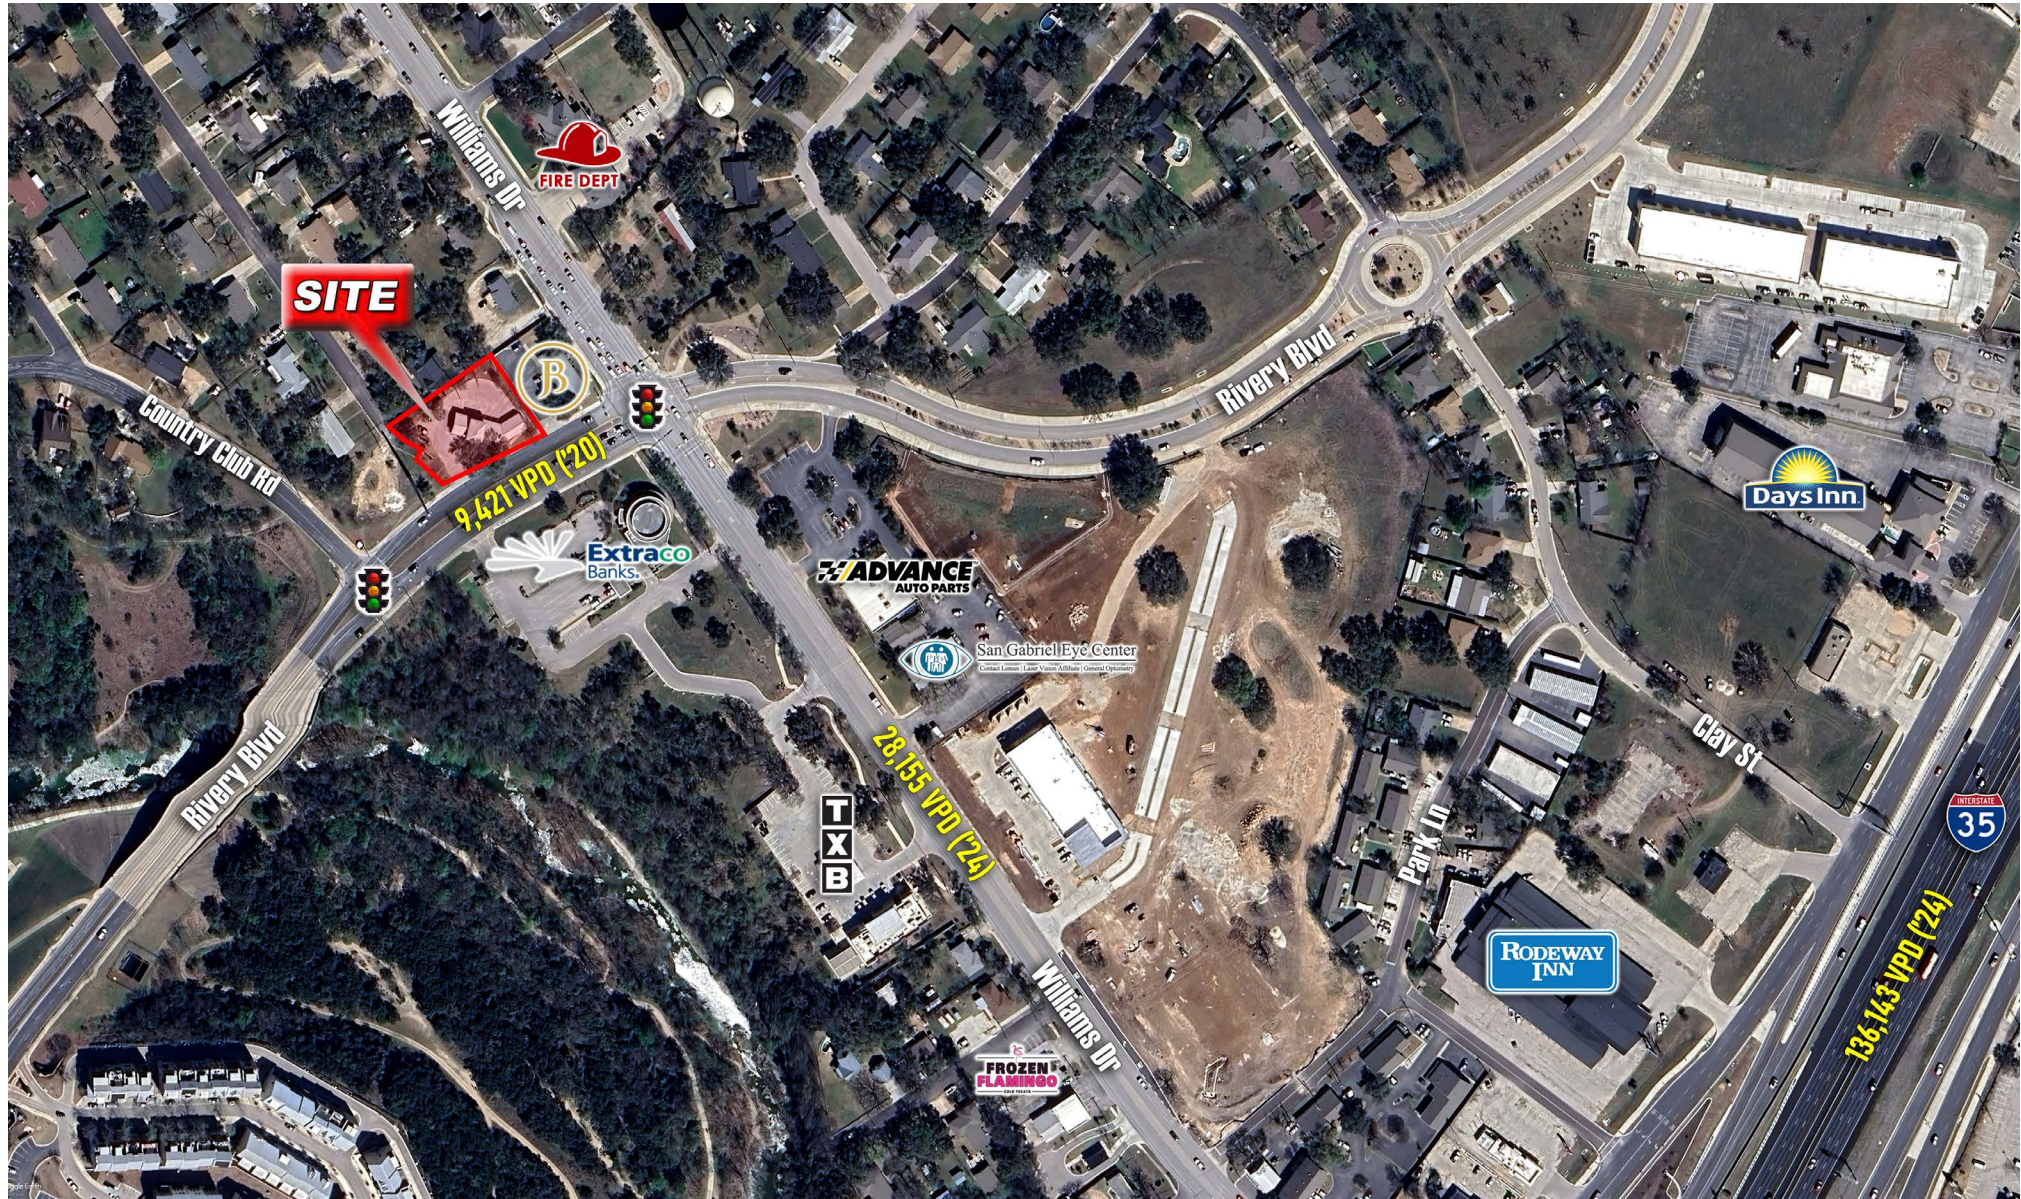

CONTACT INFORMATION: PHONE: 512-750-5587 | EMAIL: novyco@austin.rr.com | ADDRESS: P.O. BOX 28054 AUSTIN, TX 78755




THE
NOVY COMPANY
PROFESSIONAL REAL ESTATE SERVICES

All information furnished regarding this property is from sources deemed reliable; however The Novy Company nor its affiliates has not made an independent investigation of these sources and no warranty or representation has been made to the accuracy; therefore this property marketing package is submitted subject to errors, omissions, change of price, rental, sale, lease, withdrawal from market, or other conditions without notice. The Novy Company nor its affiliates have made, and shall not make any warranty or representations as to the condition of the real estate property nor the presence of any hazardous substances or any environmental or other conditions that may affect the value or suitability of the real estate property. All other marks displayed on this document are the property of their respective owners. The Novy Company, All rights reserved <https://thenovycompany.com>.

WIDE AERIAL

LEASE BACK MEDICAL OFFICE BUILDING

1623 RIVERY BLVD, GEORGETOWN TEXAS 78628

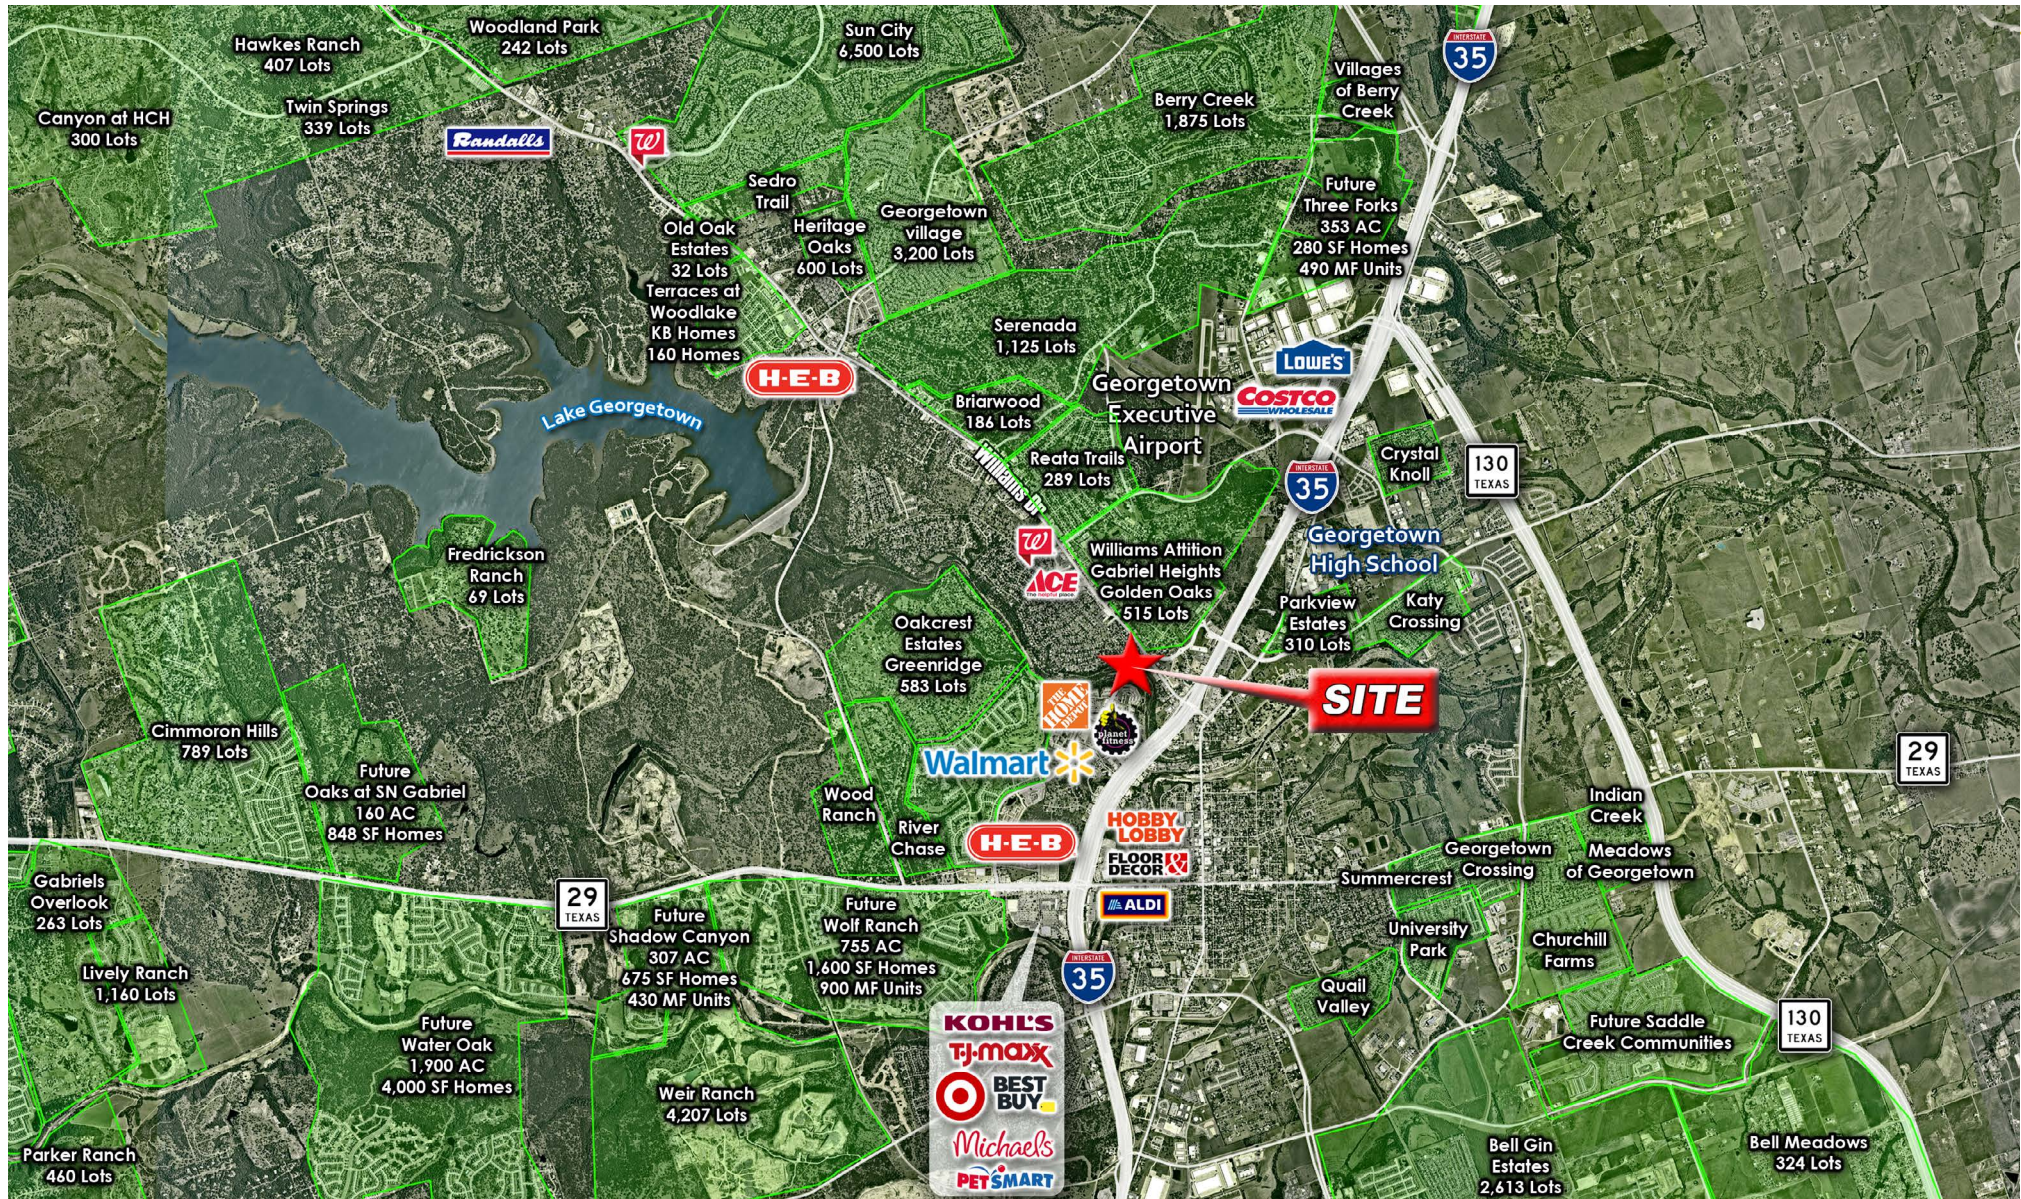

CONTACT INFORMATION: PHONE: 512-750-5587 | EMAIL: novyco@austin.rr.com | ADDRESS: P.O. BOX 28054 AUSTIN, TX 78755



All information furnished regarding this property is from sources deemed reliable; however The Novy Company nor its affiliates has not made an independent investigation of these sources and no warranty or representation has been made to the accuracy; therefore this property marketing package is submitted subject to errors, omissions, change of price, rental, sale, lease, withdrawal from market, or other conditions without notice. The Novy Company nor its affiliates have made, and shall not make any warranty or representations as to the condition of the real estate property nor the presence of any hazardous substances or any environmental or other conditions that may affect the value or suitability of the real estate property. All other marks displayed on this document are the property of their respective owners. The Novy Company, All rights reserved <https://thenovycompany.com>.



Information About Brokerage Services

Texas law requires all real estate license holders to give the following information about brokerage services to prospective buyers, tenants, sellers and landlords.

2-10-2025



TYPES OF REAL ESTATE LICENSE HOLDERS:

- A **BROKER** is responsible for all brokerage activities, including acts performed by sales agents sponsored by the broker.
- A **SALES AGENT** must be sponsored by a broker and works with clients on behalf of the broker.

A BROKER'S MINIMUM DUTIES REQUIRED BY LAW (A client is the person or party that the broker represents):

- Put the interests of the client above all others, including the broker's own interests;
- Inform the client of any material information about the property or transaction received by the broker;
- Answer the client's questions and present any offer to or counter-offer from the client; and
- Treat all parties to a real estate transaction honestly and fairly.

A LICENSE HOLDER CAN REPRESENT A PARTY IN A REAL ESTATE TRANSACTION:

AS AGENT FOR OWNER (SELLER/LANDLORD): The broker becomes the property owner's agent through an agreement with the owner, usually in a written listing to sell or property management agreement. An owner's agent must perform the broker's minimum duties above and must inform the owner of any material information about the property or transaction known by the agent, including information disclosed to the agent or subagent by the buyer or buyer's agent. **An owner's agent fees are not set by law and are fully negotiable.**

AS AGENT FOR BUYER/TENANT: The broker becomes the buyer/tenant's agent by agreeing to represent the buyer, usually through a written representation agreement. A buyer's agent must perform the broker's minimum duties above and must inform the buyer of any material information about the property or transaction known by the agent, including information disclosed to the agent by the seller or seller's agent. **A buyer/tenant's agent fees are not set by law and are fully negotiable.**

AS AGENT FOR BOTH - INTERMEDIARY: To act as an intermediary between the parties the broker must first obtain the written agreement of *each party* to the transaction. The written agreement must state who will pay the broker and, in conspicuous bold or underlined print, set forth the broker's obligations as an intermediary. A broker who acts as an intermediary:

- Must treat all parties to the transaction impartially and fairly;
- May, with the parties' written consent, appoint a different license holder associated with the broker to each party (owner and buyer) to communicate with, provide opinions and advice to, and carry out the instructions of each party to the transaction.
- Must not, unless specifically authorized in writing to do so by the party, disclose:
 - that the owner will accept a price less than the written asking price;
 - that the buyer/tenant will pay a price greater than the price submitted in a written offer; and
 - any confidential information or any other information that a party specifically instructs the broker in writing not to disclose, unless required to do so by law.

AS SUBAGENT: A license holder acts as a subagent when aiding a buyer in a transaction without an agreement to represent the buyer. A subagent can assist the buyer but does not represent the buyer and must place the interests of the owner first.

TO AVOID DISPUTES, ALL AGREEMENTS BETWEEN YOU AND A BROKER SHOULD BE IN WRITING AND CLEARLY ESTABLISH:

- The broker's duties and responsibilities to you, and your obligations under the representation agreement.
- Who will pay the broker for services provided to you, when payment will be made and how the payment will be calculated.

LICENSE HOLDER CONTACT INFORMATION: This notice is being provided for information purposes. It does not create an obligation for you to use the broker's services. Please acknowledge receipt of this notice below and retain a copy for your records.

Brian Novy Company

255097

novyco@austin.rr.com

512.327.7613

Licensed Broker/Broker Firm Name or Primary Assumed Business Name

License No.

Email

Phone

Brian Novy

255097

novyco@austin.rr.com

512.750.5587

Designated Broker of Firm

License No.

Email

Phone

Licensed Supervisor of Sales Agent/Associate

License No.

Email

Phone

Sales Agent/Associate's Name

License No.

Email

Phone

Buyer/Tenant/Seller/Landlord Initials

Date

Regulated by the Texas Real Estate Commission

Information available at www.trec.texas.gov

IABS 1-1