



## Great offices available in desirable West Mesa



Excellent frontage on Alma School Road



Convenient access to US-60 and Loop-101



Monument signage available



Three-story building featuring impressive atrium lobby with water feature



**For further  
information**

**Nicholas Pelusio**  
D 480 423 7903 | C 602 505 3010  
nicholas.pelusio@avisonyoung.com

avisonyoung.com

2720 E Camelback Road | Suite 210 | Phoenix, AZ 85016

© 2026 Avison Young - Arizona, Ltd. All rights reserved. E. & O.E.: The information contained herein was obtained from sources which we deem reliable and, while thought to be correct, is not guaranteed by Avison Young.

# Property overview

**Office spaces for lease**  
1839 S Alma School Rd  
Mesa, AZ 85210

## Availability

Suites	Square feet
Suite 135	±2,436 rsf
Suite 145	±2,317 rsf
Suite 150	±4,106 rsf
Suite 170	±1,689 rsf
Suite 205	±2,489 rsf
Suite 248	±1,229 rsf
Suite 325	±1,385 rsf
Suite 335	±2,530 rsf
Suite 380	±4,434 rsf

## Term

- 3 & 5 year

## Building

- Size: ±69,916 sf

## Load factor

- 13.5%

## Parking

- Covered available

## Rate

- \$24.00 - \$25.00/rsf (Full Service)
- Operating expenses: base year
- Tenant improvements: negotiable




**Nicholas Pelusio**  
D 480 423 7903 | C 602 505 3010  
nicholas.pelusio@avisonyoung.com

**AVISON  
YOUNG**

# Photos

Office spaces for lease  
1839 S Alma School Rd  
Mesa, AZ 85210


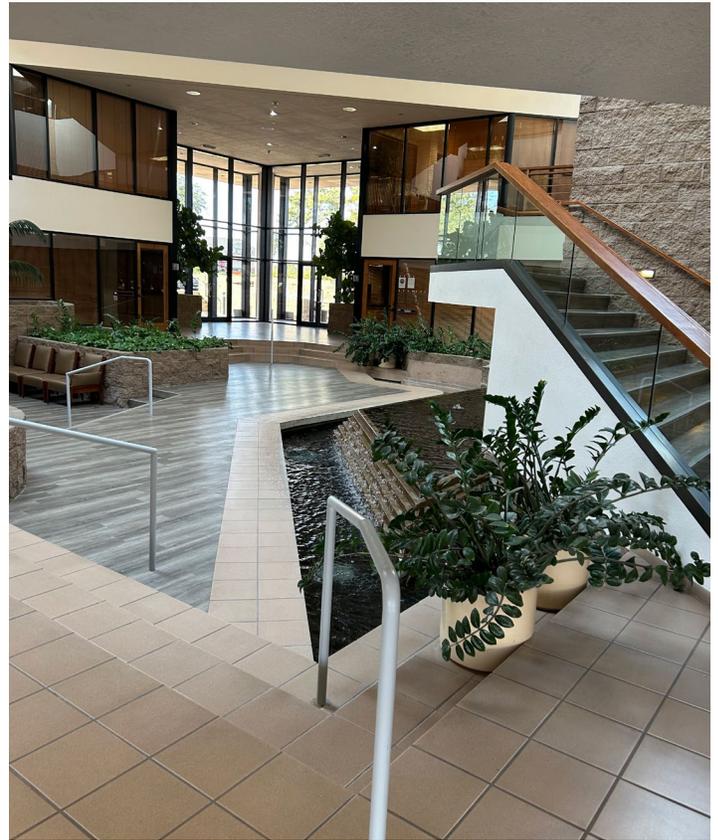


**Nicholas Pelusio**  
D 480 423 7903 | C 602 505 3010  
nicholas.pelusio@avisonyoung.com

**AVISON  
YOUNG**

# Photos

**Office spaces for lease**  
1839 S Alma School Rd  
Mesa, AZ 85210

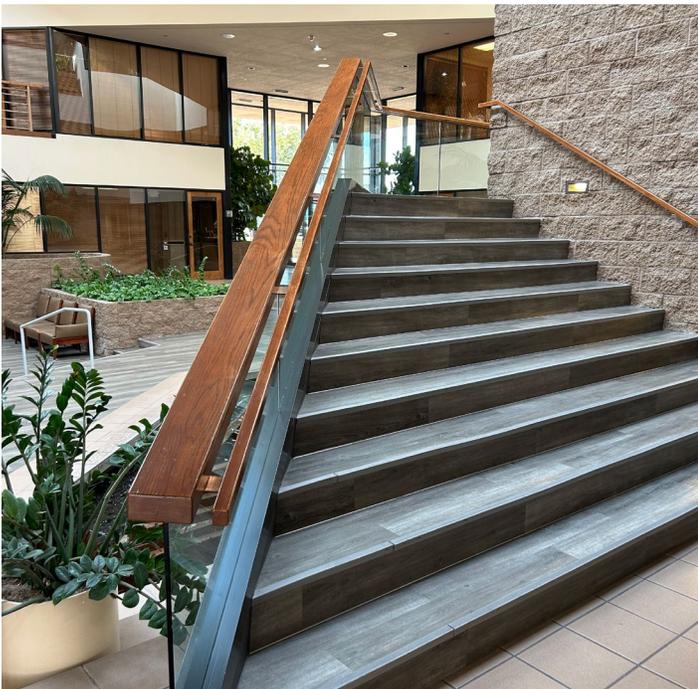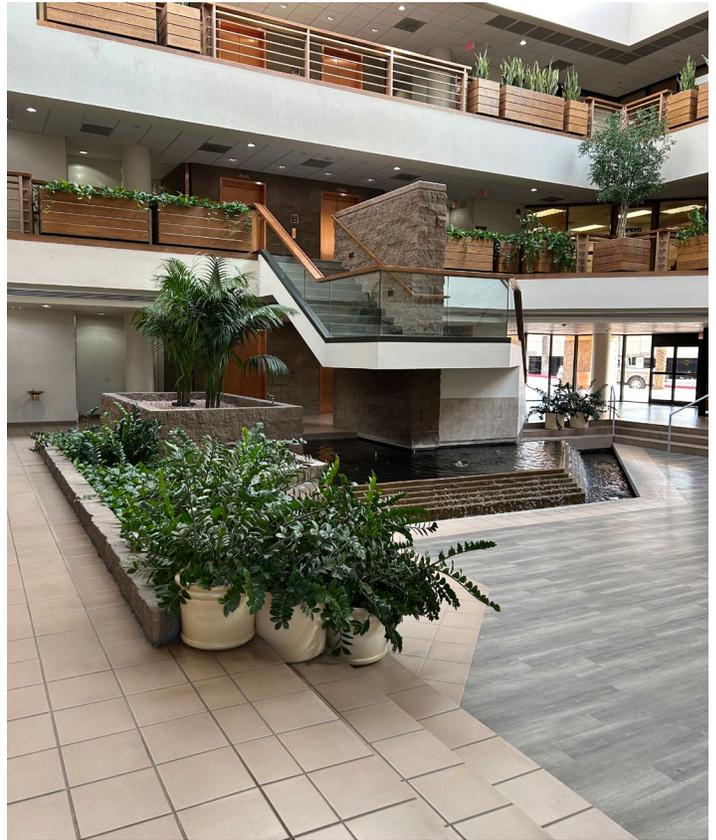

**Nicholas Pelusio**  
D 480 423 7903 | C 602 505 3010  
nicholas.pelusio@avisonyoung.com



**AVISON  
YOUNG**

# Location

## Office spaces for lease

1839 S Alma School Rd

Mesa, AZ 85210

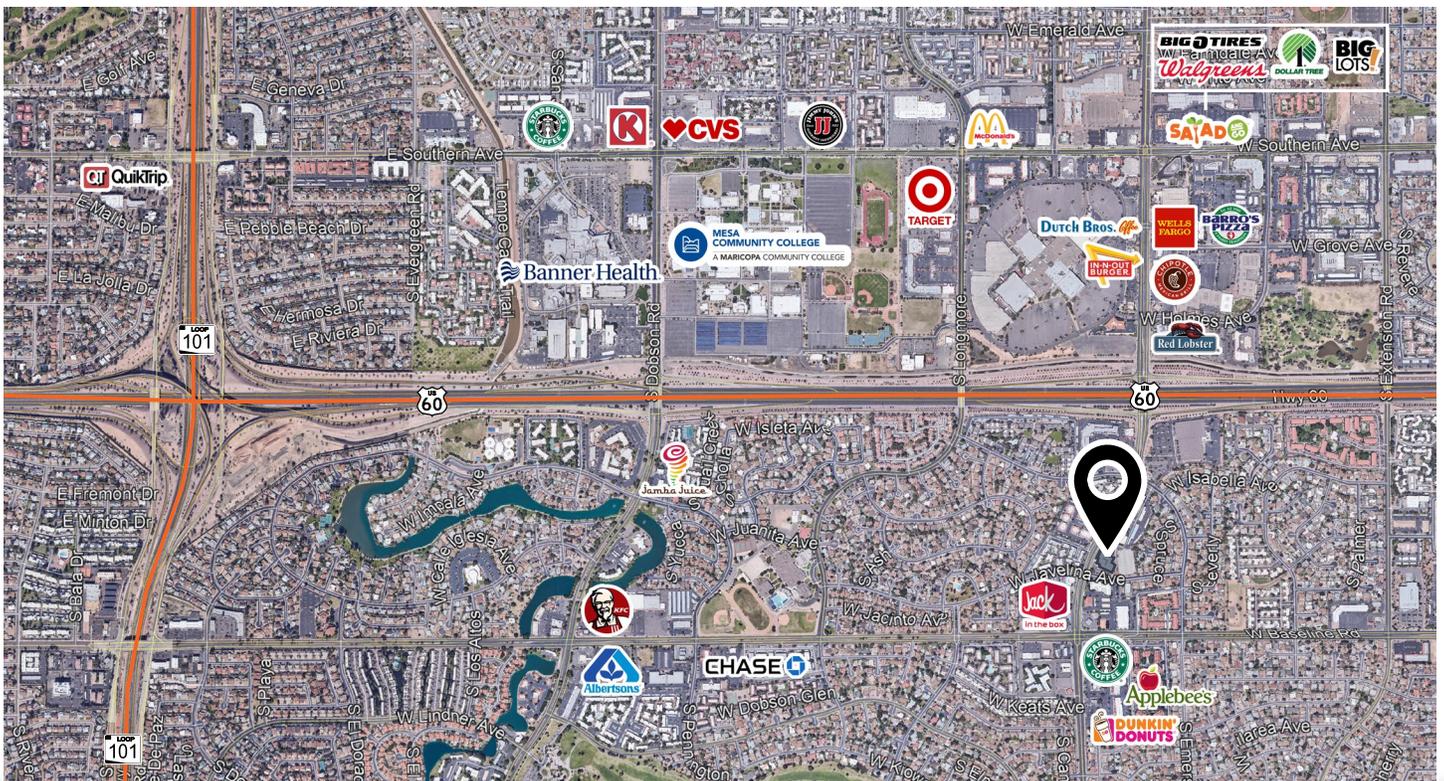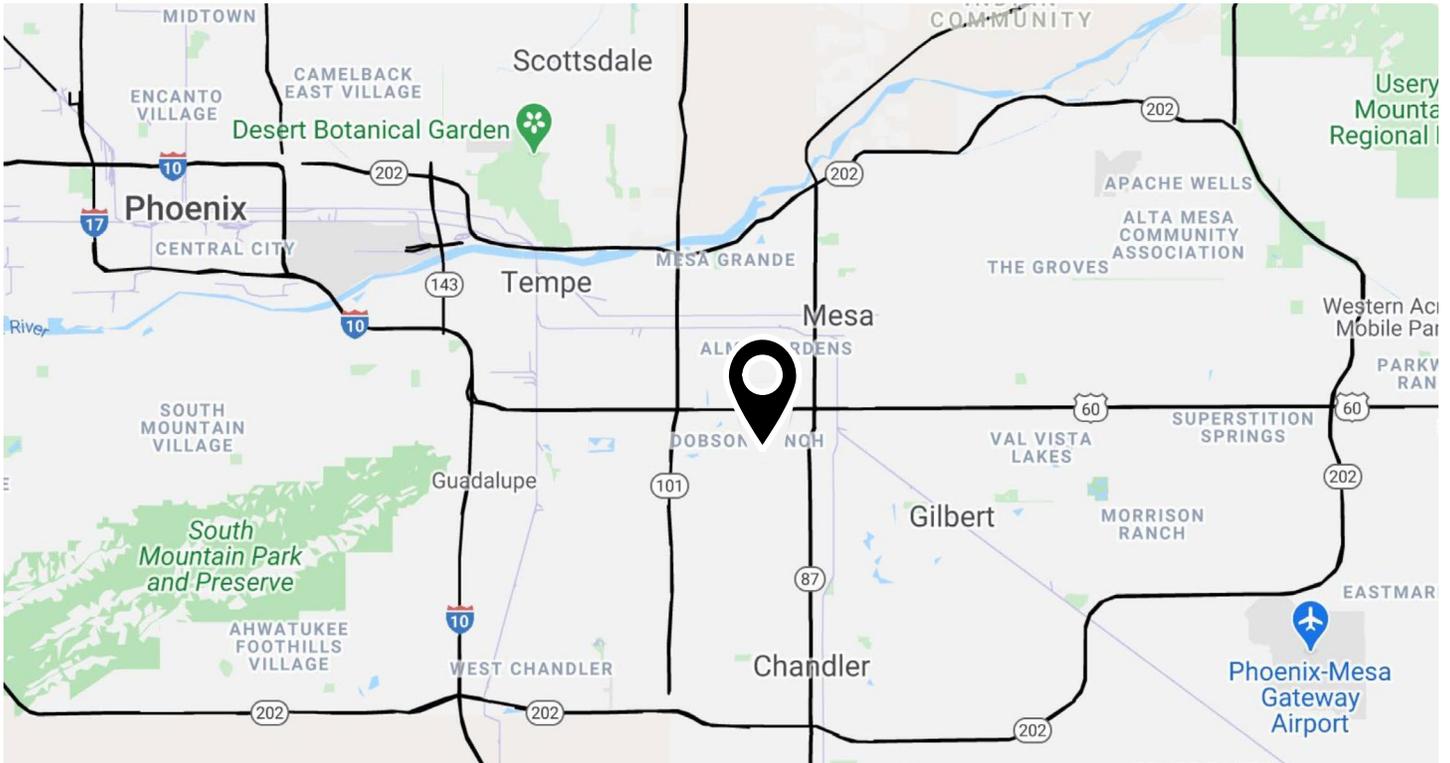

**Nicholas Pelusio**


D 480 423 7903 | C 602 505 3010

nicholas.pelusio@avisonyoung.com

**AVISON  
YOUNG**

# Floor plan Level 1

Office spaces for lease  
1839 S Alma School Rd  
Mesa, AZ 85210

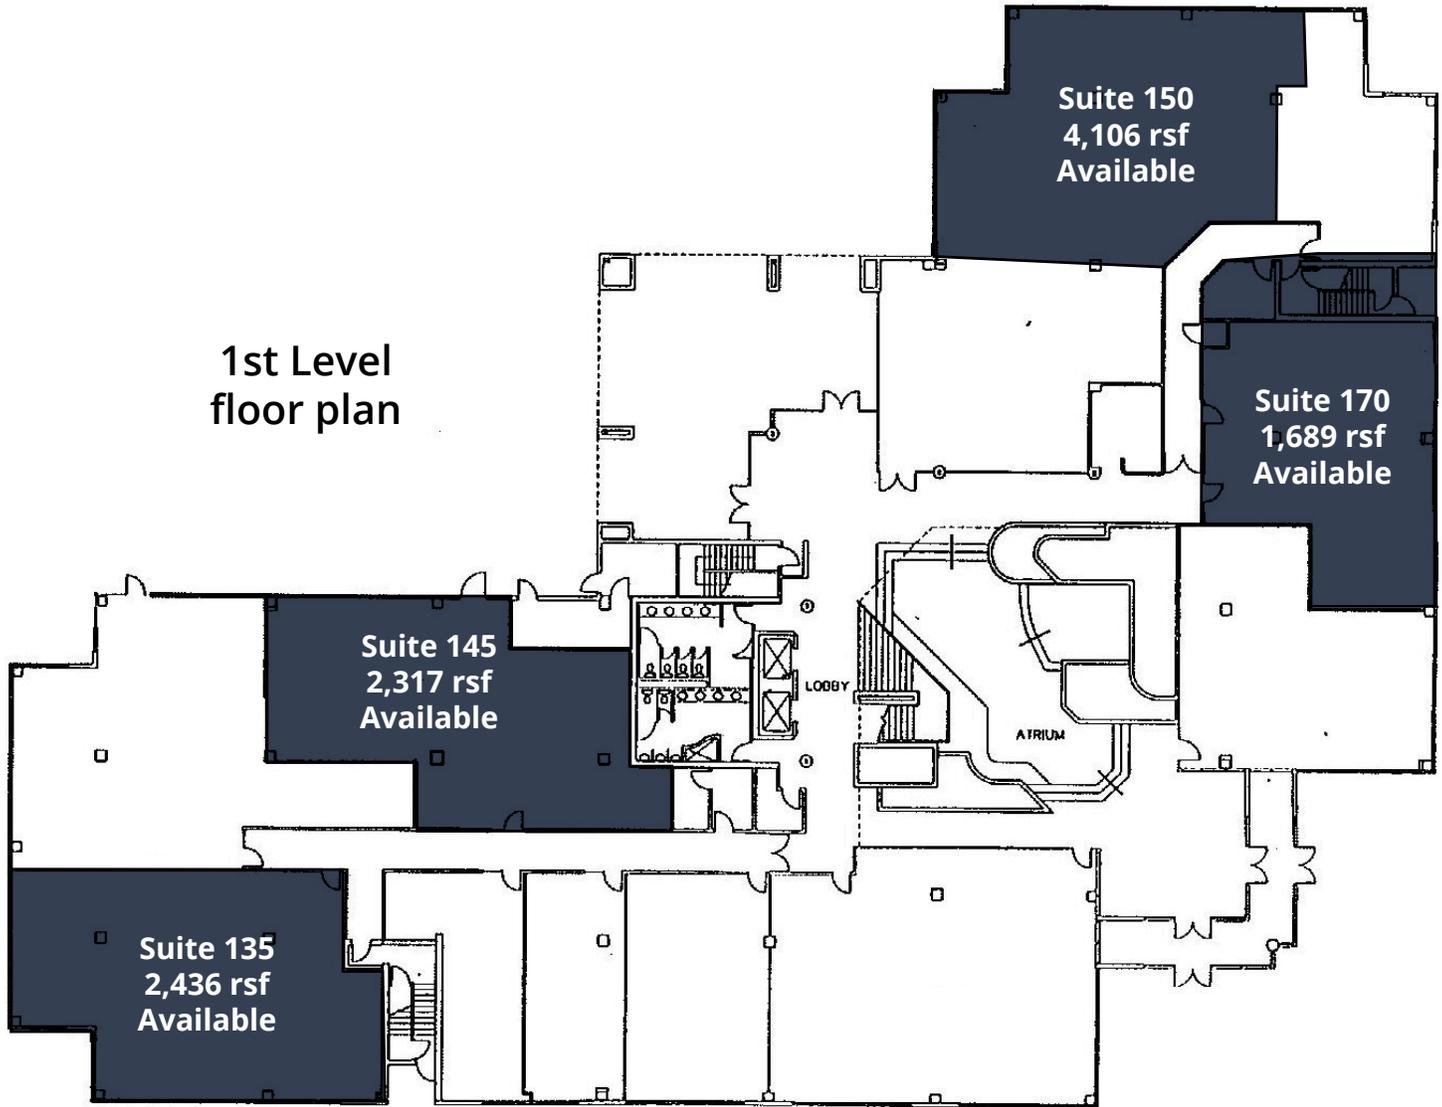


**Nicholas Pelusio**  
D 480 423 7903 | C 602 505 3010  
nicholas.pelusio@avisonyoung.com

**AVISON  
YOUNG**

# Floor plan Level 1

Office spaces for lease  
1839 S Alma School Rd  
Mesa, AZ 85210

Suite 135  
±2,436 rsf

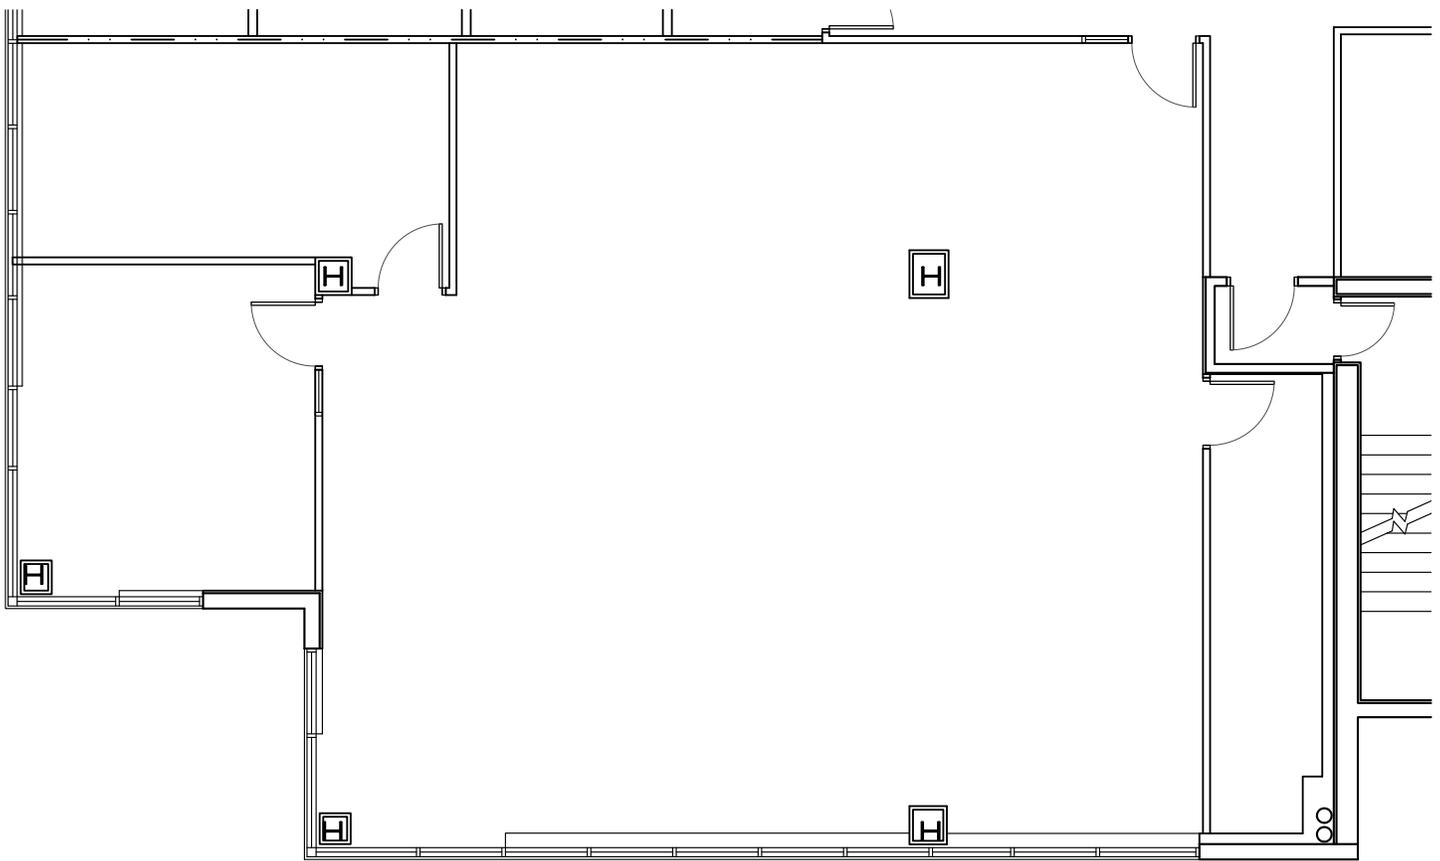


**Nicholas Pelusio**  
D 480 423 7903 | C 602 505 3010  
nicholas.pelusio@avisonyoung.com

**AVISON  
YOUNG**

# Floor plan Level 1

Office spaces for lease  
1839 S Alma School Rd  
Mesa, AZ 85210

Suite 145  
±2,317 rsf

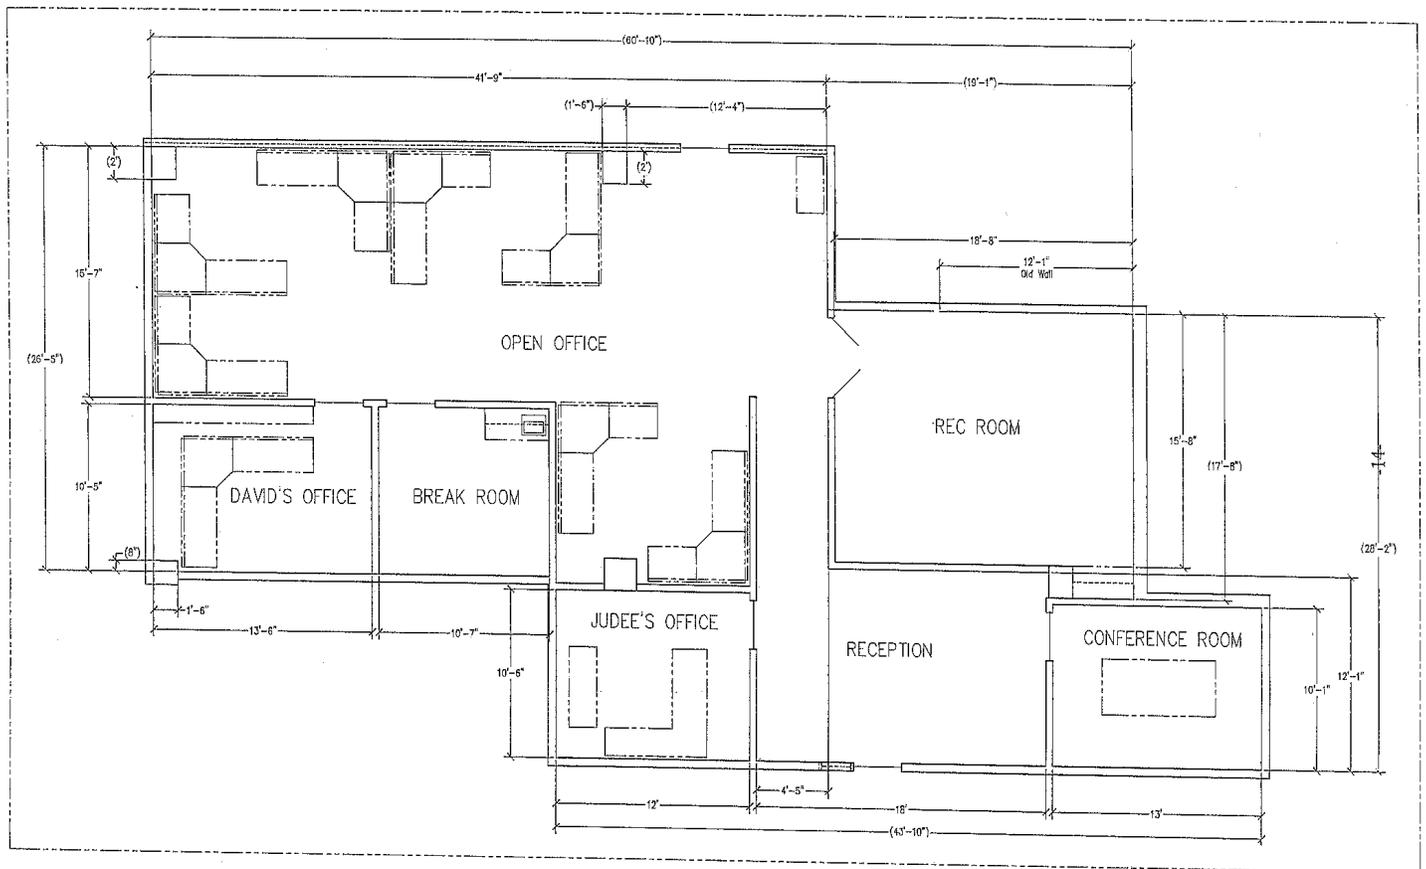


**Nicholas Pelusio**  
D 480 423 7903 | C 602 505 3010  
nicholas.pelusio@avisonyoung.com

**AVISON  
YOUNG**

# Floor plan Level 1

Office spaces for lease  
1839 S Alma School Rd  
Mesa, AZ 85210

Suite 150  
±4,106 rsf

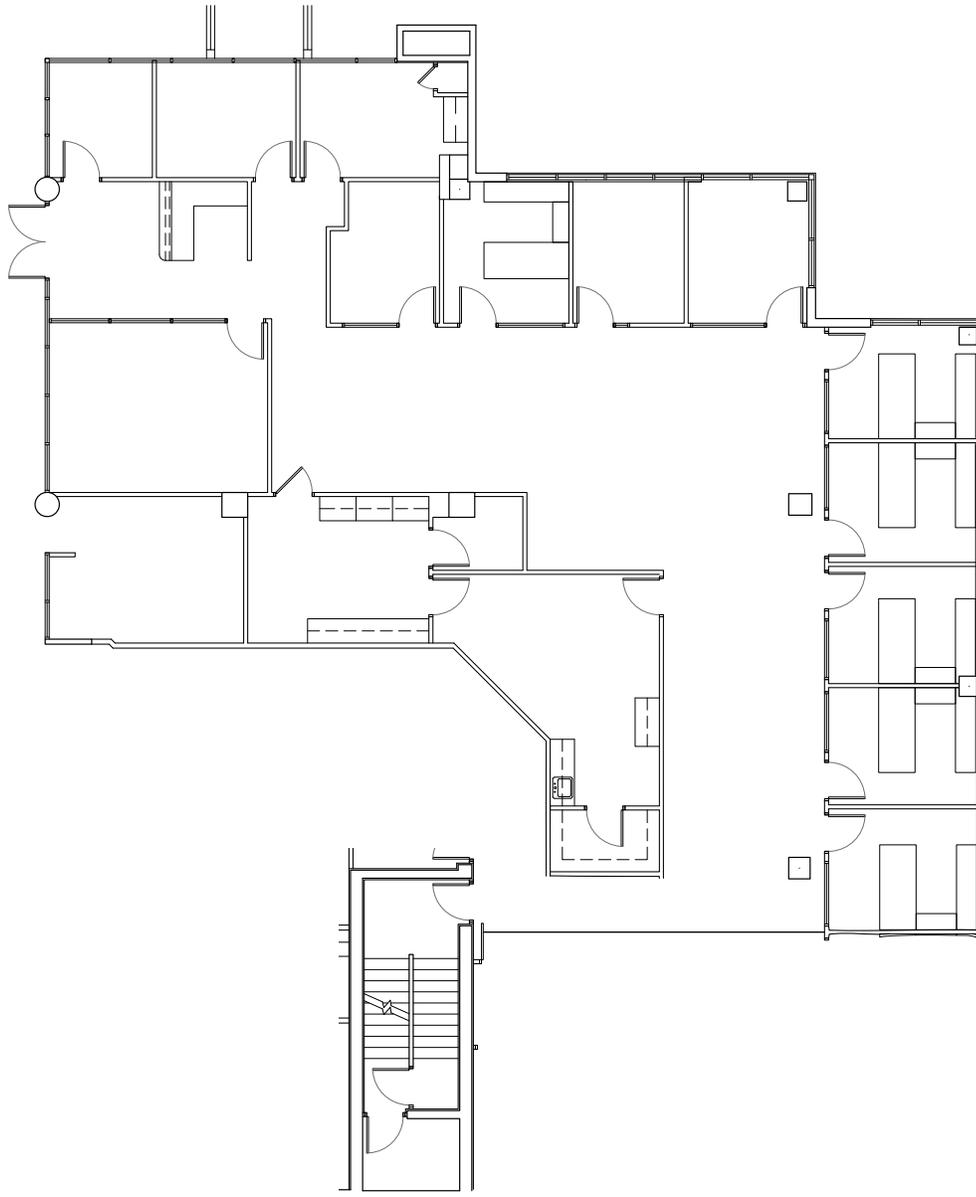


**Nicholas Pelusio**  
D 480 423 7903 | C 602 505 3010  
nicholas.pelusio@avisonyoung.com

**AVISON  
YOUNG**

# Floor plan Level 1

Office spaces for lease  
1839 S Alma School Rd  
Mesa, AZ 85210

Suite 170  
±1,689 rsf

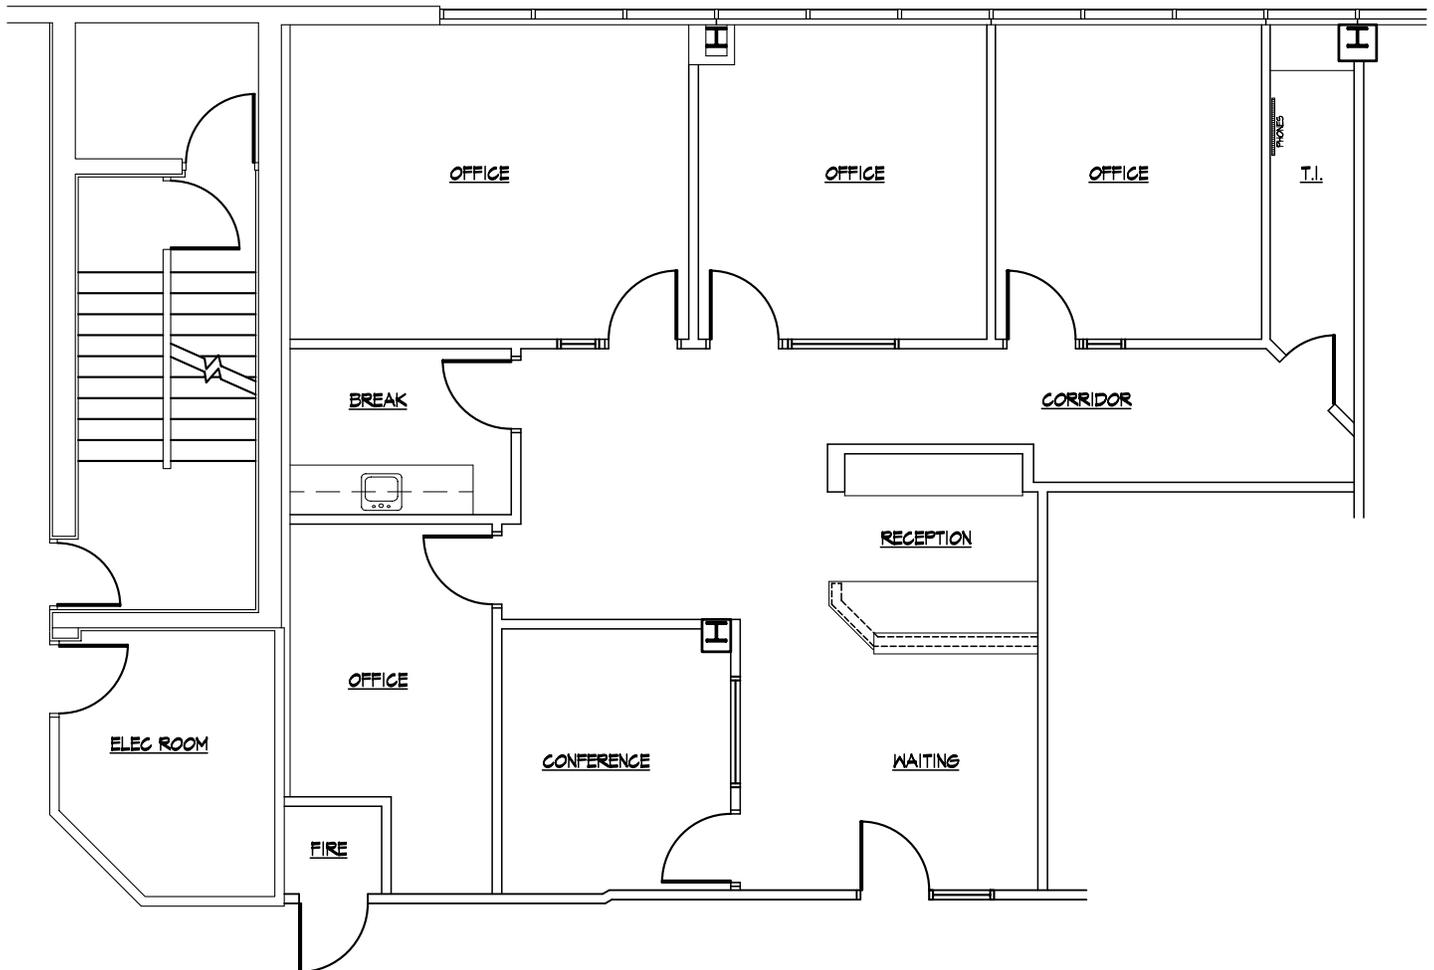

**Nicholas Pelusio**  
D 480 423 7903 | C 602 505 3010  
nicholas.pelusio@avisonyoung.com

**AVISON  
YOUNG**

# Floor plan Level 2

Office spaces for lease  
1839 S Alma School Rd  
Mesa, AZ 85210




**Nicholas Pelusio**  
D 480 423 7903 | C 602 505 3010  
nicholas.pelusio@avisonyoung.com

**AVISON  
YOUNG**

# Floor plan Level 2

Office spaces for lease  
1839 S Alma School Rd  
Mesa, AZ 85210

Suite 205  
±2,489 rsf

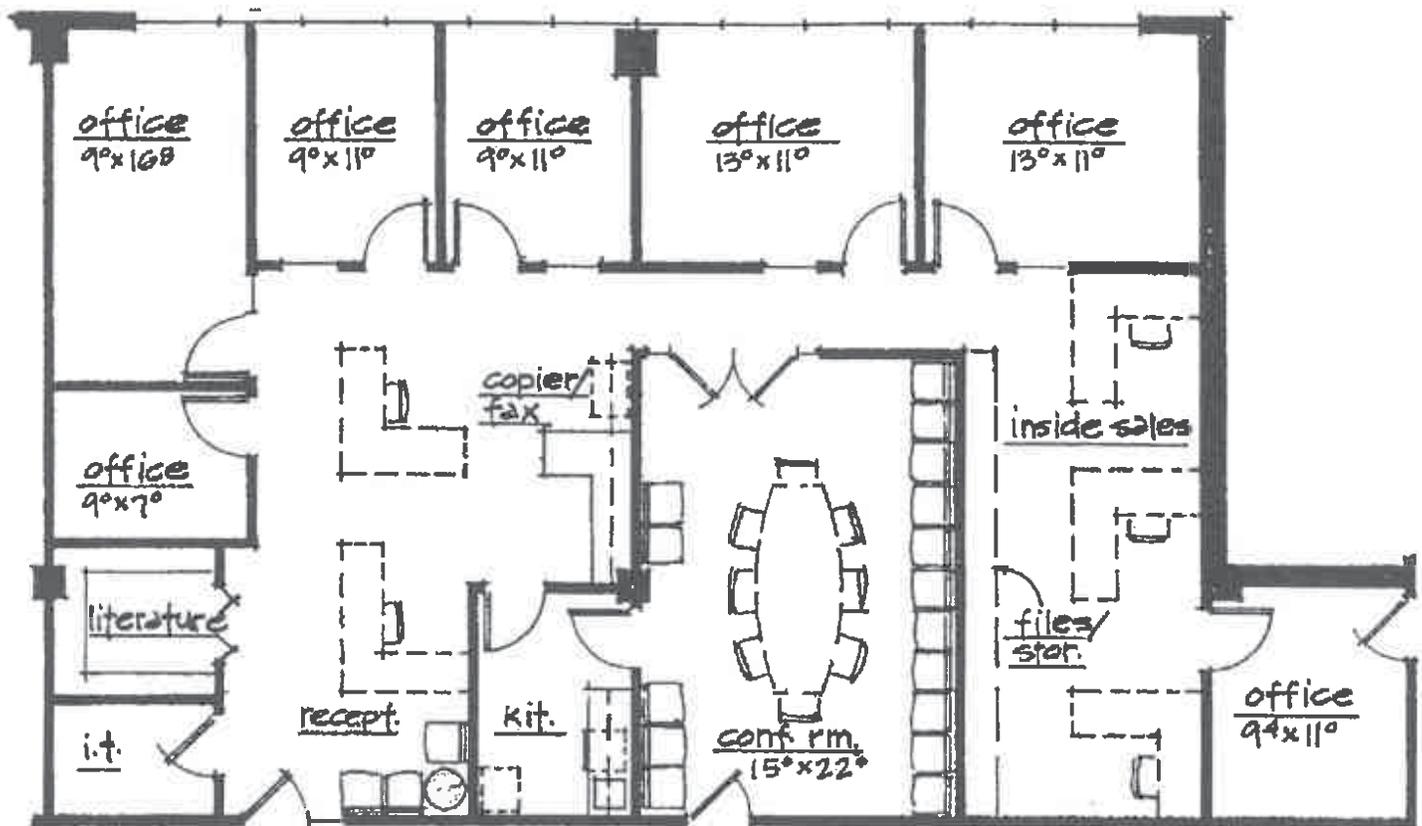


**Nicholas Pelusio**  
D 480 423 7903 | C 602 505 3010  
nicholas.pelusio@avisonyoung.com

**AVISON  
YOUNG**


# Floor plan Level 2

Office spaces for lease  
1839 S Alma School Rd  
Mesa, AZ 85210

Suite 248  
±1,229 rsf

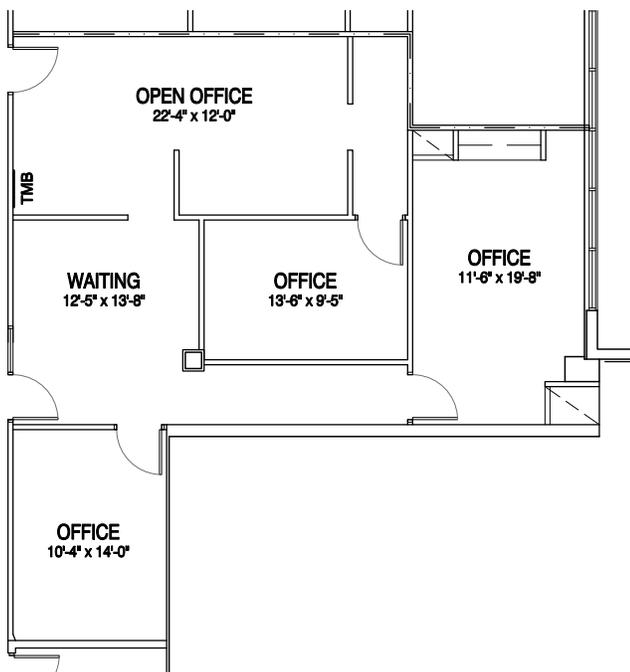

As-built

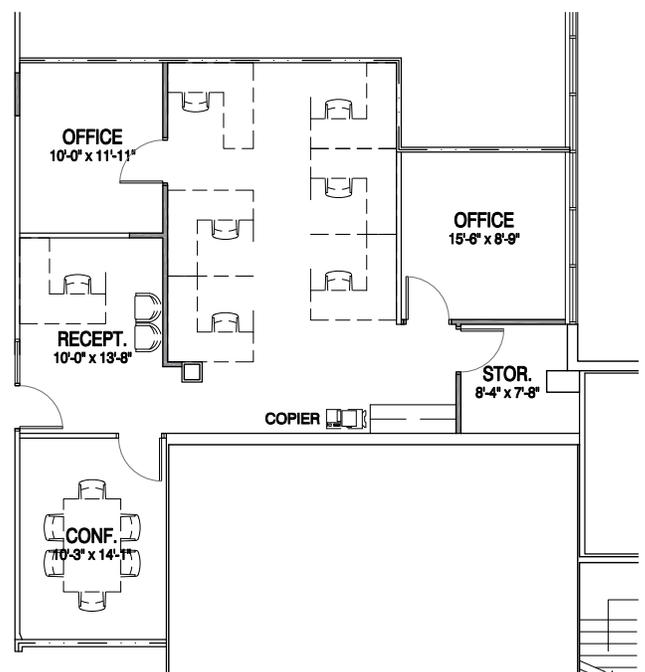


Conceptual

**Nicholas Pelusio**  
D 480 423 7903 | C 602 505 3010  
nicholas.pelusio@avisonyoung.com

**AVISON  
YOUNG**

# Floor plan Level 3

Office spaces for lease  
1839 S Alma School Rd  
Mesa, AZ 85210

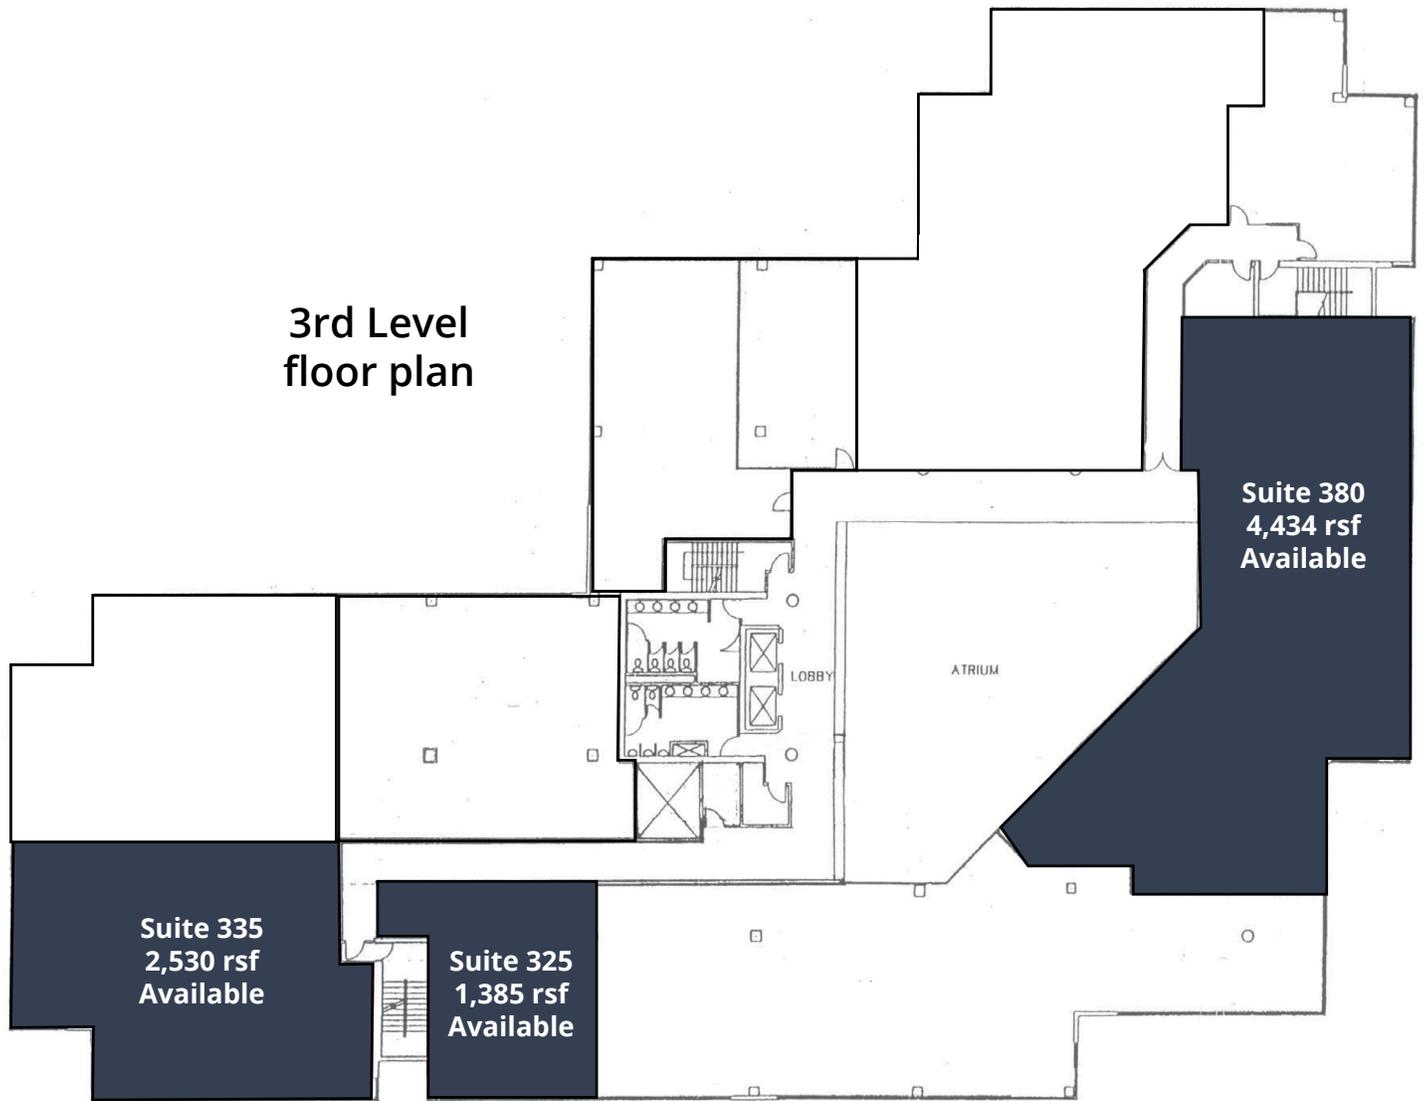


**Nicholas Pelusio**  
D 480 423 7903 | C 602 505 3010  
nicholas.pelusio@avisonyoung.com

**AVISON  
YOUNG**

# Floor plan Level 3

Office spaces for lease  
1839 S Alma School Rd  
Mesa, AZ 85210

Suite 325  
±1,385 rsf

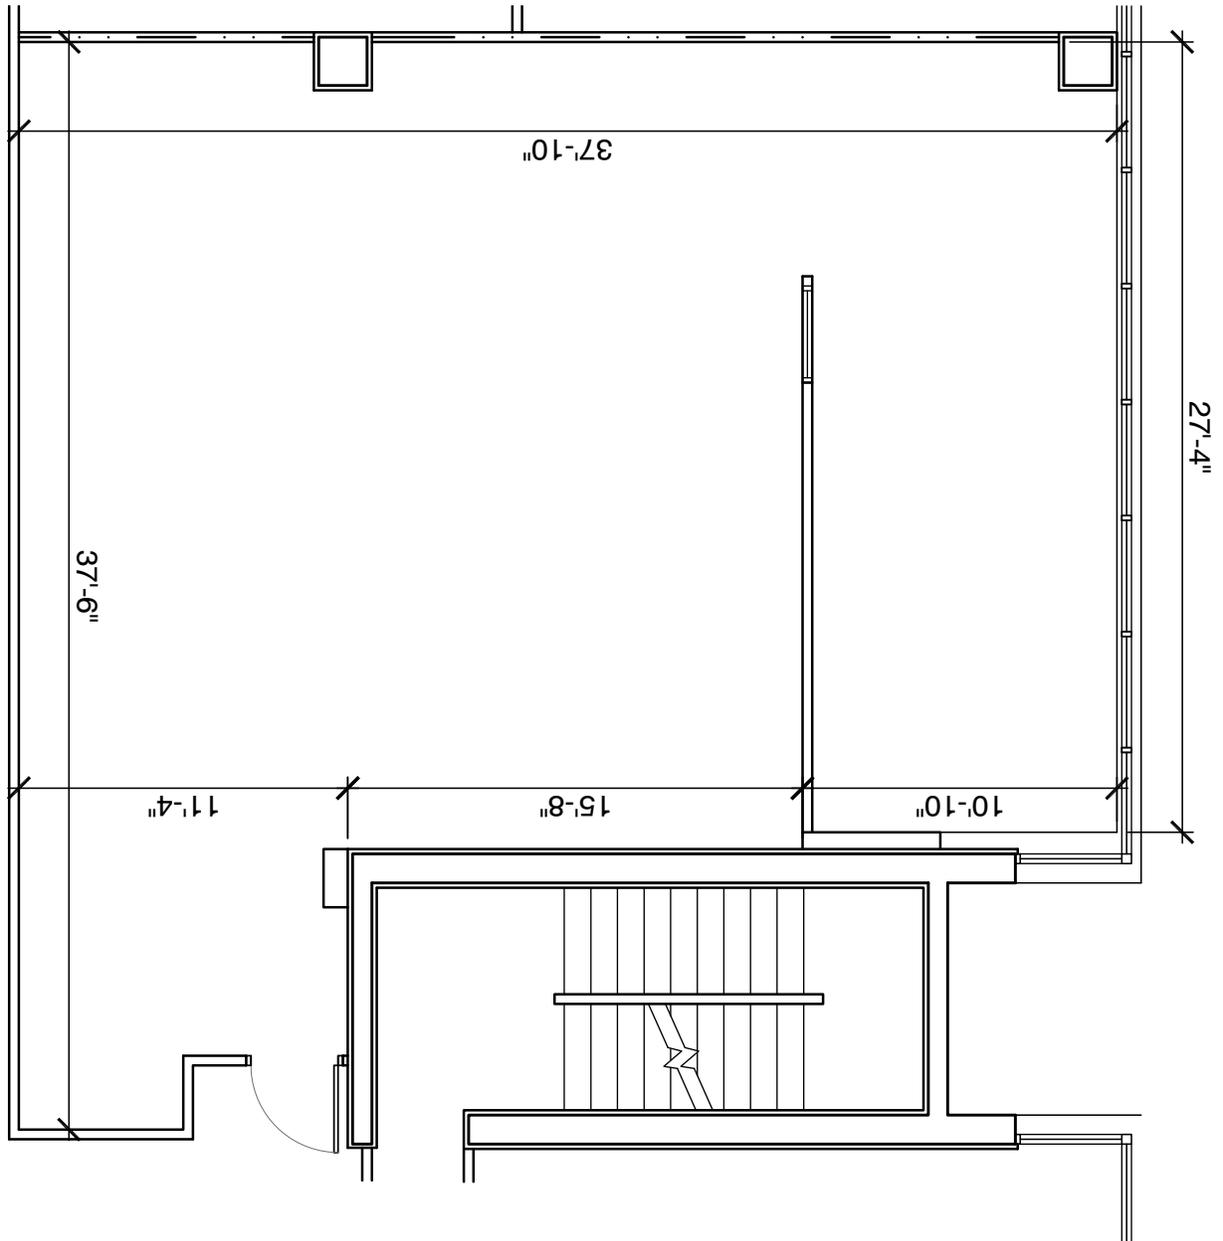


**Nicholas Pelusio**  
D 480 423 7903 | C 602 505 3010  
nicholas.pelusio@avisonyoung.com

**AVISON  
YOUNG**

# Floor plan Level 3

Office spaces for lease  
1839 S Alma School Rd  
Mesa, AZ 85210

Suite 335  
±2,530 rsf

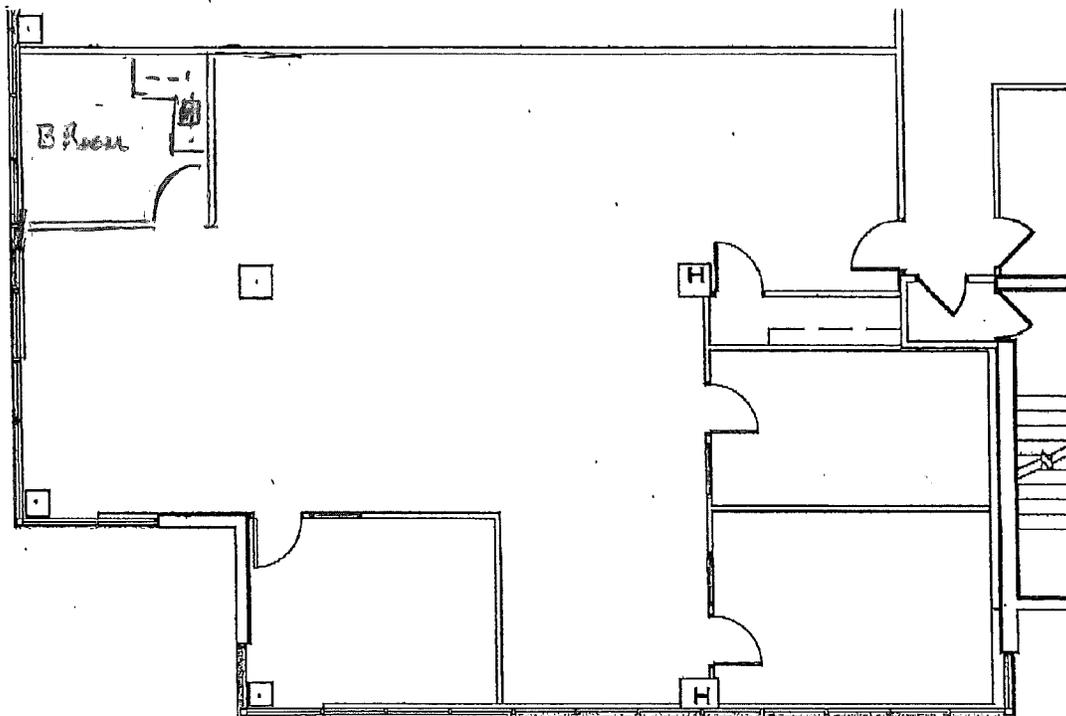


**Nicholas Pelusio**  
D 480 423 7903 | C 602 505 3010  
nicholas.pelusio@avisonyoung.com

**AVISON  
YOUNG**

# Floor plan Level 3

Office spaces for lease  
1839 S Alma School Rd  
Mesa, AZ 85210

Suite 380  
±4,434 rsf

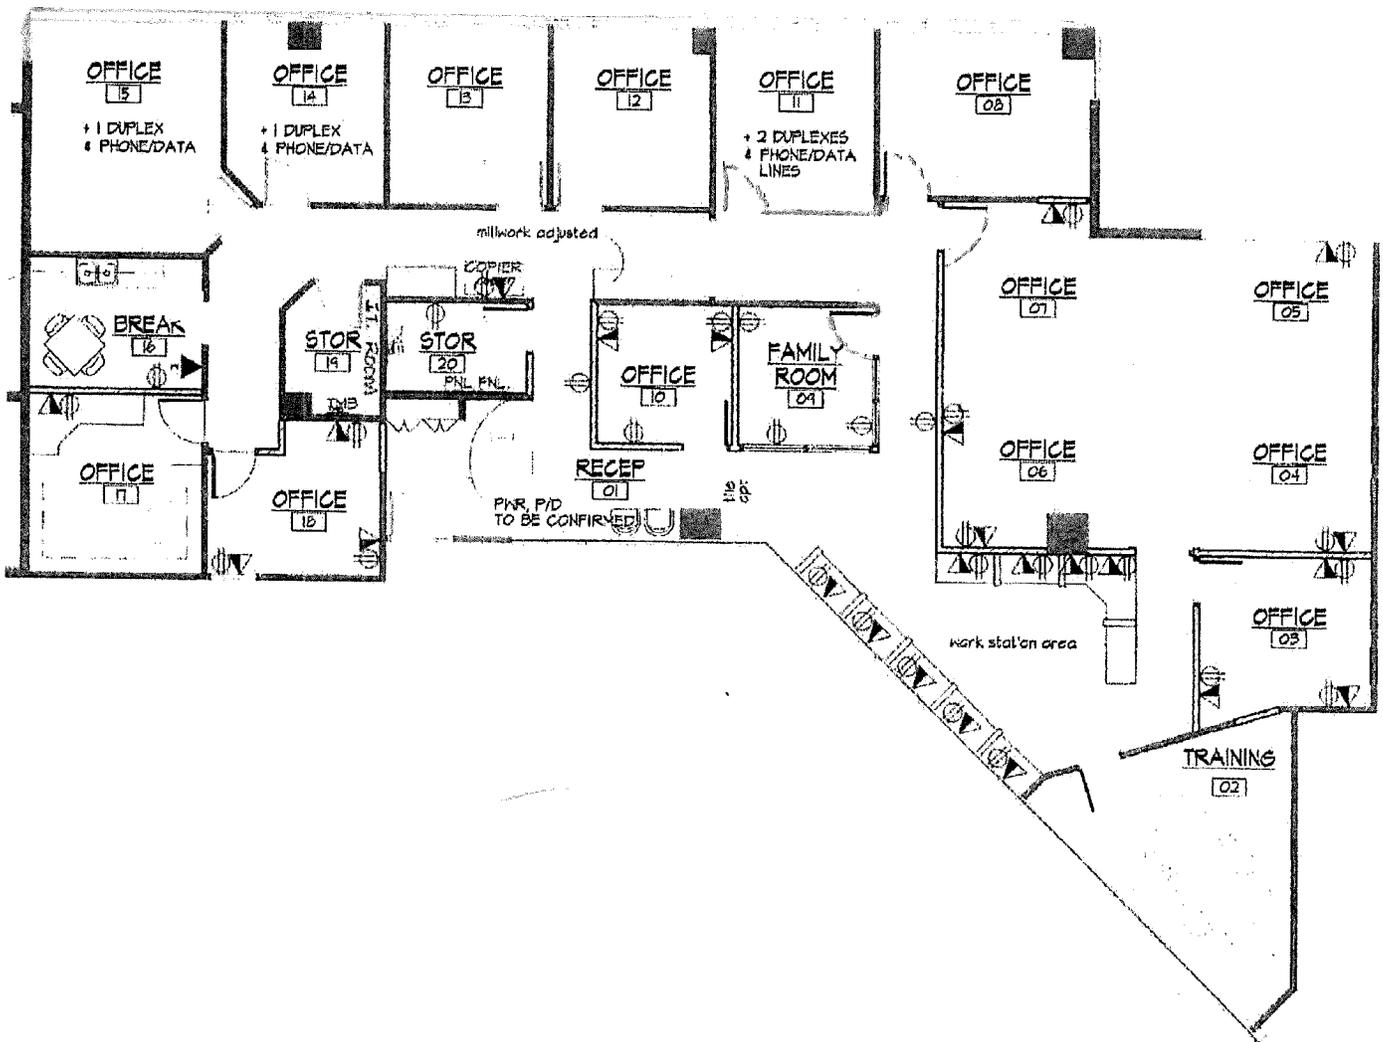

Nicholas Pelusio  
D 480 423 7903 | C 602 505 3010  
nicholas.pelusio@avisonyoung.com

AVISON  
YOUNG