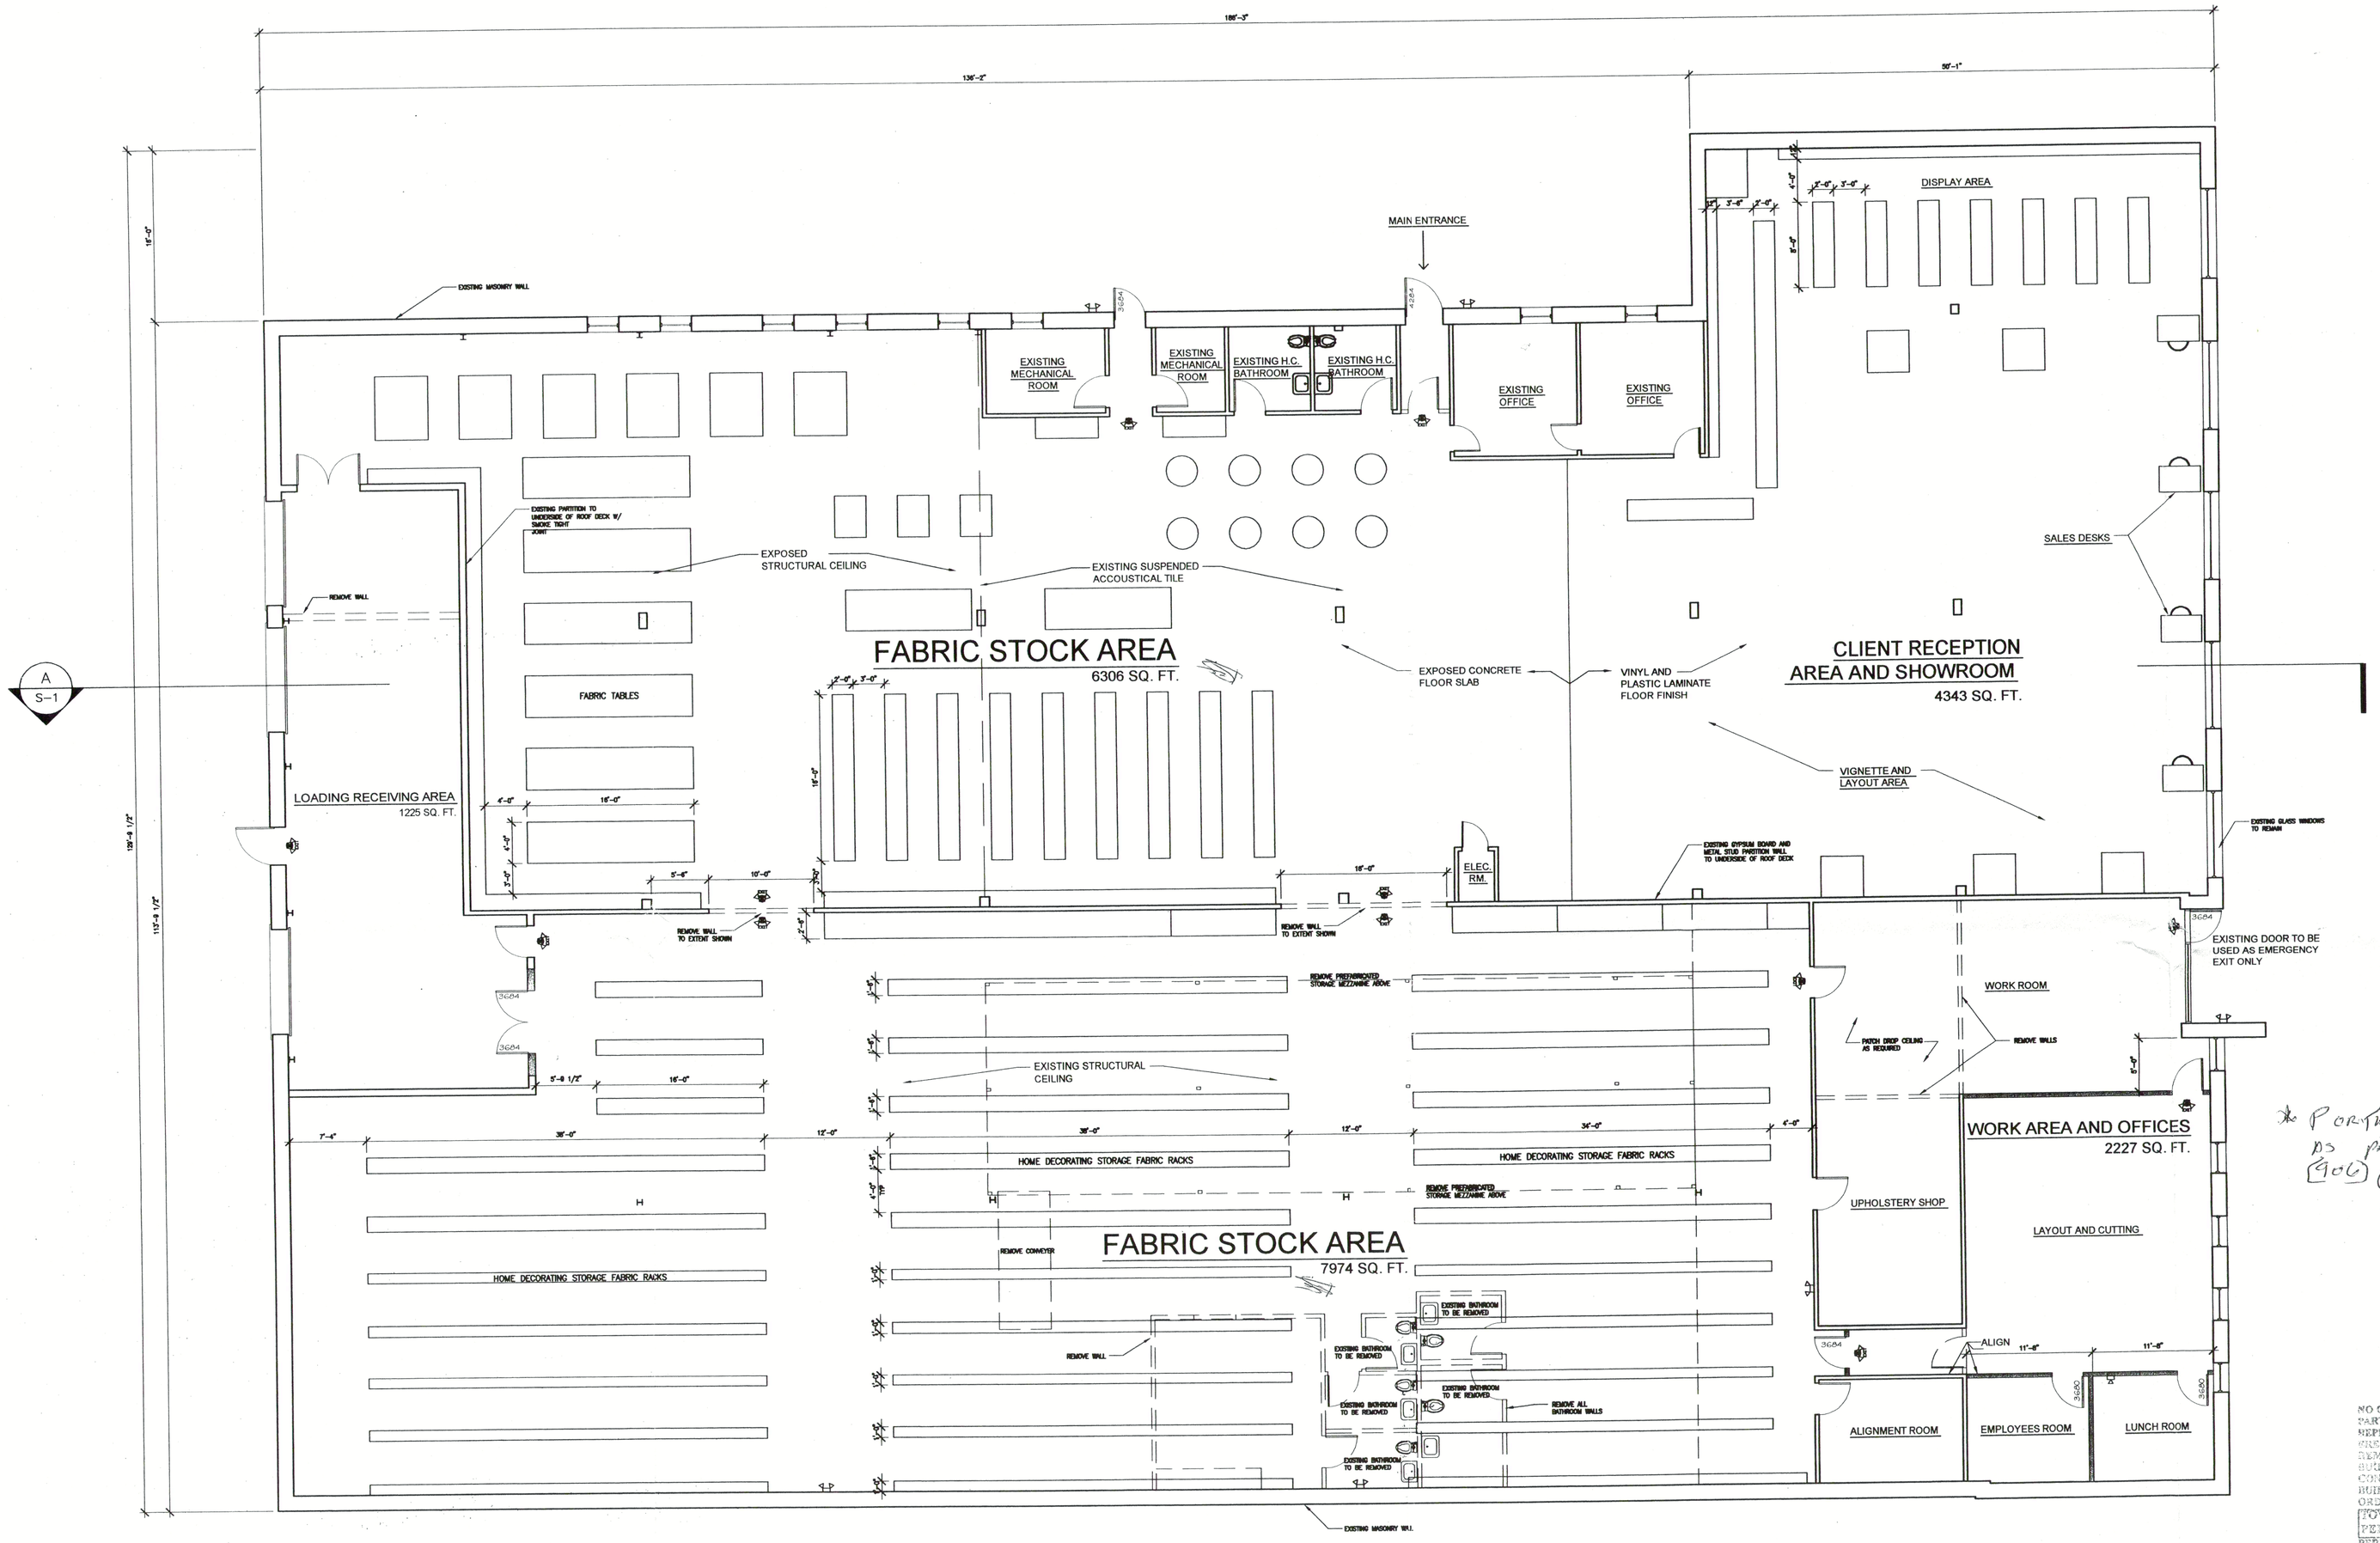

FLOOR PLAN

SCALE 1/8" = 1'-0"

* PORTABLE FIRE EXTINGUISHERS AS PER FIRE CODE OF N.Y.S. (906) (1/A/1500 SQ.F / 75' TRAVEL DISTANCE)

NO OVERSIGHT, ERROR OR OMISSION ON THE PART OF THE BUILDING INSPECTOR OR HIS REPRESENTATIVE SHALL LEGALIZE THE ERECTING CONSTRUCTION, ALTERATION, REMOVAL, USE OR OCCUPANCY OF A BUILDING OR STRUCTURE THAT DOES NOT CONFORM TO THE PROVISIONS OF THE BUILDING CODE AND THE BUILDING ZONE ORDINANCE.
TOWN OF OYSTER BAY APPROVED PLAN
PERMIT # B-50000 DATE 5/13/04
PERMIT ISSUED CONDITIONALLY PENDING COMPLIANCE WITH COMMENTS NOTED IN RED.
MAY 11 2004

WALL LEGEND	
EXISTING WALLS	
EXISTING WALLS TO BE REMOVED	
NEW WALL CONSTRUCTION	
NEW EMERGENCY LIGHTING	
NEW EMERGENCY EXIT LIGHTING	

NOTE: ALL AREAS SHALL BE FIRE SPRINKLED IN ACCORDANCE WITH NFPA-13 AND THE NASSAU COUNTY FIRE MARSHAL

CONSTRUCTION CLASS: TYPE 2B
OCCUPANCY: FACTORY / WHOLESALE / RETAIL
BUILDING AREA: 22,075 Sq. Ft.

number	date	revision

date: APRIL 14, 2004
scale: AS NOTED
project no.: 24016
checked by:
drawn by:

NOTARO GRUPP ASSOCIATES
ARCHITECTS & PLANNERS
1005 GLEN COVE AVENUE
GLEN HEAD, NEW YORK 11545
(516) 609-8700 FAX (516) 609-2102

project name: FABRIC MILL
WHOLESALE RETAIL FABRICS
OYSTER BAY, NEW YORK

drawing title: FIRST FLOOR PLAN

drawing no. A-1
of

0973