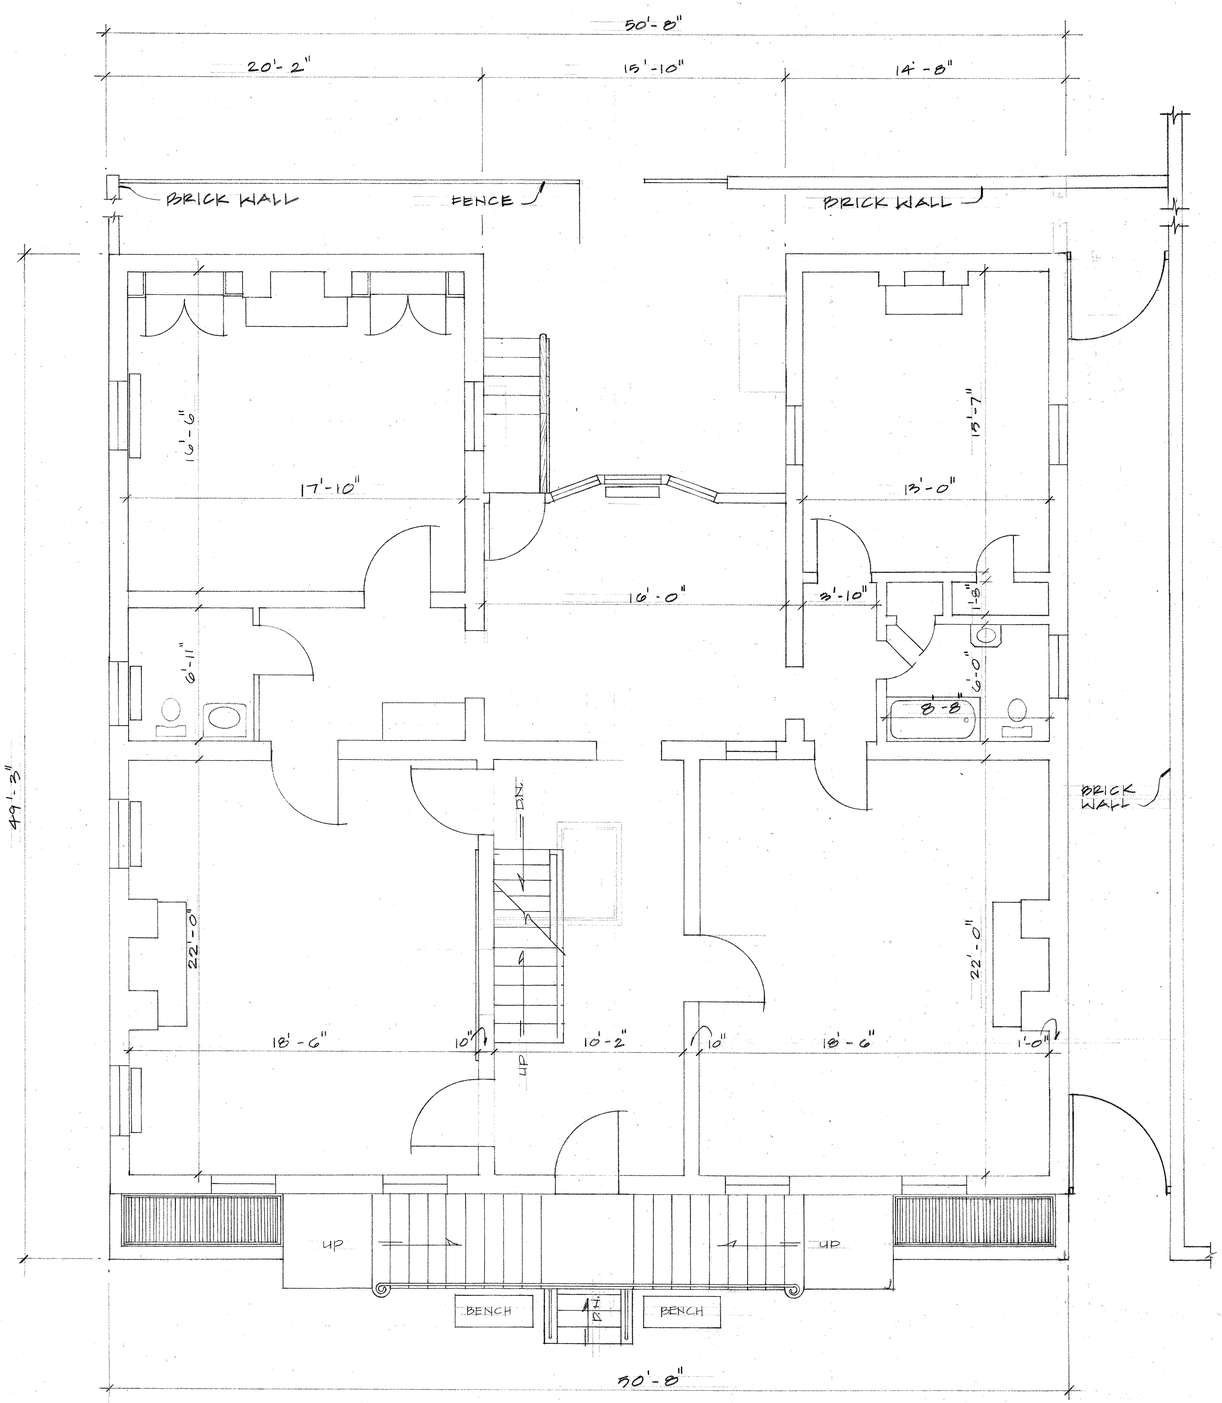

first floor/existing

SCALE: 1/4 = 1-0

as-built drawings

BAXTER BAILEY & ASSOCIATES
ARCHITECTS
THE CROZET HOUSE • 100 E. MAIN STREET • RICHMOND, VA 23219
(804) 343-1633 • FAX (804) 775-2389

OWNER:
V. CASSEL ADAMSON, JR.
6510 THREE CHOPT RD.
RICHMOND, VA 23233

THE CROZET HOUSE
100 E. MAIN ST.
RICHMOND, VIRGINIA 23219

DATE: DECEMBER 1997

3