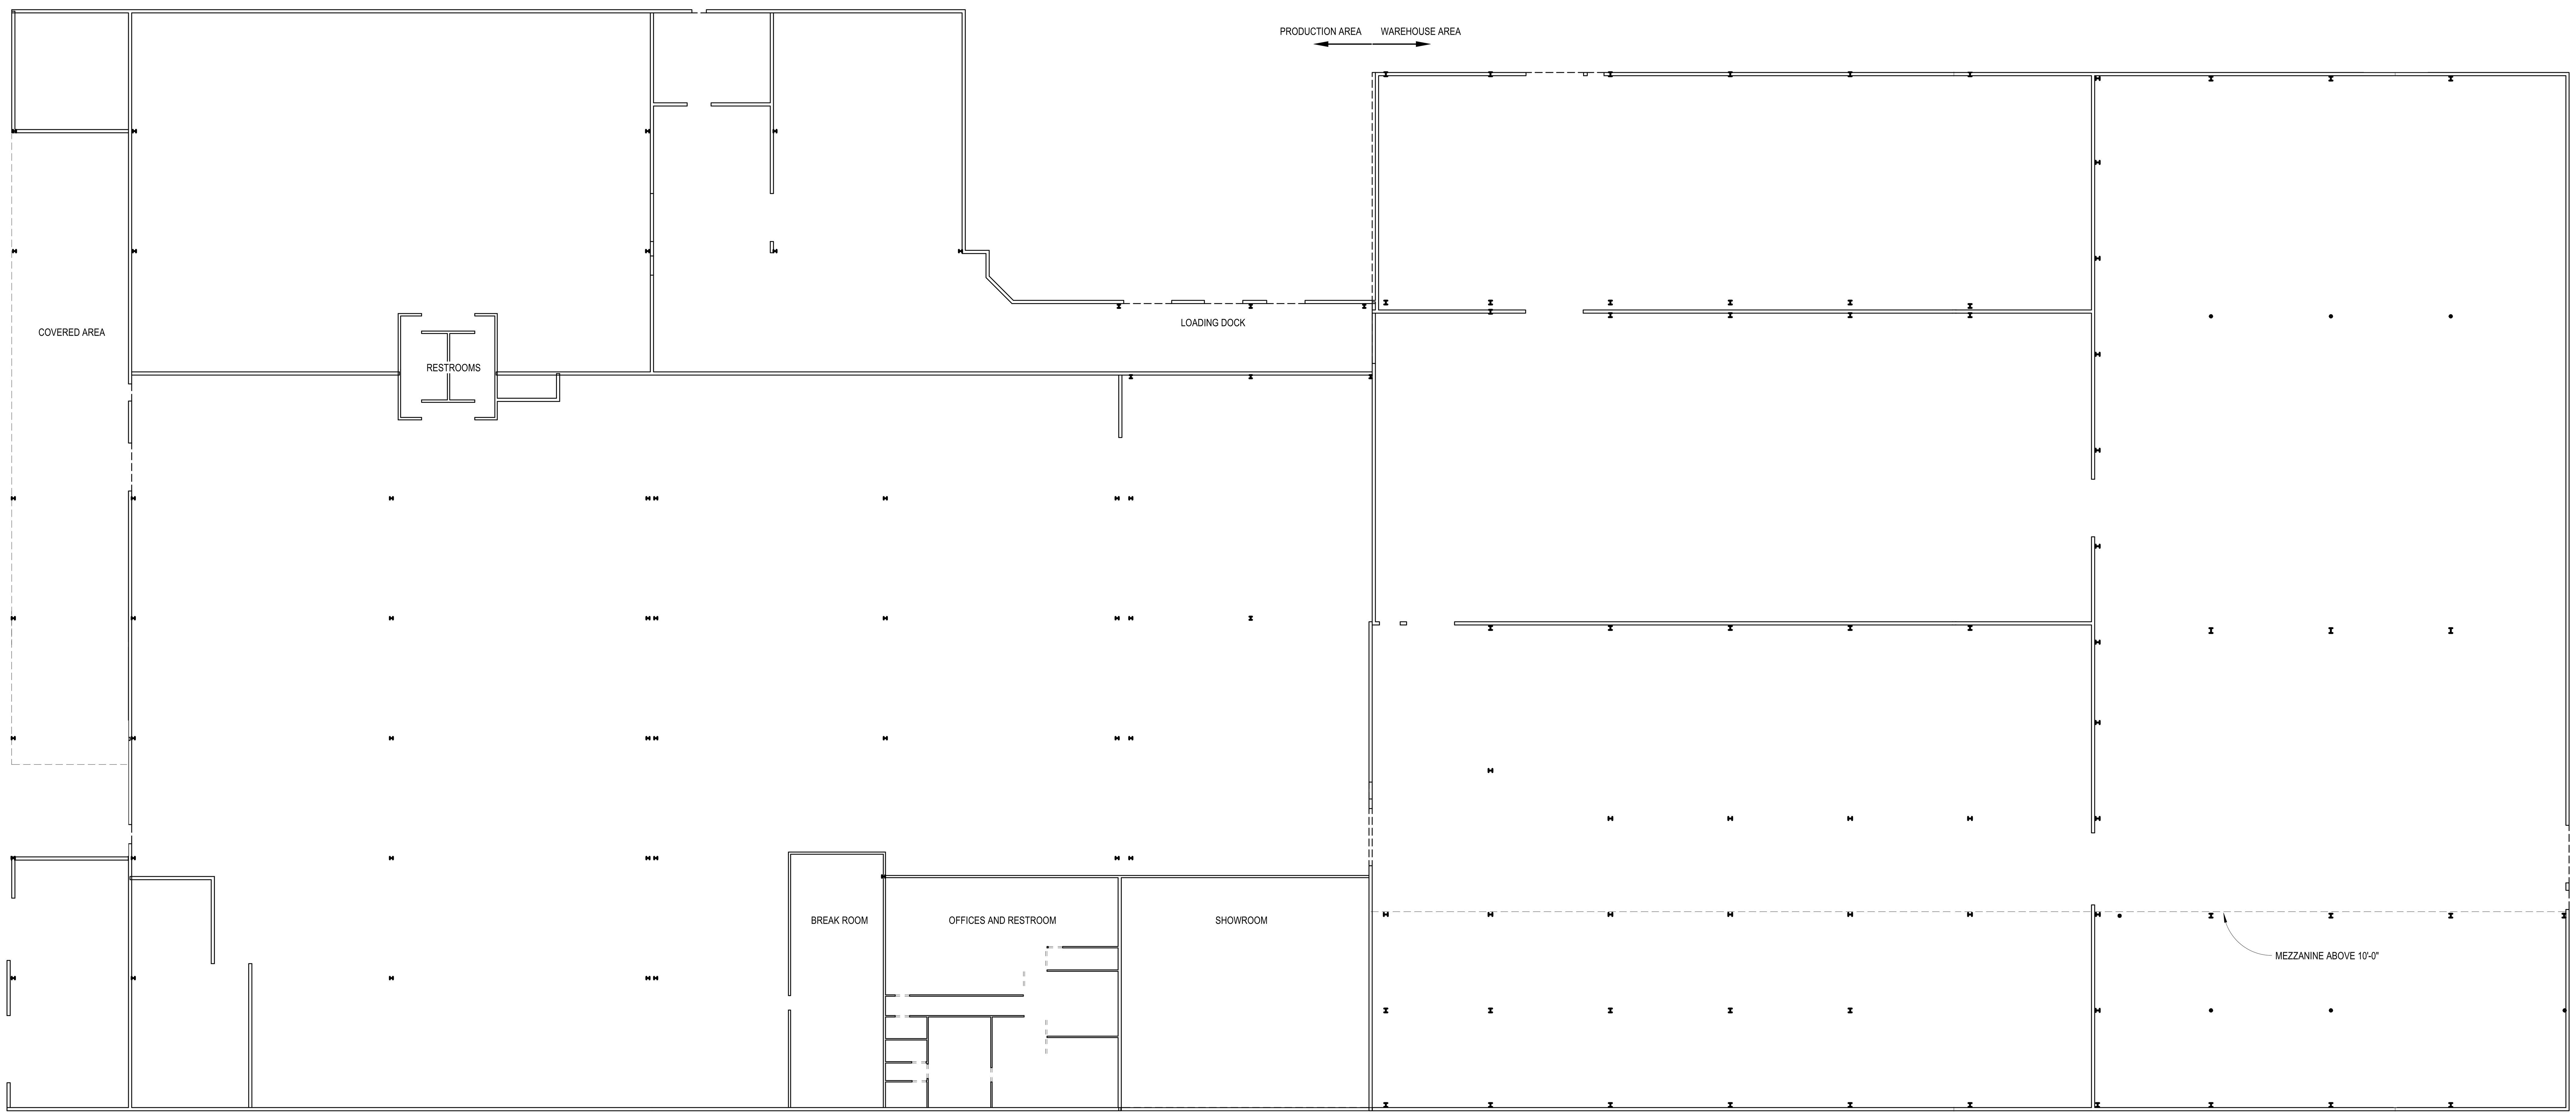

1 AS BUILT PLAN

1/16" = 1'-0"

8/19/2024 12:32:03 PM
X:\Shared\360 PLLC Public\Jobfiles\Melt\24XXX_G&H decoy\02_Dwgs\01_Rvt\G&H DECOYS_CONNOR_V24.rvt
360 Project No. 24XXX