


LIGHTING PLAN
1/8"=1'0"

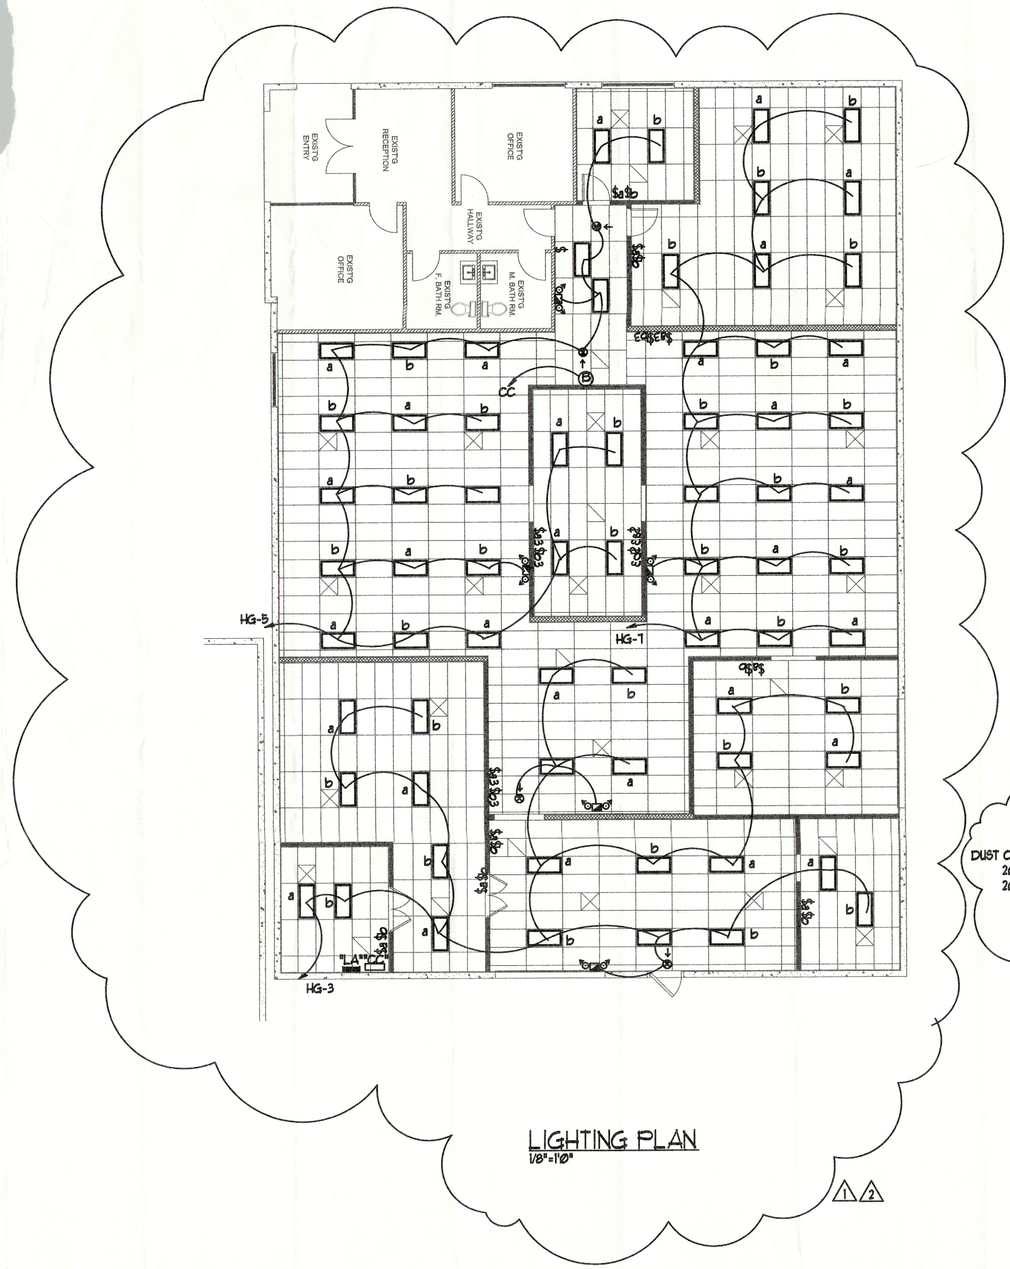


POWER PLAN
1/8"=1'0"

THESE DRAWINGS AND SPECIFICATIONS ARE THE PROPERTY AND COPYRIGHT OF SIERRA WEST ELECTRIC UNDER THE EXEMPTION TO DIVISION 3 OF THE BUSINESS AND PROFESSIONS CODE BY SECTION 5537.2 OF THE BUSINESS AND PROFESSIONS CODE AS THE PERSON RESPONSIBLE FOR ITS PREPARATION) AND THAT I AM A LICENSED CONTRACTOR PREPARING DOCUMENTS FOR WORK THAT I HAVE BEEN CONTRACTED TO PERFORM. THESE PLANS SHALL NOT BE USED BY ANY ONE OTHER THAN SIERRA WEST ELECTRIC. THESE PLANS REPRESENT A SCHEMATIC LAYOUT OF THE ELECTRIC SYSTEM.

Sierra West Electric
951-699-0071
FAX 951-699-0076
LIC. # 588512

LICENSED ELECTRICAL CONTRACTOR
JAMES D. GLOCKNER
C-10 588512
Exp. 10/31/06
STATE OF CALIFORNIA

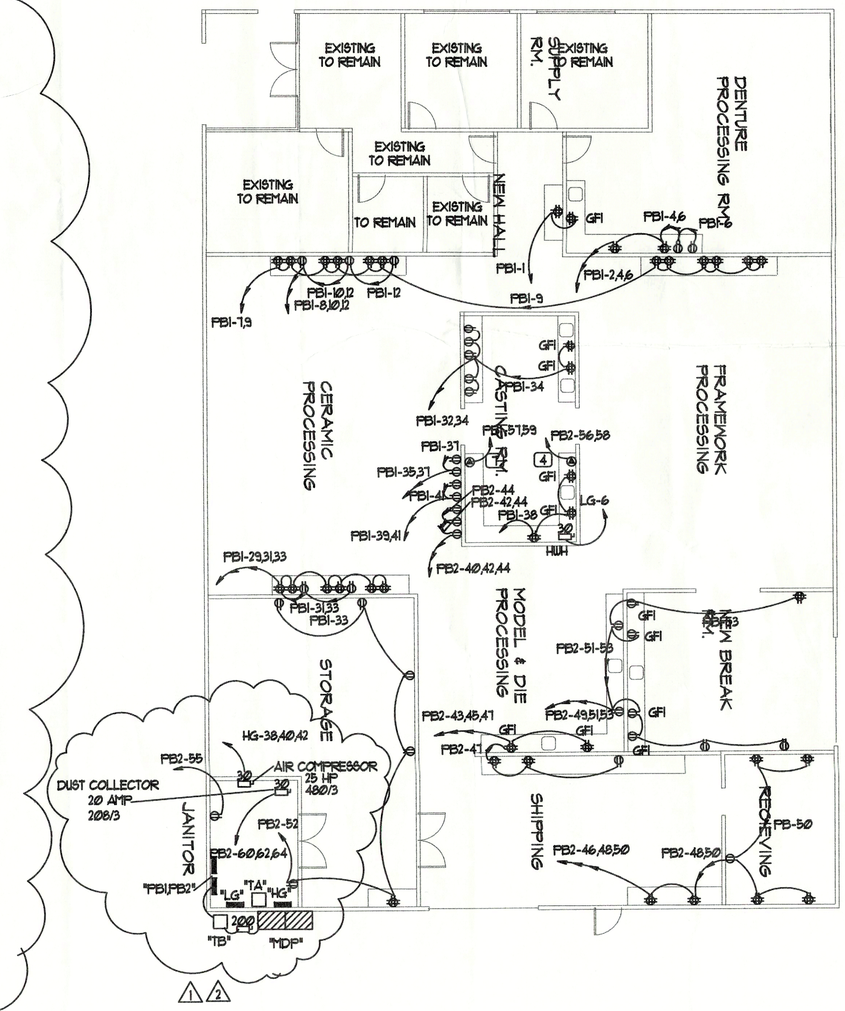KNOTT CONSULTING
25791 JEFFERSON AVE. BLDG. G
MURRIETA, CA.

REVISIONS:
1 7/12/05
OWNER CHANGES
2 9/20/05
PLAN CHECK

DATE:
12/7/04
SHEET NO:
E1.0