1 SEPTEMBER 2023

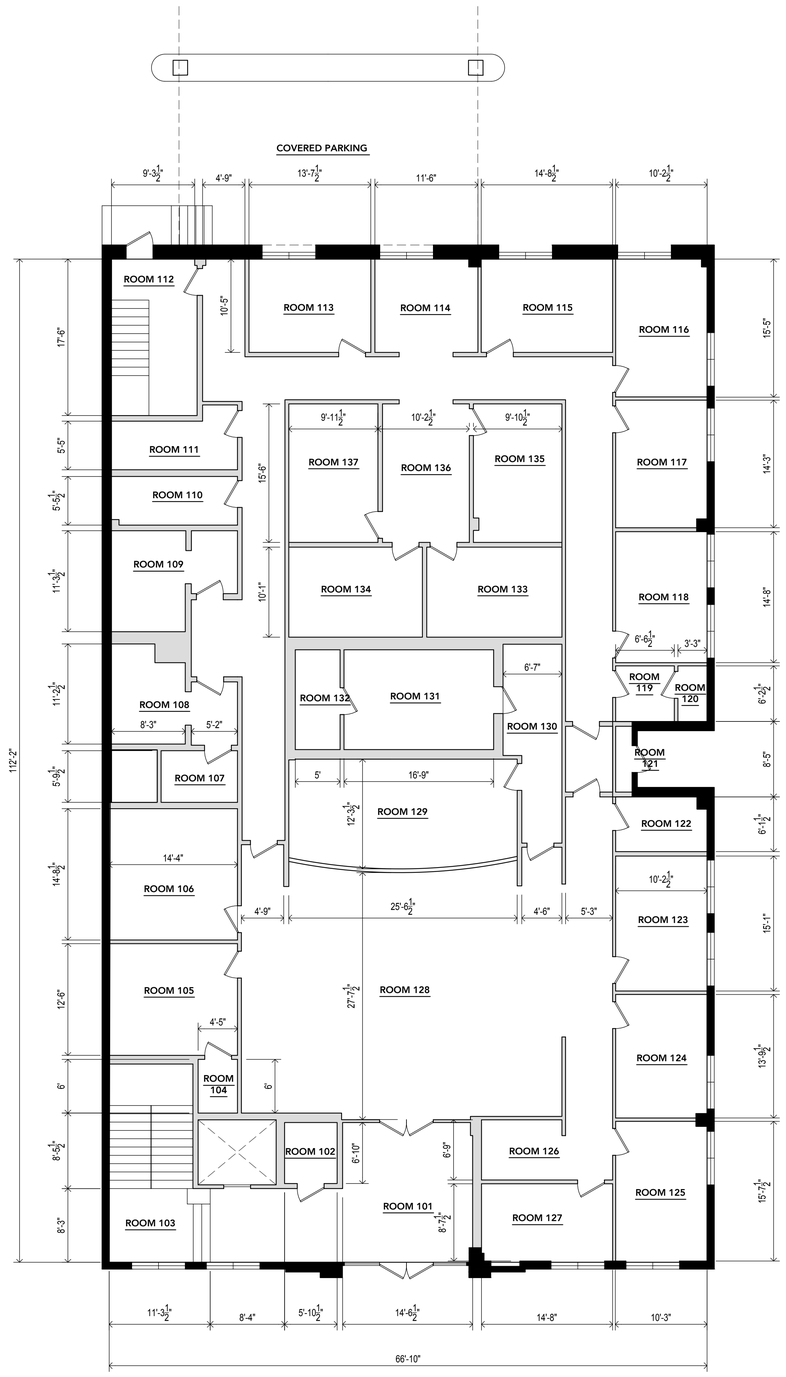

1 A-1.1 FIRST FLOOR PLAN

SCALE: 1/8"=1'-0"

FIRST FLOOR SQUARE FOOTAGE: 7,393 SF

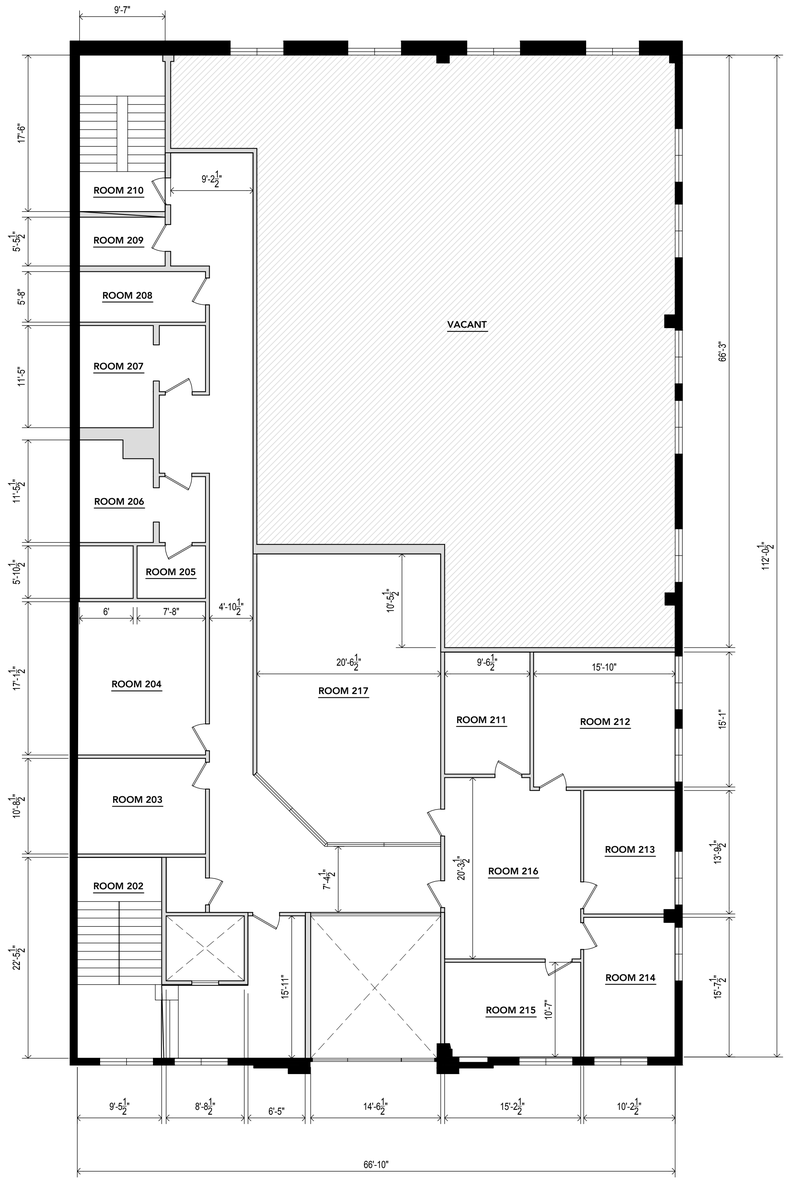

2 A-1.1 SECOND FLOOR PLAN

SCALE: 1/8"=1'-0"

SECOND FLOOR SQUARE FOOTAGE:
OCCUPIED: 3,733 SF
VACANT: 2,951 SF

ZION ARCHITECTS

220 Terrace Drive
Anderson, SC 29621
864.506.5546

REVISIONS

129 N. MAIN STREET

AS-BUILT FLOOR PLANS

121 N. MAIN ST., ANDERSON, SC 29625

PROJECT: Z23-23

SCALE: 1/8"=1'-0"

DRAWN BY: WAZ3

FIRST FLOOR PLAN

A-1.1