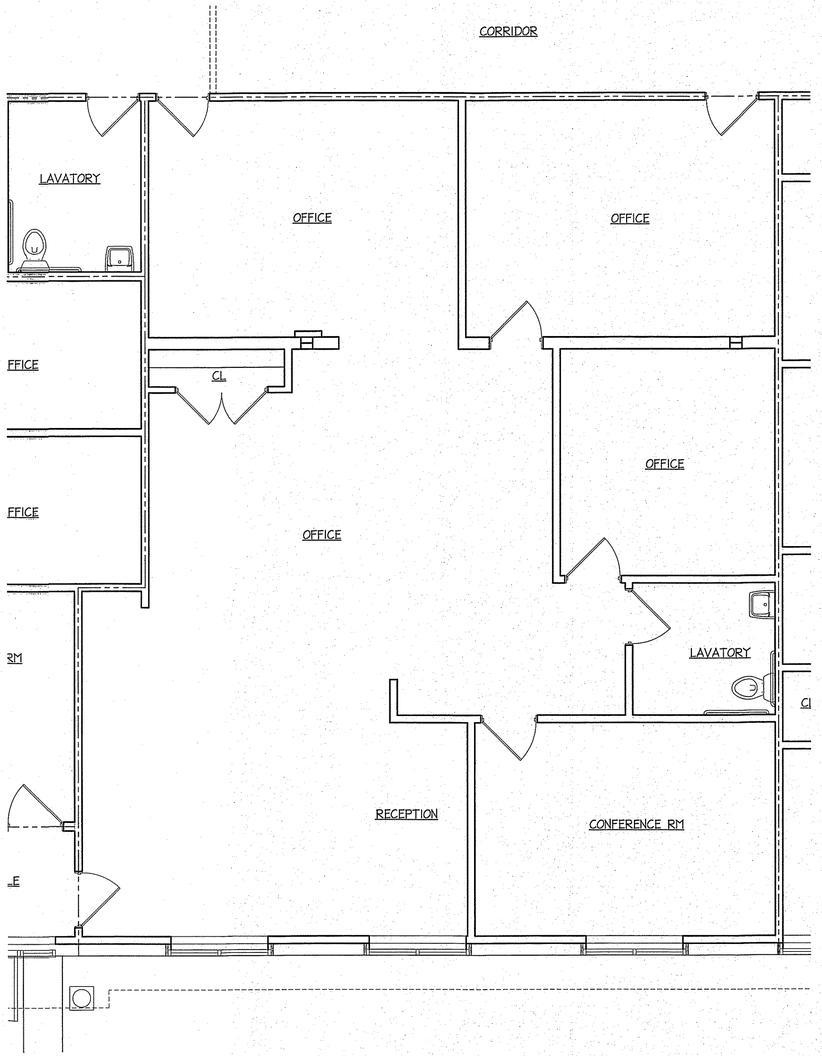

1/A-3 EXISTING SUITE 1-B Scale 1/4" = 1'-0"

RSA
RICHARD SEARLES ARCHITECT, P.C.
ARCHITECTURE PLANNING
P.O.Box 286
WADING RIVER NEW YORK 11792
PHONE (631) 744-2852 FAX (631) 744-6654
E-mail: rsearles@rs-architect.net

As-Built For:

Hallock Road Office Building

215 Hallock Road
Stony Brook, New York

REVISIONS

SEAL

Copyright 2022. Richard Searles Architect, P.C. All rights reserved. The Architect reserves the right to reproduce this design in its entirety or any portion thereof. Unauthorized alteration of these documents is a violation of the New York State Education Law. These drawings and specifications are an instrument of service and are the property of the Architect. These drawings and specifications are not to be used on any other project, except by written permission of the Architect.

PROJECT NO.	2020-28		
SCALE	AS SHOWN	DATE	10/03/22
DRAWN BY	DWM/RS	CHECKED BY	RS

TITLE

Existing Suite 1-B

SHEET

A-3