Adjacent Property

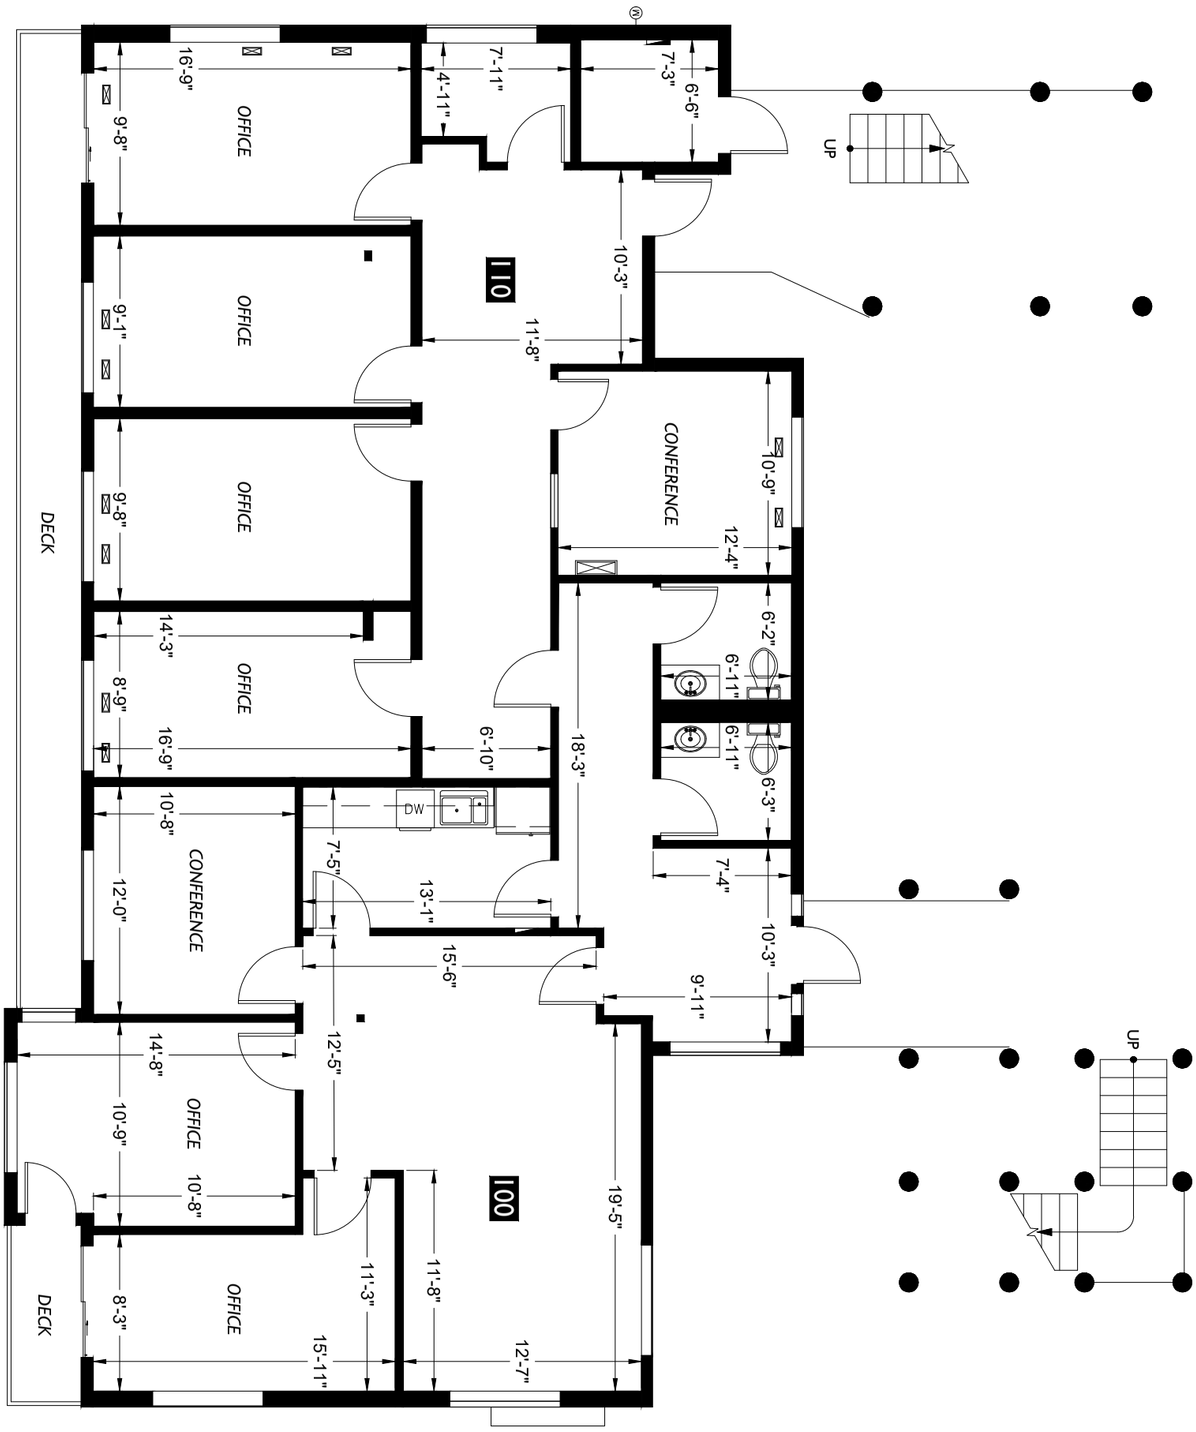

200th Street Southwest

Coast Property Management 2829 Rucker Avenue Everett, WA 98201	Office Building 5105 200th Street Southwest Lynnwood, WA 98036	**Floor Plan** I	1/8"=1' 0 5 10	2-D AS-BUILT FLOOR PLANS	2DFLOORPLANS.COM 425-677-7511 600 NW Gilman Blvd. Suite E Issaquah, WA 98027
Client	**Subject**	**Floor**	**Scale**	**Measured:** July 2019	**Project:** C19-639